

8596-71-4342-000


TRANSYLVANIA COUNTY HEALTH DEPARTMENT

(Sewage disposal system) Improvements Permit and Certificate of Completion


(Ground Absorption Sewage Disposal System - Section 130 - 160 of Chapter 130 of the General Statutes of North Carolina)

OWNER-OCCUPANT Bob Colwell BUILDING CONTRACTOR self
LOCATION New rd below condoo 9 mil de sac
SUBDIVISION Glen Cannon LOT NO. _____ SECT. OR BLOCK NO. _____
SEPTIC TANK CONTRACTOR Harold Buck ADDRESS Brevard, N.C.

HOUSE MOBILE HOME BUSINESS
NO. BEDROOMS 3 NO. BATHROOMS 2
SIZE OF SEPTIC TANK 860 GALS. (Liquid) _____
MATERIAL: PRE-CAST BLOCK FIBERGLASS
DISTRIBUTION BOX YES NO
NO. OF LINES 3 WIDTH 3 FT. LENGTH 11 FT.
PERCOLATION TEST 3 YES NO 70
WATER SUPPLY: INDIVIDUAL PUBLIC
SITE CLASSIFICATION: SUITABLE
PROV. SUITABLE
UNSUITABLE

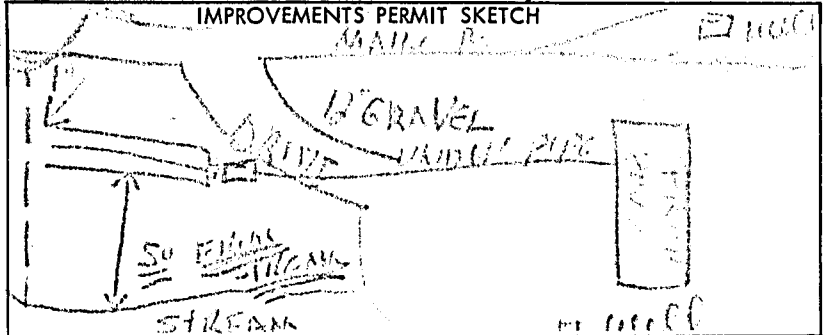

IMPROVEMENTS PERMIT DATE: 8-25-80
BY Harold Buck
CERTIFICATE OF COMPLETION DATE: 9-4-80
BY Harold Buck

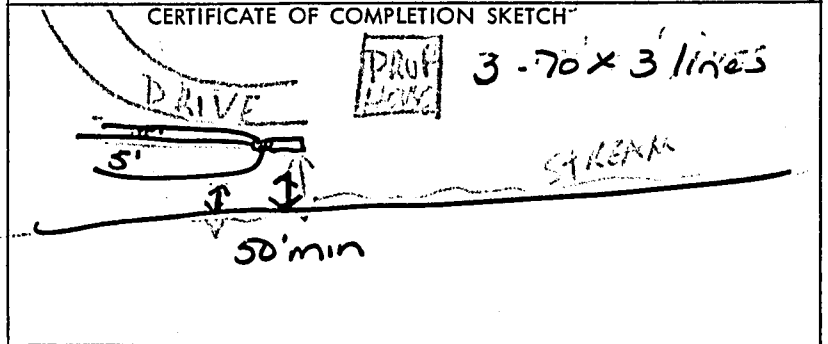

NOTICE: System Installed according to Rules and Regulations but not a guarantee that it will function satisfactorily for any given period of time.

COLOR CODE: White - Owner; Pink - Improvements Permit; Blue - Contractor; Yellow - Inspection Dept.; Green - Health Dept.