

Receipt No _____
 Pin #/Tax ID _____
 0504-42-2470-000

Flood Zone Is the property in a flood zone? <input type="checkbox"/> Yes <input type="checkbox"/> No <input type="checkbox"/> Unknown	
Inspections <input type="checkbox"/> Flood Zone <input type="checkbox"/> Yes <input type="checkbox"/> No <input type="checkbox"/> Approved <input type="checkbox"/> Disapproved Initials _____ Date _____	

Mailing Address: Steve Armandis
662-4530
 Work Phone #: () () ()
 Mailing Address: _____
 Work Phone #: () () ()
 Phase/Sect.: _____ Lot #: 168

System Classification Type: IIg Management Entity: Owner Certified Operator Minimum inspection/maintenance review frequency _____ years.
 Comments: EZ Flow installation
 Installed by: Sammy Gallovey Final Inspection by: Steve R. Ryan RS Date: 7.20.07

TC 1000
Stb 192


EZ Flow
drainfield

both trenches
at same
grade

7.20.07
EZ

15' 19"
Project
in
Pool

LAKE

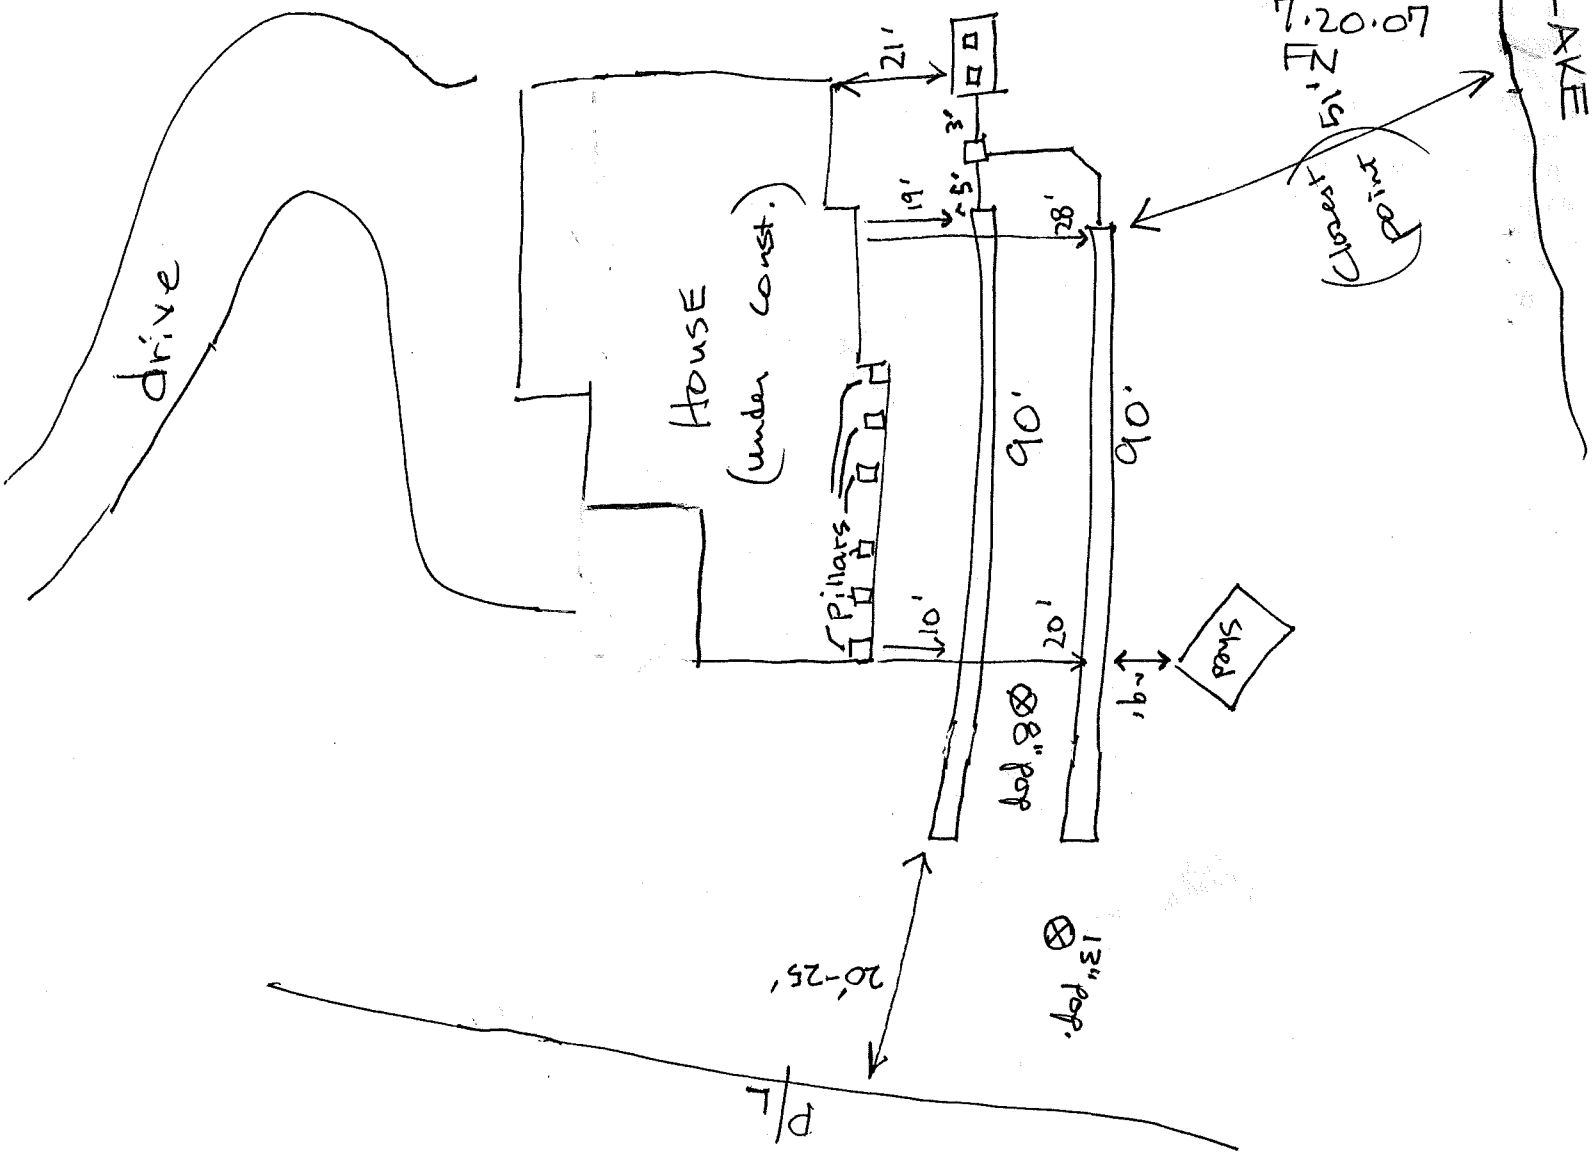


File Name: Faye Walker/Eagle Lake Lot 168

PIN: 8594-43-5470-000

Scale: 1" = 40'

Permit No.: 07-151

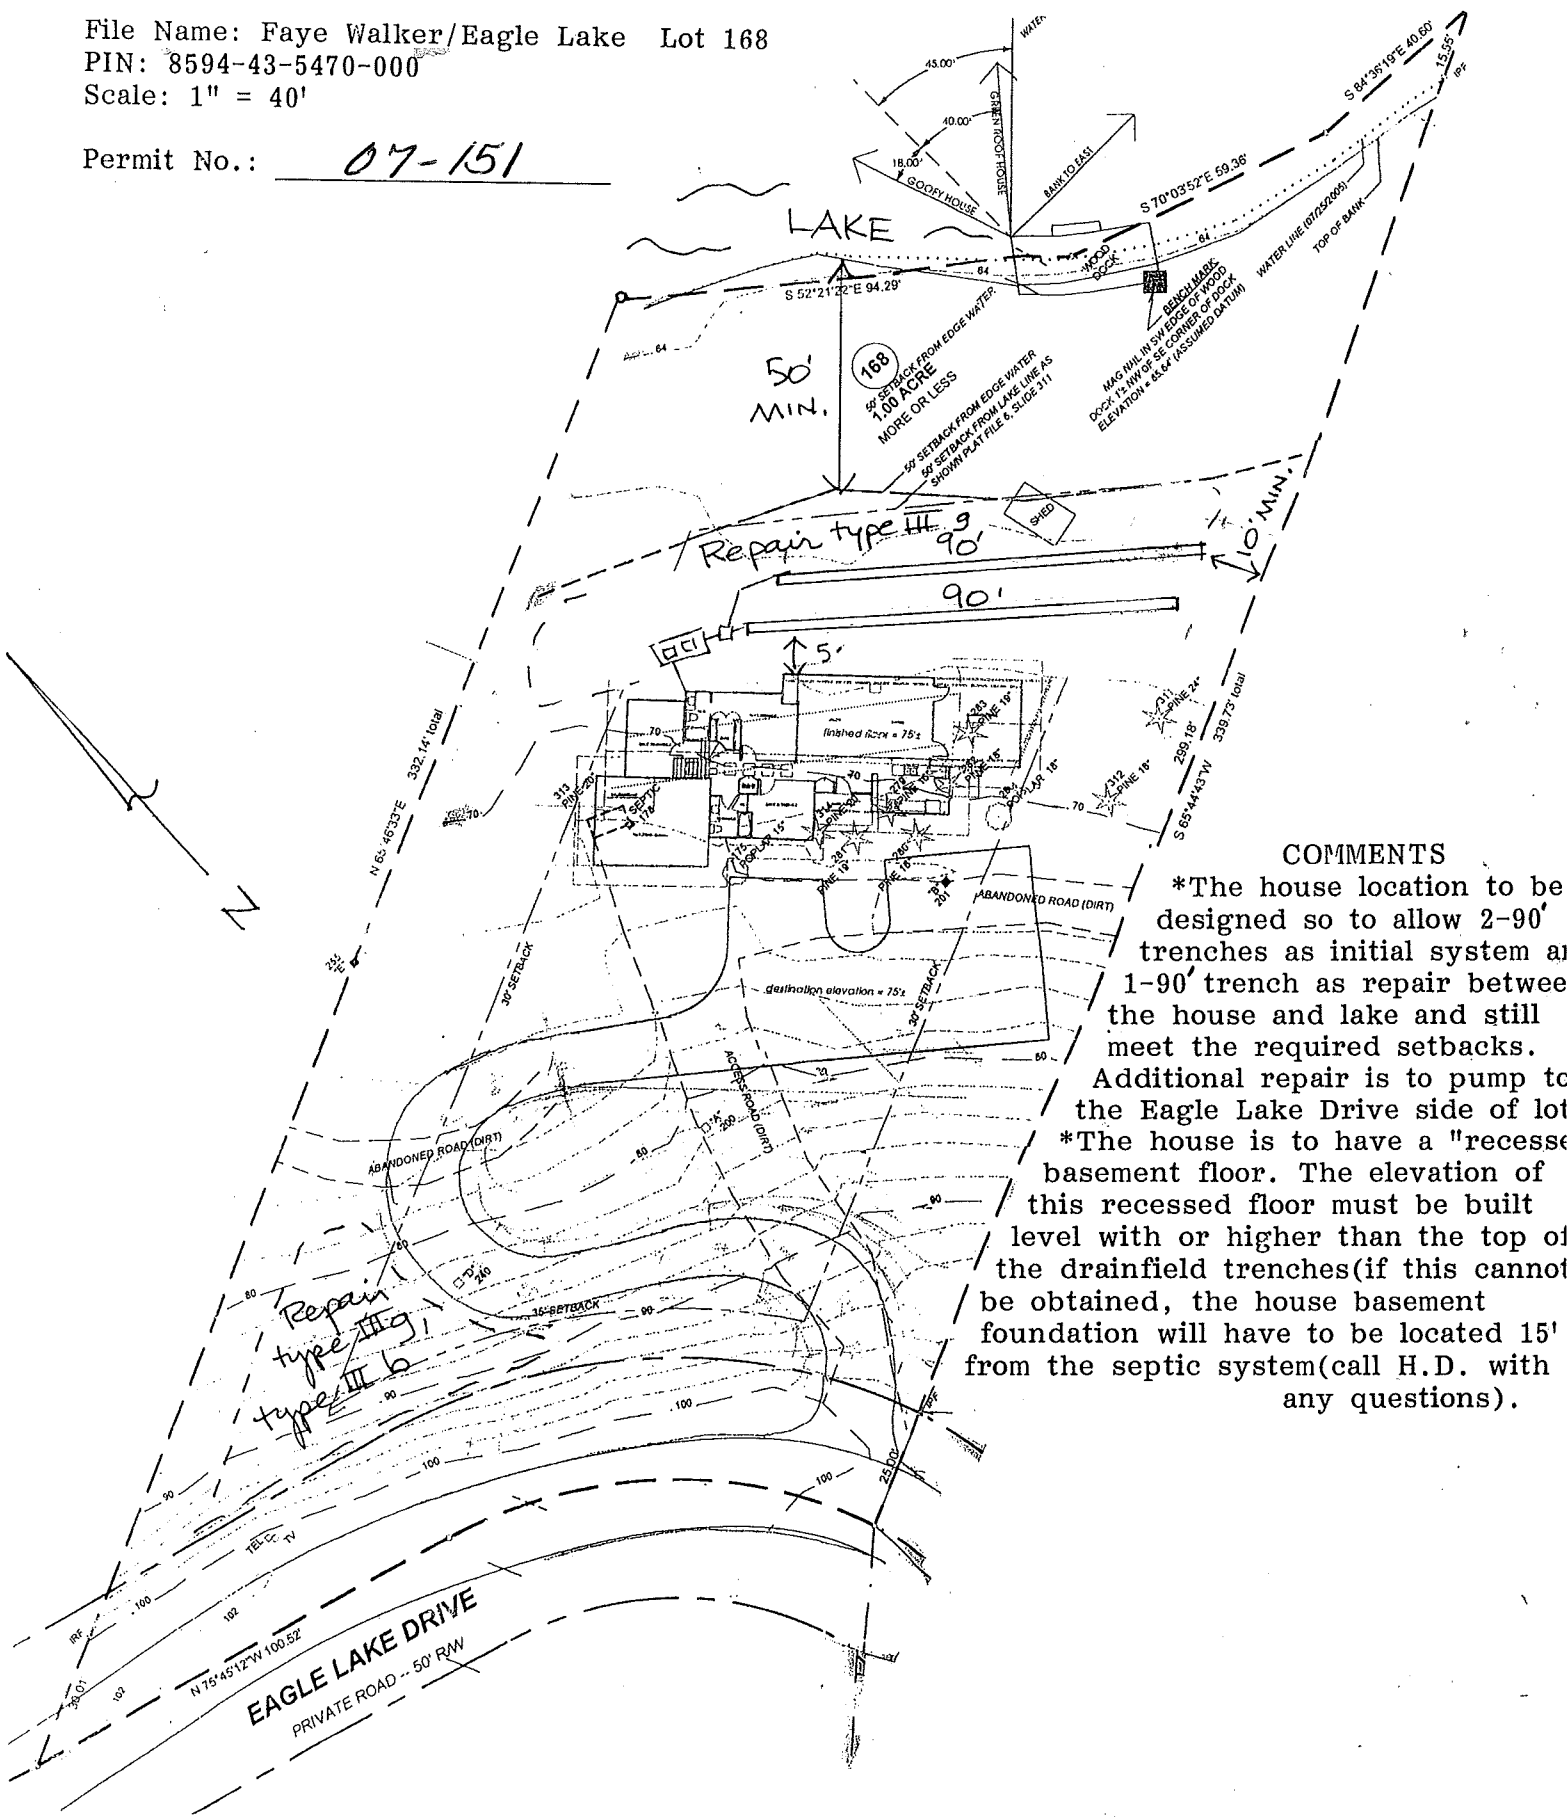

COMMENTS

- *The house location to be designed so to allow 2-90' trenches as initial system at 1-90' trench as repair between the house and lake and still meet the required setbacks. Additional repair is to pump to the Eagle Lake Drive side of lot
- *The house is to have a "recessed" basement floor. The elevation of this recessed floor must be built level with or higher than the top of the drainfield trenches (if this cannot be obtained, the house basement foundation will have to be located 15' from the septic system (call H.D. with any questions).