

PIN: 8576-91-3537-000

File Name: BATHNAN, FRED IV

Permit No.:

09-236

TRANSYLVANIA COUNTY DEPARTMENT OF PUBLIC HEALTH

Operation Permit

System Type:

II

Proprietary Name:

EZ Flow (25%)

Bahnson, Fred

Owner's Name

Jerry Henderson

System Installer

and

2231

Certification Number

James A Boyer, REHS

Authorized State Agent

12/15/09

Date of Operation Permit Issuance

This system has been installed in compliance with applicable NC General Statutes, Rules for Sewage Treatment and Disposal and all conditions of the Improvement Permit and Construction Authorization

Septic Tank Manufacturer:

Kingsway

STB-

K-1000


Date of Manufacture:

8/31/09

Filter Brand:

Tuff Tite EF-40

STB-141

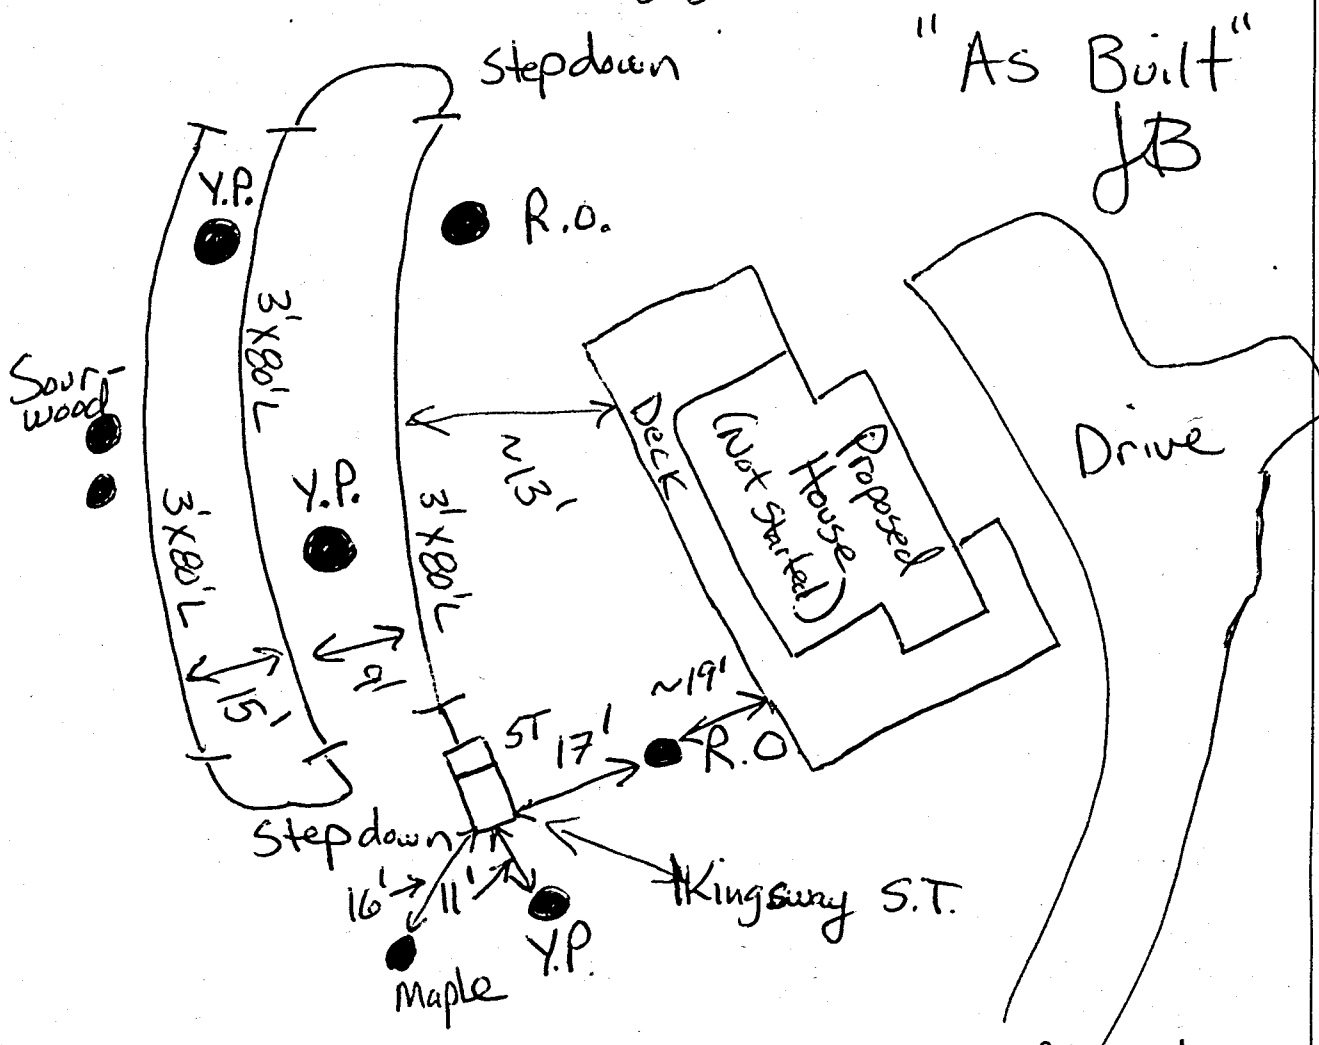

Conditions/Comments:

Clean & replace septic tank effluent filter as req'd

Subsurface system operator required? No ☒ Yes ☐

If yes, see attached sheet for additional operation conditions, maintenance and reporting.

The septic tank should have all compartments pumped out every 3-5 years, on average, or when the solids are more than 1/3 of the liquid depth in any compartment. Depending upon trench depth, maximum fill over the drainfield cannot exceed two feet. Establish cover over drainfield and divert surface waters to prevent erosion or degradation of the system. No part of the septic system should be subjected to: traffic or any other compaction; vegetation with aggressive and/or hydrophilic (water loving) root systems such as maples or willows; excessive fill or heavy landscaping materials such as rocks/boulders; or any other activities or circumstances that may alter site conditions and may cause problems with the initial system or the repair area as permitted.

TRANSYLVANIA COUNTY DEPARTMENT OF PUBLIC HEALTH IMPROVEMENT PERMIT DIAGRAM

File Name: RAHNSON, FRED Permit No.: 09-236 PIN: 8576-91-3537-000
PROBART ST

