

GLEN CANNON (NIX, TOMMY)

PAISLEY PLACE - LOT 20

Transylvania County Health Department
IMPROVEMENTS PERMIT / CERTIFICATE OF COMPLETION
Subsurface Sanitary Sewage Systems

(Article 11 of Chapter 130A of the General Statutes of North Carolina)

IMPROVEMENT PERMIT IS VALID FIVE (5) YEARS FROM DATE OF ISSUANCE PP

9505-09-7459-000

Tax ID. No.: XT47200002

Date: April 25, 1995

Owner/Agent: Fisher Realty

Receipt No.: #U432

Phone No.: 883-9895

Address: 232 S. Caldwell Street Brevard, N.C. 28712

Location of Property: Glen Canon take 1-st-r R. on First Campbell Drive R. on First Aberdeen R. onto Sky Drive R. on Paisley Place.

Subdivision: Glen Canon Lot Number: 20-21 Section: 9/2014 Plat of Property: yes

Type of Facility: House Mobile Home Business Other Basement DAYLIGHT No Basement Plumbing Yes No

Number of Bedrooms: 3 Number of Bathrooms: 2 Estimated Sewage Flow: 360

Lot Size: 2.11 Acres Easements, Right-of-Ways, etc.: paved Date Lot Recorded: 1991

Type of Water Supply: Private: Drilled Well Spring Shared Supply Public/Community

Signature/Authorized Agent: [Signature] Date: 4/26/95

See attached drawing
d comments
Homeowner (Tommy Nix) requests
using IWS - 3R (polystyrene
aggregate) as chainfield. 2-80'
trenches can be installed.
[Signature]
Improvements Permit Sketch

Certificate of Completion Sketch

Nitrification trenches shall be installed on level grade with contour. Stepdowns permitted only when indicated.

New System Repair Addition

Size of Tank: 1000 Application Rate: .6

No. of Lines: 3 Width: 3' Linear Ft.: 70'

Square Ft.: 630 Maximum Trench Depth: 18" low side

I understand and agree to install the septic tank system as specified on this Improvements Permit. Permit is void if any changes are made without consent of the Health Department Representative and/or if any false information is supplied in making Improvements Permit.

[Signature] 5.12.95
Signature/Authorized Agent Date

[Signature] RS 5.7.95
By Date

[Signature] 5.11.95
By Date

Building Contractor:

System Installed by: Norton Services

This is to certify that system is installed according to Rules and Regulations but is not a guarantee that it will function satisfactorily for any given period of time.

[Signature] RS 10.18.99
By Date

EXISTING SYSTEM: Addition/Remodeling Relocation

Other

System functioning properly at time of inspection and is approved for proposed additions/renovations or other improvements.

By _____ Date _____

TRANSYLVANIA COUNTY HEALTH DEPARTMENT IMPROVEMENT PERMIT DIAGRAM

Date: 5.7.95

Tax ID No: 747200002

Owner/ Agent: Fisher Realty

Receipt No: 4432


Address: See permit

Phone No: 883 9895

Location of Property: " " "

Subdivision: Glen Cannon Lot No: 20 Section: _____ Plat of Property: _____

All parts of the septic tank system shall be located at least 100', or the maximum feasible distance from any well, but in no case less than 50 feet.

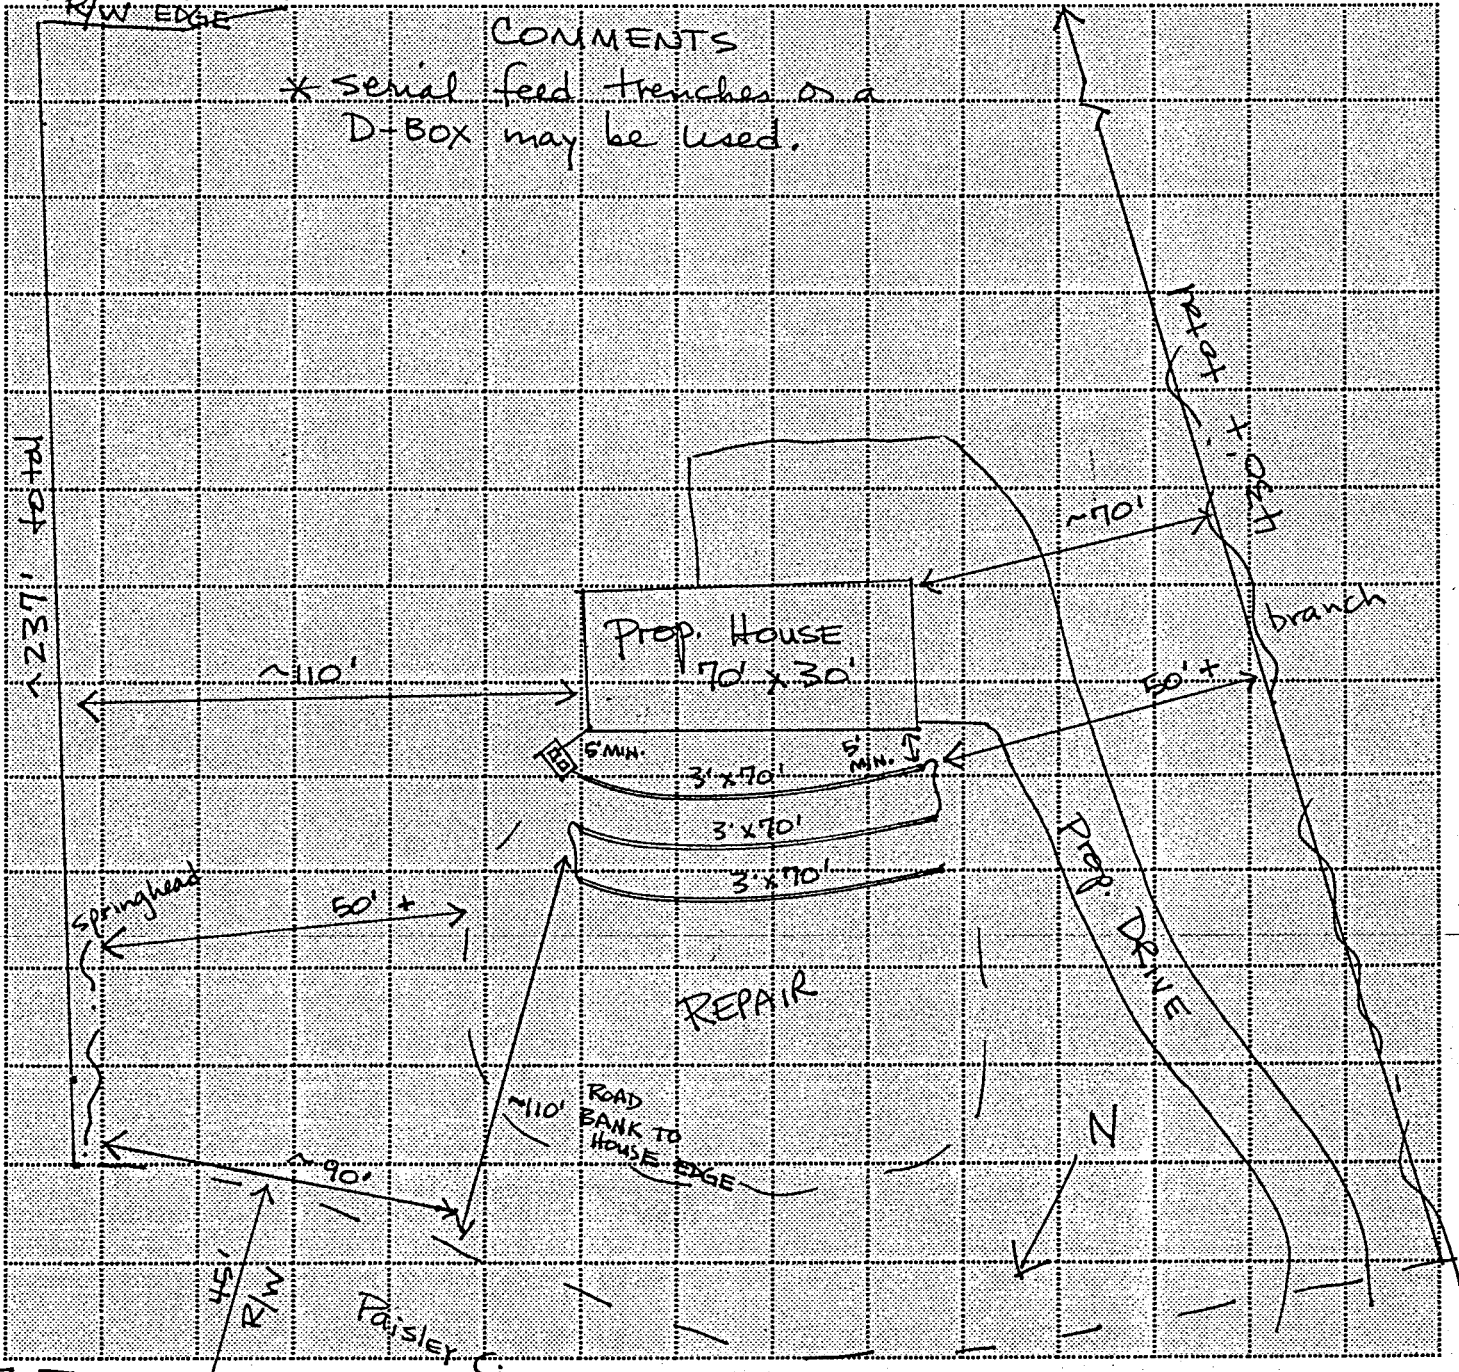

Minimum distance between trenches shall be 9 feet, on center.

Scale 1" : 40 feet

Keep trenches level, on contour, and shallow (maximum depth 18" on the low side of trench). Trench width is 36 inches.

AS
Bwill
JM

10.18.99

