

TRANSYLVANIA COUNTY HEALTH DEPARTMENT

Sewage Disposal System Improvements Permit and Certificate of Completion Sewage Treatment and Disposal Rules (Article 11 of Chapter 130A of the General Statutes of North Carolina)

Date: 4-2-90 Receipt No.: 1042
 Owner/Agent: Nell Woodroffe Phone No.: 877-3671
 Address: P. O. Box 308 Penrose, N.C.
 Location of Property: Little River - turn off onto Paradise Road - 1st left turn (dirt road)
go xxxxxx around curve - on right

Subdivision: _____ Lot Number: _____ Section: _____ Plat of Property: Yes No



Type of Facility: House Mobile Home Business Basement Yes No Basement Plumbing Yes No

Number of Bedrooms: 3 Number of Bathrooms: 2 1/2 Estimated Sewage Flow: 360

Lot Size: 1.02 acres Easements, Right-of-Ways, etc.: no Date Lot Recorded: _____

Type of Water Supply: Individual—Drilled Well Spring ; Public/Community

Signature/Authorized Agent: Nell W. Woodroffe Date: 4/2/90

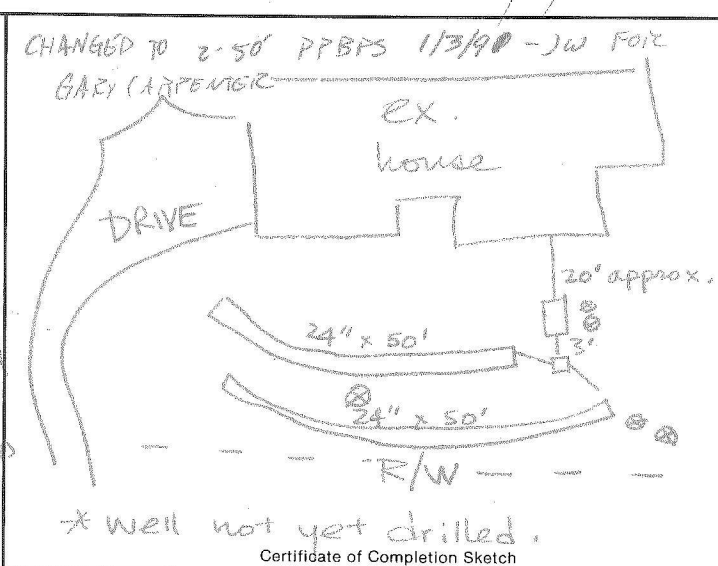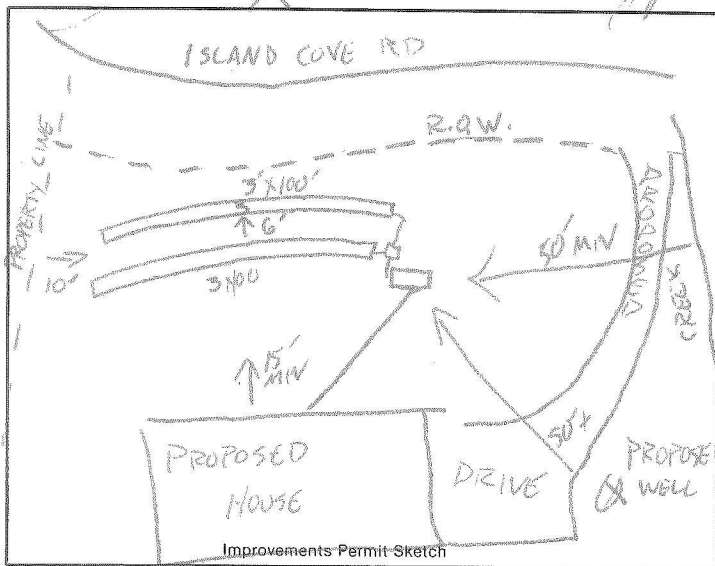

Nitrification trenches shall be installed on level grade with contour. Stepdowns permitted only when indicated.

New System Repair Addition

Size of Tank: 1000 Application Rate: 0.6 g/A²/d

No. of Lines: 2 Width: 3 Linear Ft.: 100

Square Ft.: 600 Maximum Trench Depth: 24"

I understand and agree to install the septic tank system as specified on this Improvements Permit. Permit is void if any changes are made without consent of the Health Department Representative and/or if any false information is supplied in making Improvements Permit.

Signature/Authorized Agent: James R. Woodroffe Date: 4/3/90

By: John Winston R.S. Date: _____

Building Contractor: Gary Carpenter

System Installed by: Ron Hubbard

This is to certify that system is installed according to Rules and Regulations but is not a guarantee that it will function satisfactorily for any given period of time.

By: James R. Woodroffe, RS Date: 4/10/90

PPBPS (PANEL) SYSTEM.

EXISTING SYSTEM: Addition/Remodeling Relocation

System functioning properly at time of inspection and is approved for proposed additions/renovations.

By: _____ Date: _____

SYSTEM NOT TO CROSS ROAD RIGHT OF WAY