

PIN: 9516-75-2148-000      Hamilton, Aaron (Oscar)  
File Name: 206 Cliff Road      Permit No.: 20-113

**TRANSYLVANIA COUNTY DEPARTMENT OF PUBLIC HEALTH**

**Operation Permit**  
New ☒ Repair \_\_\_\_\_ Addition/Expansion \_\_\_\_\_  
No. of Bdrms: 3      System Type: II      Proprietary Name: EZ Flow GEO  
Hamilton, Aaron (Oscar)      Theron McCall      # 1808  
Owner's Name      System Installer      and      Certification Number  
*James A Bayer*      7/1/2020  
Authorized State Agent      Date of Operation Permit Issuance

This system has been installed in compliance with applicable NC General Statutes, Rules for Sewage Treatment and Disposal and all conditions of the Improvement Permit and Construction Authorization


Septic Tank Manufacturer: Infiltrator 1060-IM      STB- 2071      Date of Manufacture: N/A  
Filter Brand: Polylok PL-68

See "as built" drawing for system location and measurements.

Conditions/Comments: Clean and replace septic tank effluent filter as required.

Subsurface system operator required? No ☒ Yes \_\_\_\_\_ If yes, see attached sheet for additional operation conditions, maintenance and reporting.

The septic tank should have all compartments pumped out every 3-5 years, on average, or when the solids are more than 1/3 of the liquid depth in any compartment. Depending upon trench depth, maximum fill over the drainfield cannot exceed two feet. Establish cover over drainfield and divert surface waters to prevent erosion or degradation of the system. No part of the septic system should be subjected to: traffic or any other compaction; vegetation with aggressive and/or hydrophilic (water loving) root systems such as maples or willows; excessive fill or heavy landscaping materials such as rocks/boulders; or any other activities or circumstances that may alter site conditions and may cause problems with the initial system or the repair area as permitted.

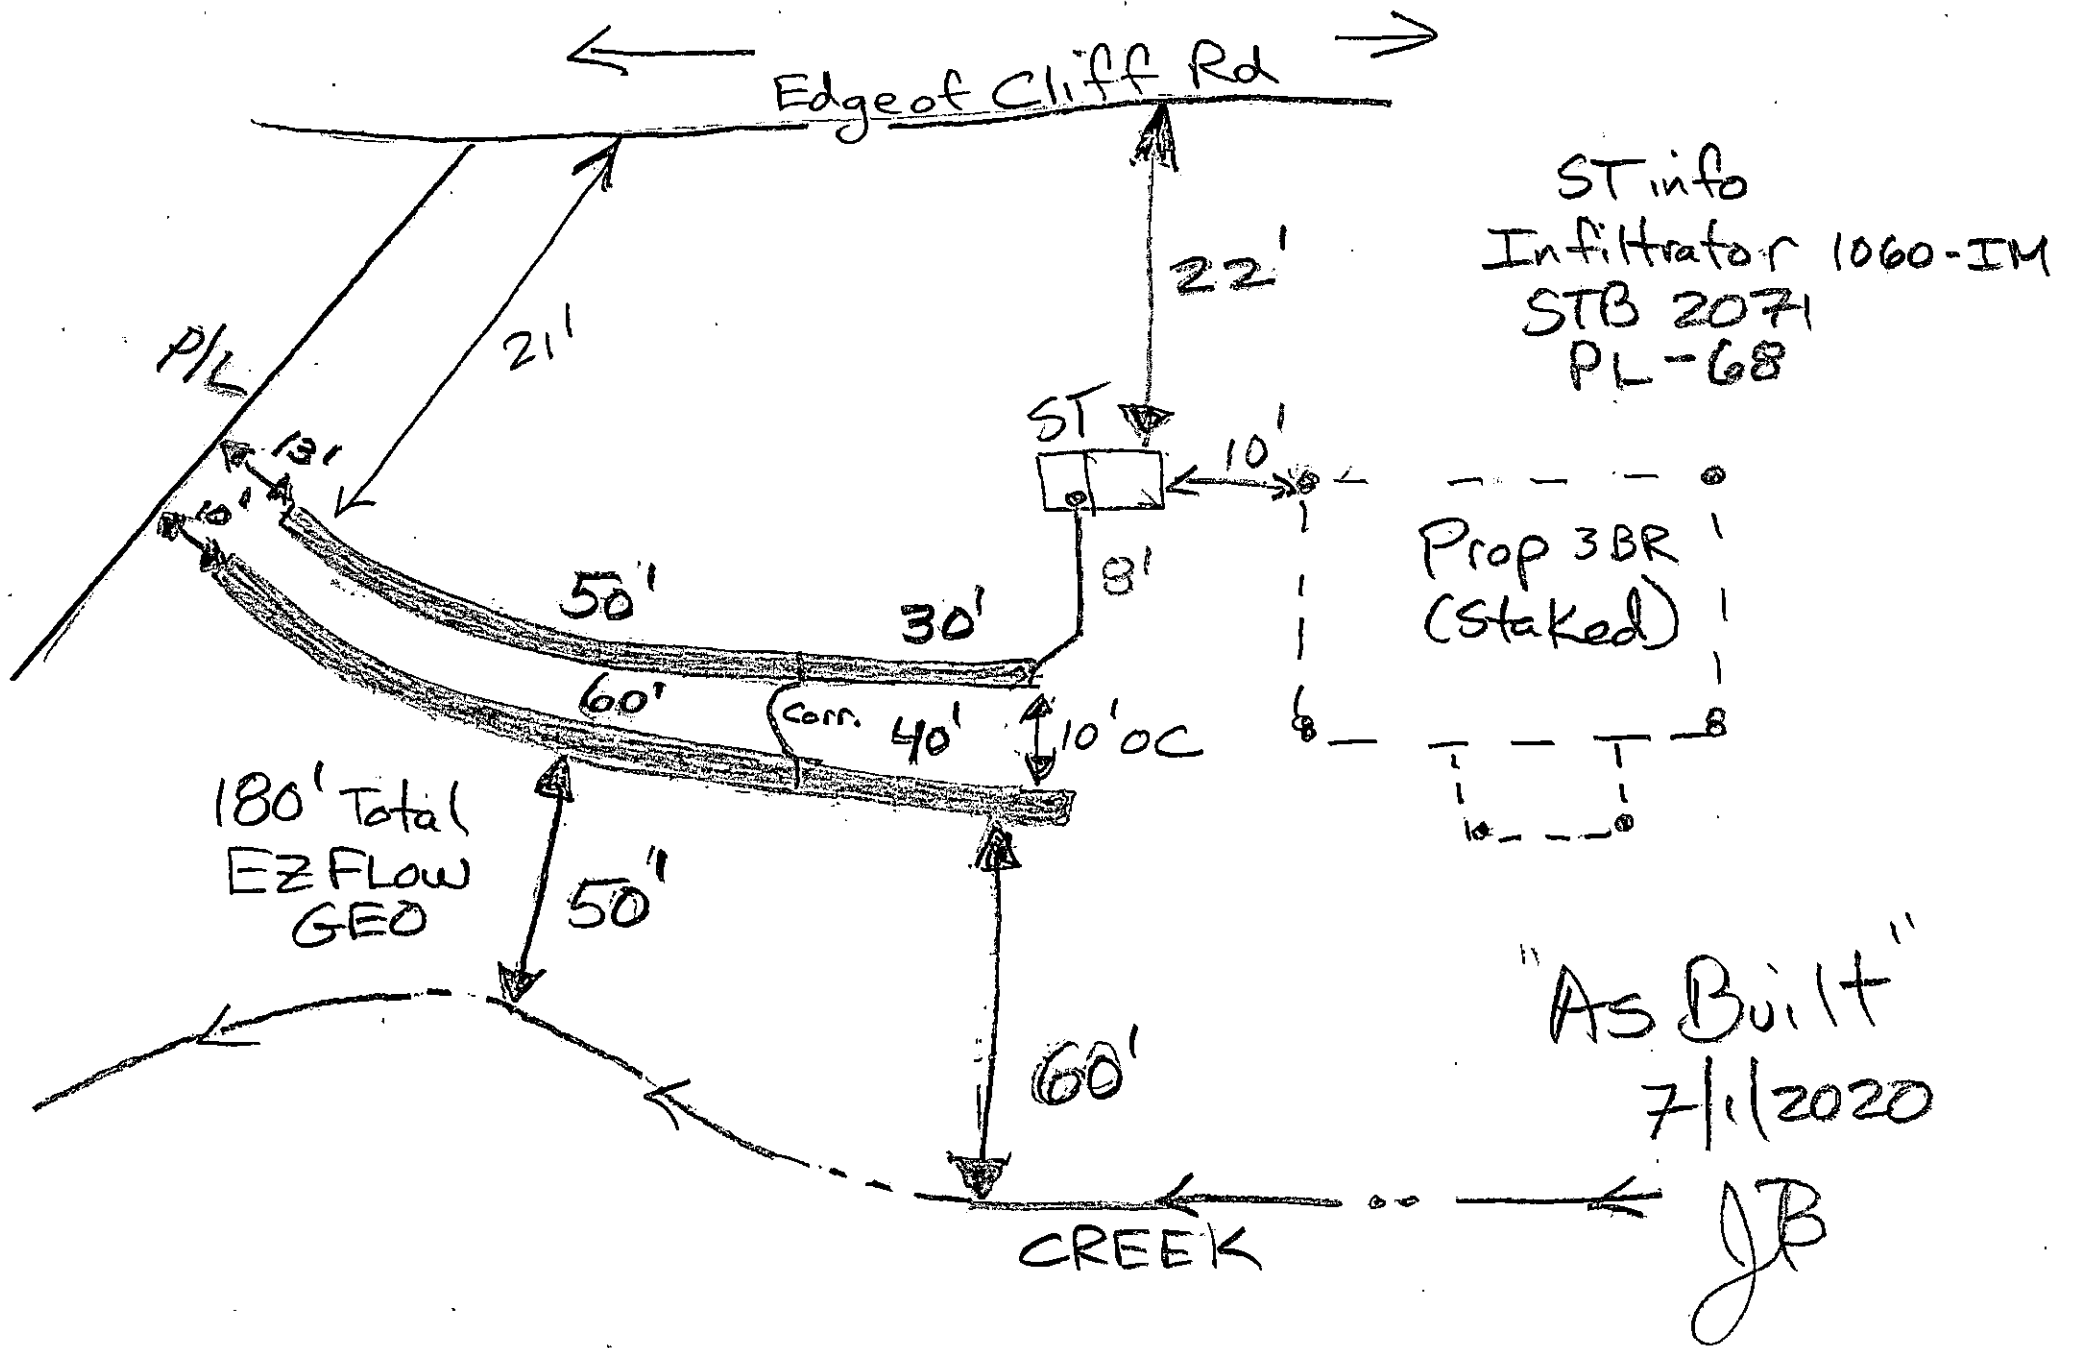

CLIFF RD; OFF CMAA CR RD

PIN:

(New PIN)

