

Perk test done


TRANSYLVANIA COUNTY HEALTH DEPARTMENT

(Sewage disposal system) Improvements Permit and Certificate of Completion


1979 Ground Absorption Sewage Disposal System - Section 130 - 160 of Chapter 130 of the General Statutes of North Carolina)

OWNER-OCCUPANT Arthur Koalman BUILDING CONTRACTOR Hub Powell
LOCATION Wilson Rd - just before entrance to Glen Cannon
SUBDIVISION Middlemount LOT NO. 374 SECT. OR BLOCK NO. _____
SEPTIC TANK CONTRACTOR Herbert Powell ADDRESS Koalman N.C.

HOUSE MOBILE HOME BUSINESS
NO. BEDROOMS 3 NO. BATHROOMS 2
SIZE OF SEPTIC TANK 805 GALS. (Liquid) _____
MATERIAL: PRE-CAST BLOCK FIBERGLASS
DISTRIBUTION BOX YES NO
NO. OF LINES 3 WIDTH 10 FT. LENGTH 60 FT.
PERCOLATION TEST YES NO
WATER SUPPLY: INDIVIDUAL PUBLIC
SITE CLASSIFICATION: SUITABLE ?
PROV. SUITABLE
UNSUITABLE

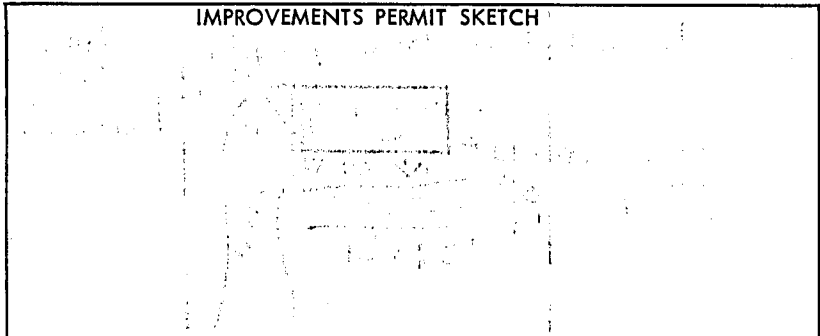

IMPROVEMENTS PERMIT: DATE: _____
BY: _____
CERTIFICATE OF COMPLETION: DATE: 12-15-80
BY: _____

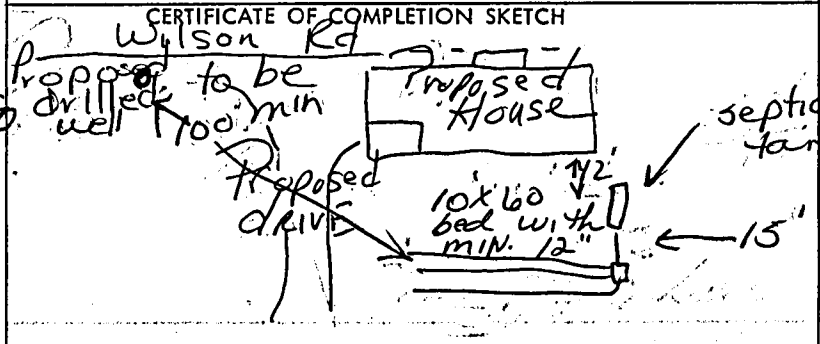

NOTICE: System installed according to Rules and Regulations but not a guarantee that it will function satisfactorily for any given period of time.

COLOR CODE: White - Owner; Pink - Improvements Permit; Blue - Contractor; Yellow - Inspection Dept.; Green - Health Dept.