



Henderson County Department of Public Health

Steven E. Smith, MPA, Health Director | Seth Swift, REHS, Environmental Health Director

1200 Spartanburg Highway, Suite 100, Hendersonville, NC 28792
Main Phone: (828) 694-6060 | Administration FAX: (828) 697-4523

Public Health
Prevent. Promote. Protect.

Septic and/or Well Permit Search Request

Please submit your completed request to Fax # (828) 697-4523 or to email address:
HCEnvHlth@hendersoncountync.gov

PROPERTY INFORMATION

Subdivision: Hidden Woods Lot# 3

Current Address: 409 Hidden Woods Lane

List Current and All Previous Owners of Property: Lora Jean Letterman- Current (2015)

Charles Leaverton (1999)

*Brewer Rd
Jesse Hagan Lane
Hiddenwood Lane
Pass C. Hiddenwood
2nd m/L*

Previous Road Name(s): Unknown

Year Residence was Built: Unknown 1985 PIN: 9559-06-8119

YOUR CONTACT INFORMATION:

0.166 acre

Date of Request: 11/02/2020

Name: Mike Carrick Phone #: 828.553.3197

FAX #: _____ EMAIL: Mikecarrick@comporium.net

ENVIRONMENTAL HEALTH DEPARTMENT SEARCH RESULTS:

Search Completed by: EJK Date: 11/5/20

Record Located Copy Attached *Please verify the information*

No Record Located

Incomplete property information provided unable to process

F- 9102

HENDERSON COUNTY HEALTH DEPARTMENT

Completion Permit

- New Construction
- Repair
- Pre-Existing Tank

Permit Number

C. No. 7216
 I. No. 7102

Owner Ty Rhodes Date 8-14-85

Building Contractor

Septic Tank Installer Morgan Landscaping

Location Behind Tree Haven

Lot No. 3 Development Hidden Woods

House Mobile Home Other
 No. Bedrooms 3 Garbage Disposal Yes No

Basement Plumbing Yes No

Water Supply - Community Individual

Lot Size 30,100

Site Evaluation - Suitable Provisional

Tank Size 1000 Drain Field 720 Sq. Ft. 3 Trenches!


Stone Depth 12 Inches 3' X 80'

Valid only for use as described above

Zoning regulations may be in effect in your area, before proceeding with construction, check with the Henderson County Zoning Officer or Inspection Department.

Received by [Signature] Approved for Material & Workmanship Only

Issued by [Signature] Sanitarian

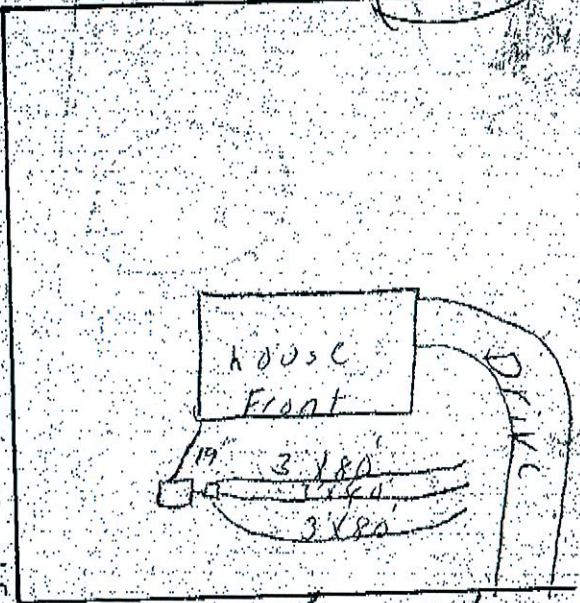

Ownership History

Data last updated on: 11/4/2020 Ownership current as of: 10/26/2020 Tax Year: 2020

[Print Property Info](#) [Search Results](#) [New Search](#)

PIN # 9559-06-8119

Property Description
HIDDEN WOODS LO3

Owner's Mailing Address
409 HIDDEN WOODS LN
HENDERSONVILLE NC 28791

Location Address
408 HIDDEN WOODS LN
LETTERMAN, LORA JEAN

Parcel Buildings Misc Improvements Land Deeds Notes Sales Photos Tax Bill Map

	Owner Name	Deed Type	% Ownership	Stamps	Sale Price	Book	Page	Deed Date
Current:	LETTERMAN, LORA JEAN ✓	GWD	100	478.00	\$238,900	001610	00307	03/20/2015
1 Back	LEAVERTON, CHARLES W/LEAVERTON, SUZANNE T ✓	GWD	100	329.00	\$0	000984	00303	04/09/1999
2 Back	LEAVERTON, CHARLES W ✓	GWD	100	329.00	\$0	000984	00303	04/09/1999
3 Back	BACON, ELIZABETH D ✓	GWD	100	0.00	\$0	00091E	00699	11/19/1991
4 Back	RHODES, PAUL T/ RHODES, JUNE ✓	GWD	100	112.00	\$0	000671	00463	01/17/1986