

# Transylvania County Health Department Certificate Of Approval

The sewerage disposal system described on the record below has been inspected and approved by an agent of the Transylvania County Health Department.

*New House*  
*Henry M. McDonald, Jr. - Doctor* Signed *Paul M. Dennis, R.S.*

## Sewage Disposal Record

Occupant \_\_\_\_\_ Owner *Dr. Bennett*

Location of Building *Blakes Hills Dr.*

Address *Blakes Hills Dr., N.C.*

Contractor *Morgan Sewer Service Co. Address *Elora, N.C.**

Date of Inspection *11-17-72* No. of Bedrooms *3* Baths *2* No. of Users \_\_\_\_\_

Septic Tank Materials: Concrete Block (Size \_\_\_\_\_ in.)  Poured Concrete  Pre-Cast

Capacity *1200* Gals. Single or Double Compartment

Adequate For: Garbage Grinder    
Yes No

Nitrification Field Materials: Terra Cotta  Concrete  Perforated Plastic

Distribution Box *Yes* No. of Lines *3* Width *11 ft.* Length of Lines *45 ft.*

Stone \_\_\_\_\_ Other \_\_\_\_\_

Adequate For: Washing Machine    
Yes No


*plus  
extra gravel  
and approx.  
3ft. pit at  
end of bed.*

Sand Filter No. of Lines \_\_\_\_\_ Width of Line \_\_\_\_\_ Length of Line \_\_\_\_\_ Approved Sand \_\_\_\_\_

Precolation Test    
Yes No

*Note: Checked for space. Soil also  
red clay.  
City water supply.*

Sketch of System

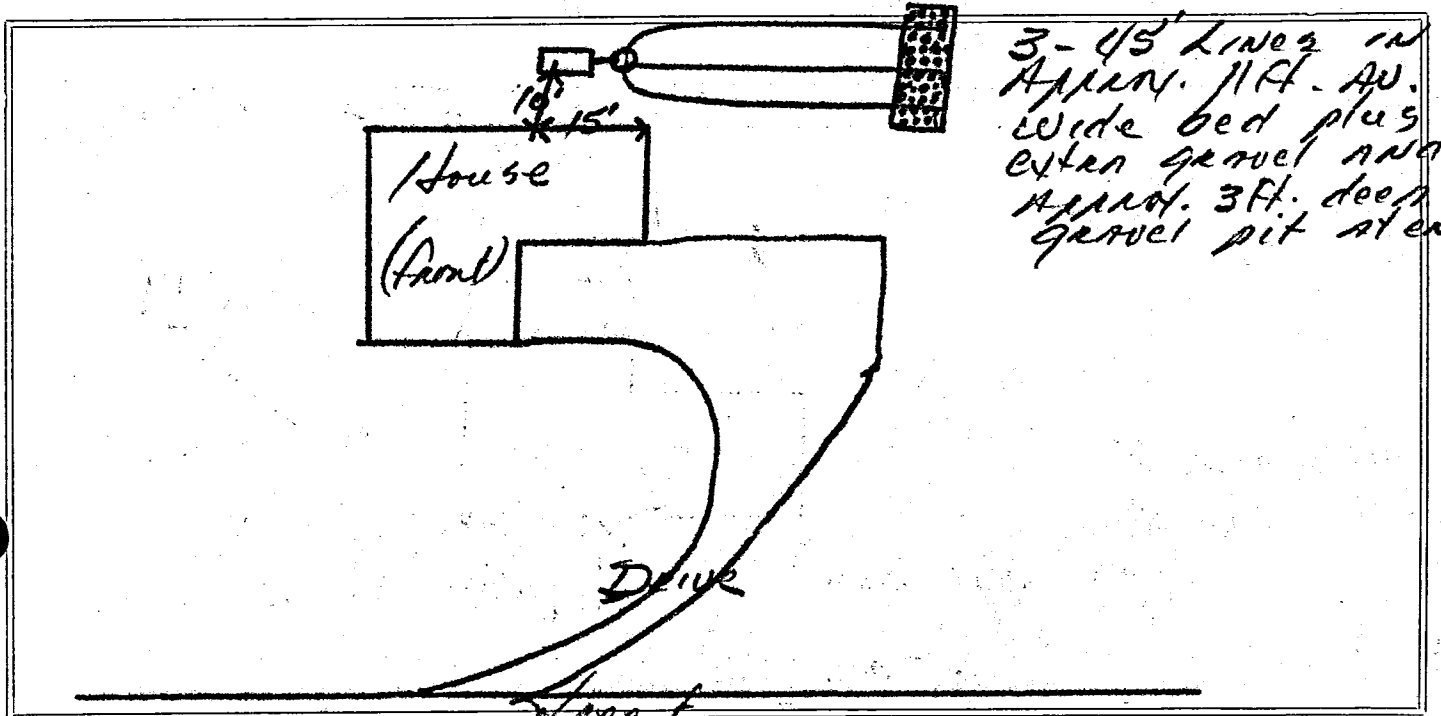



Brenda Eav <brenda@lookingglassrealty.com>

---

## PINS 8585-12-9802-000 and 8585-12-9926-000

---

**Environmental Health** <ENVIRONMENTAL.HEALTH@transylvaniacounty.org>

Mon, Feb 8, 2021 at 9:57 AM

To: Brenda Eav <brenda@lookingglassrealty.com>

Hi Brenda,

Here is a possible match for PIN 8585-12-9802-000. I cannot locate a record for PIN 8585-12-9926-000.

[Raime L Hebb](#)

[Environmental Health Office Support](#)

[Phone: 828.884.3139 Fax: 828.884.3259](#)

[raime.hebb@transylvaniacounty.org](mailto:raime.hebb@transylvaniacounty.org)



106 EAST MORGAN STREET  
SUITE 105  
BREVARD, NC 28712  
828.884.3135  
[transylvaniahealth.org](http://transylvaniahealth.org)

**EVERYDAY. EVERYWHERE. EVERYONE.**

"CONFIDENTIALITY & SECURITY NOTICE: All email messages including any attachments generated from or received by this site are the property of Transylvania County Government and as such are considered public domain and are subject to the North Carolina Public Record Law. The Transylvania County Department of Public Health does not transmit client/patient medical information via email. Certain other confidential information may be transmitted and any unauthorized review, use, disclosure or distribution is prohibited. If you are not the intended recipient, please contact the sender by reply email and destroy all copies of the original message. If you believe there has been an inappropriate disclosure, please contact Transylvania County Department of Public Health Privacy Officer at [828-884-3135](tel:828-884-3135)."

[Quoted text hidden]



**Bennett, Don.pdf**

67K