


"AS BUILT" DRAWING  
MEASURED BY MR LLC

MAIN FLOOR (HEATED) = 1,689.45 SQ.FT.  
2 CAR GARAGE / STORAGE (N/H) = 613.47 SQ.FT.  
FRONT PORCH = 140.00 SQ.FT.  
SUN DECK = 534.39 SQ.FT.

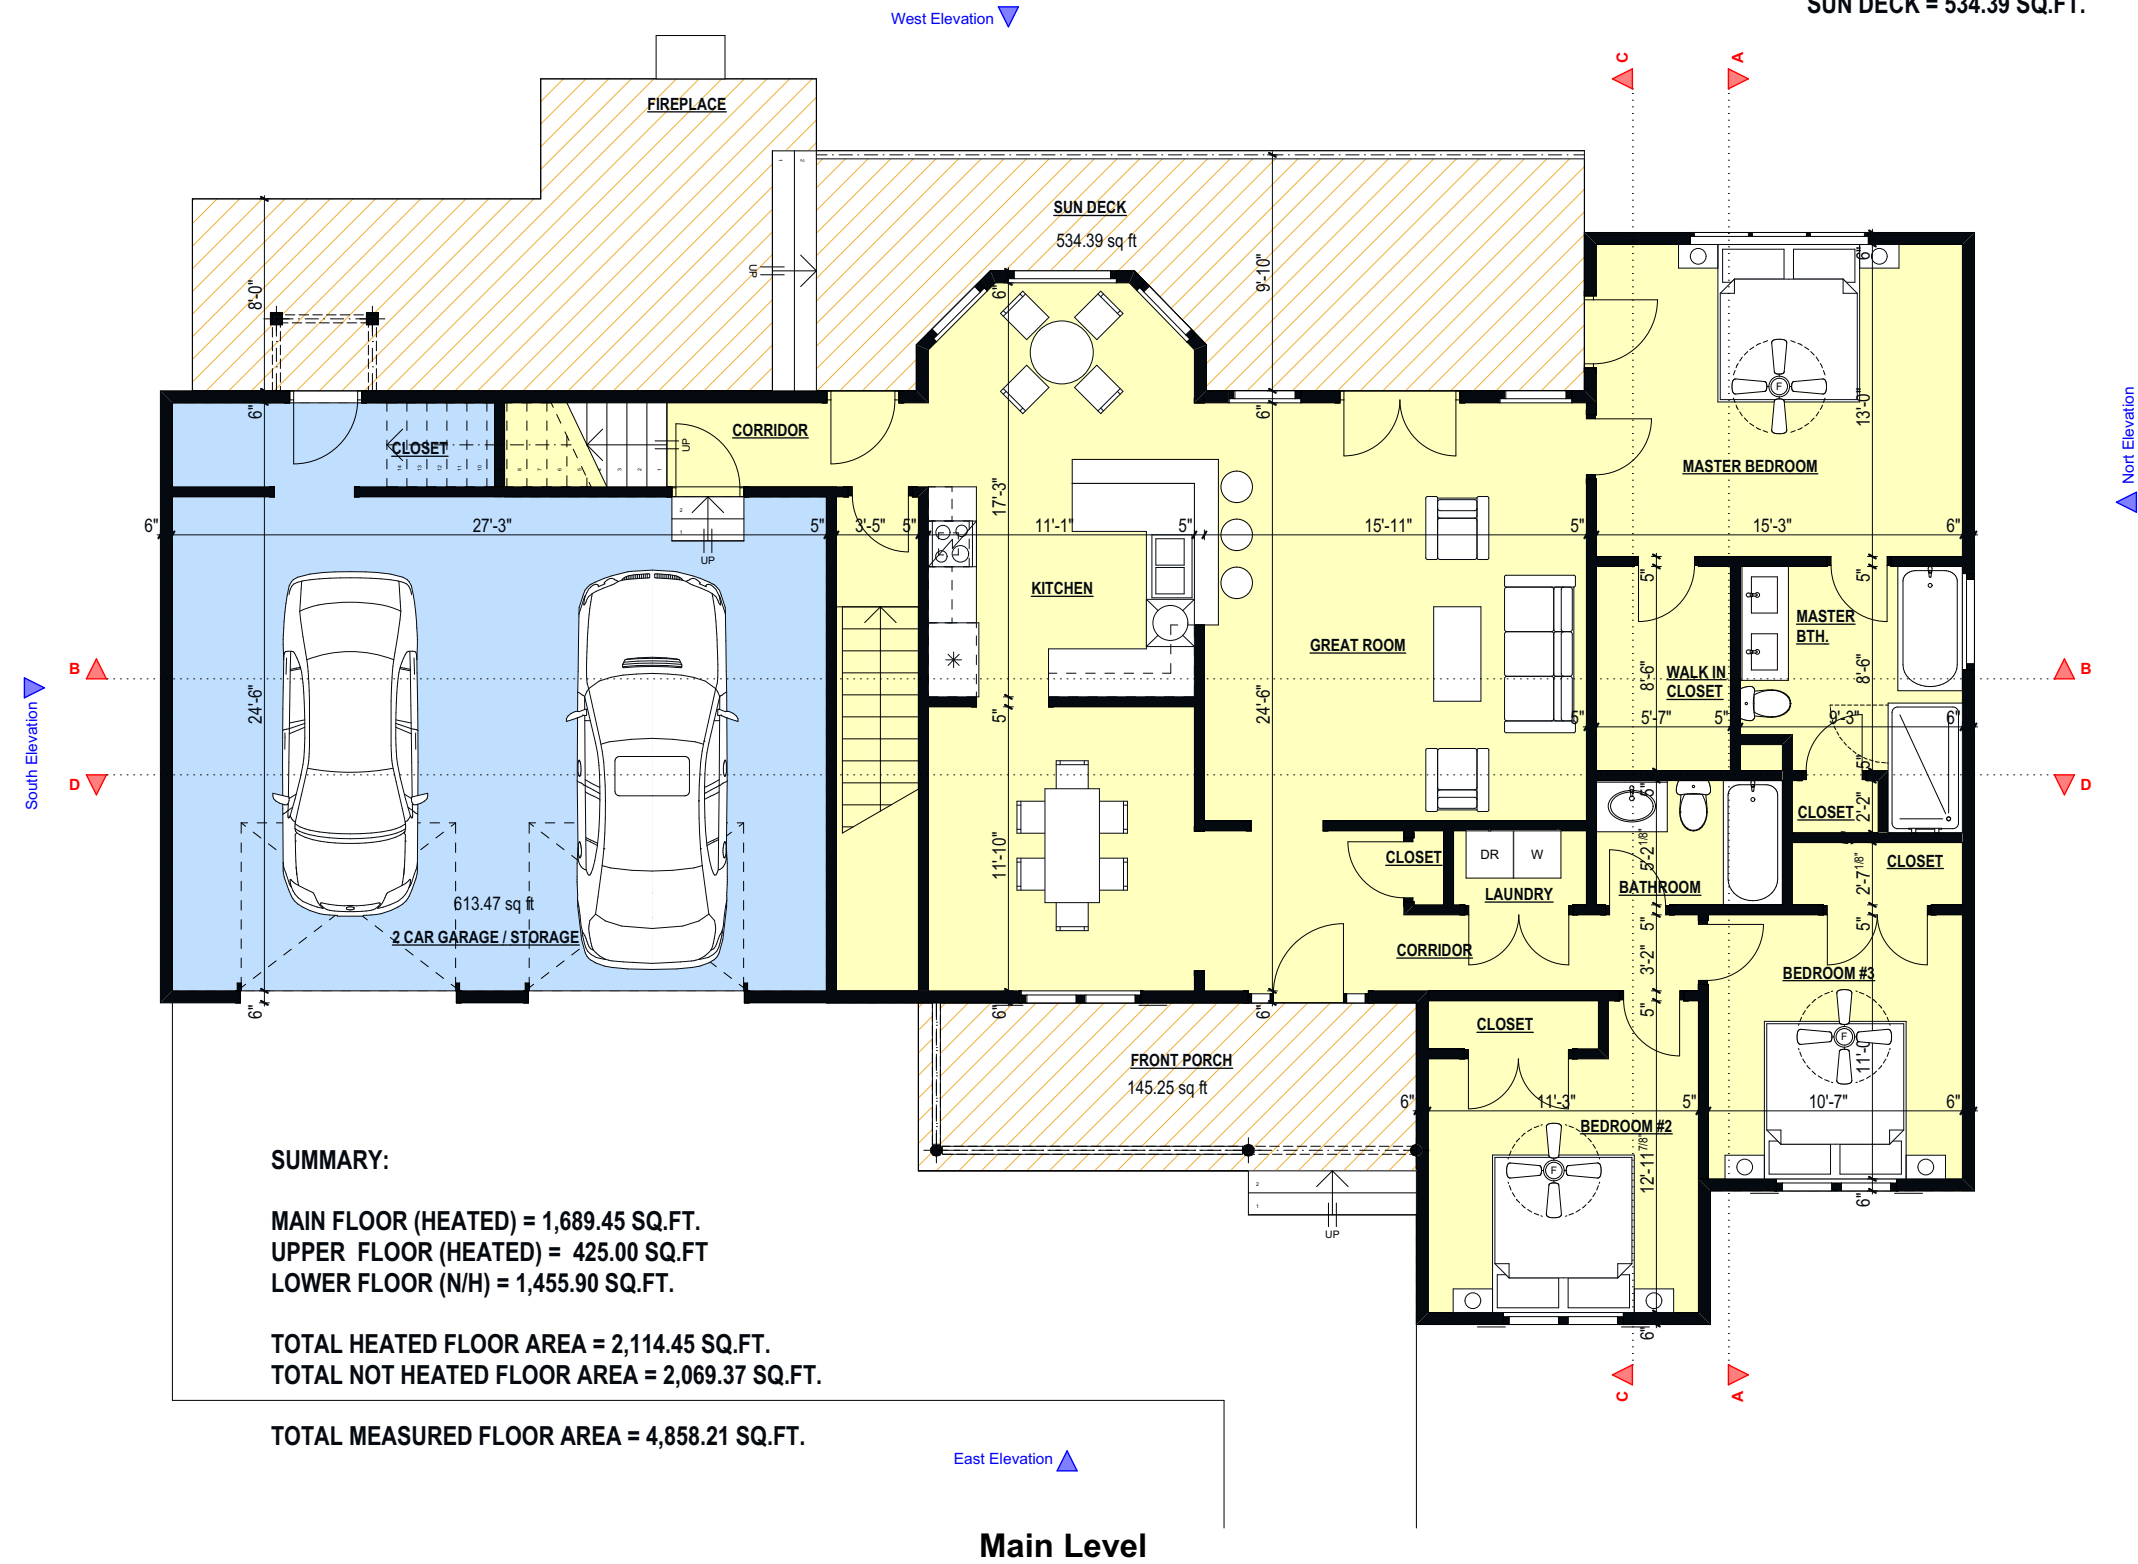

**SUMMARY:**  
 MAIN FLOOR (HEATED) = 1,689.45 SQ.FT.  
 UPPER FLOOR (HEATED) = 425.00 SQ.FT.  
 LOWER FLOOR (N/H) = 1,455.90 SQ.FT.  
 TOTAL HEATED FLOOR AREA = 2,114.45 SQ.FT.  
 TOTAL NOT HEATED FLOOR AREA = 2,069.37 SQ.FT.  
 TOTAL MEASURED FLOOR AREA = 4,858.21 SQ.FT.

GENERAL NOTES:  
 1. DO NOT USE AS A BLUEPRINTS WITHOUT MR LLC PERMISSION.  
 2. PLEASE NOTE INTERIOR DIMENSIONS WERE NOT USED IN CALCULATING SQUARE FOOTAGE  
 3. SIZE OF HEATED AND NOT HEATED AREA AND OTHER INFORMATION WERE OBTAINED PER THE NC REAL ESTATE COMMISSION GUIDELINES (6" FOR EXTERNAL WALLS EXCEPT CONDOMINIUMS)  
 4. FOR REMODELING QUESTIONS OR MORE DETAILED CAD DRAWINGS (INC. SITE PLAN, SECTIONS, ELEVATIONS) ALSO 3D MODEL PLEASE CONTACT ALFRED ZALYS MOB. 828 231 7305 E-MAIL: A.ZALYS@HOTMAIL.COM

LEGEND MAP:  

 HEATED FINISHED  
 NOT HEATED/NOT FINISHED  
 WOOD/CER.TILES  
 CONCRETE

MEASURE RITE LLC  
 Robert West  
 mob.828 691-9378,  
 e-mail: west1946@att.net  
 Alfred Zalys  
 mob.828 231 7305,  
 e-mail: a.zalys@hotmail.com  
 PO Box15671 Asheville NC28813  
 EIN #:81-4072168 TCCU BANK

Client: :  
 #Client E-mail  
 #Client Phone Number  
 Site Address: 15 Grizzley Dr, Leicester, NC 28748


Drawing Name  
 Main Level, Generic Perspective / MAIN  
 Contact Name  
 Alfred ZALYS  
 Job Nr.  
 MR 719  
 Date  
 5/8/2021

Drawing Scale  
 1/8" = 1'-0", 1:137.14  
 Layout Nr.  
 1  
 Layouts Total  
 3  
 Paper Size  
 ANSI B



"AS BUILT" DRAWING  
MEASURED BY MR LLC

UPPER FLOOR (HEATED) = 425.00 SQ.FT

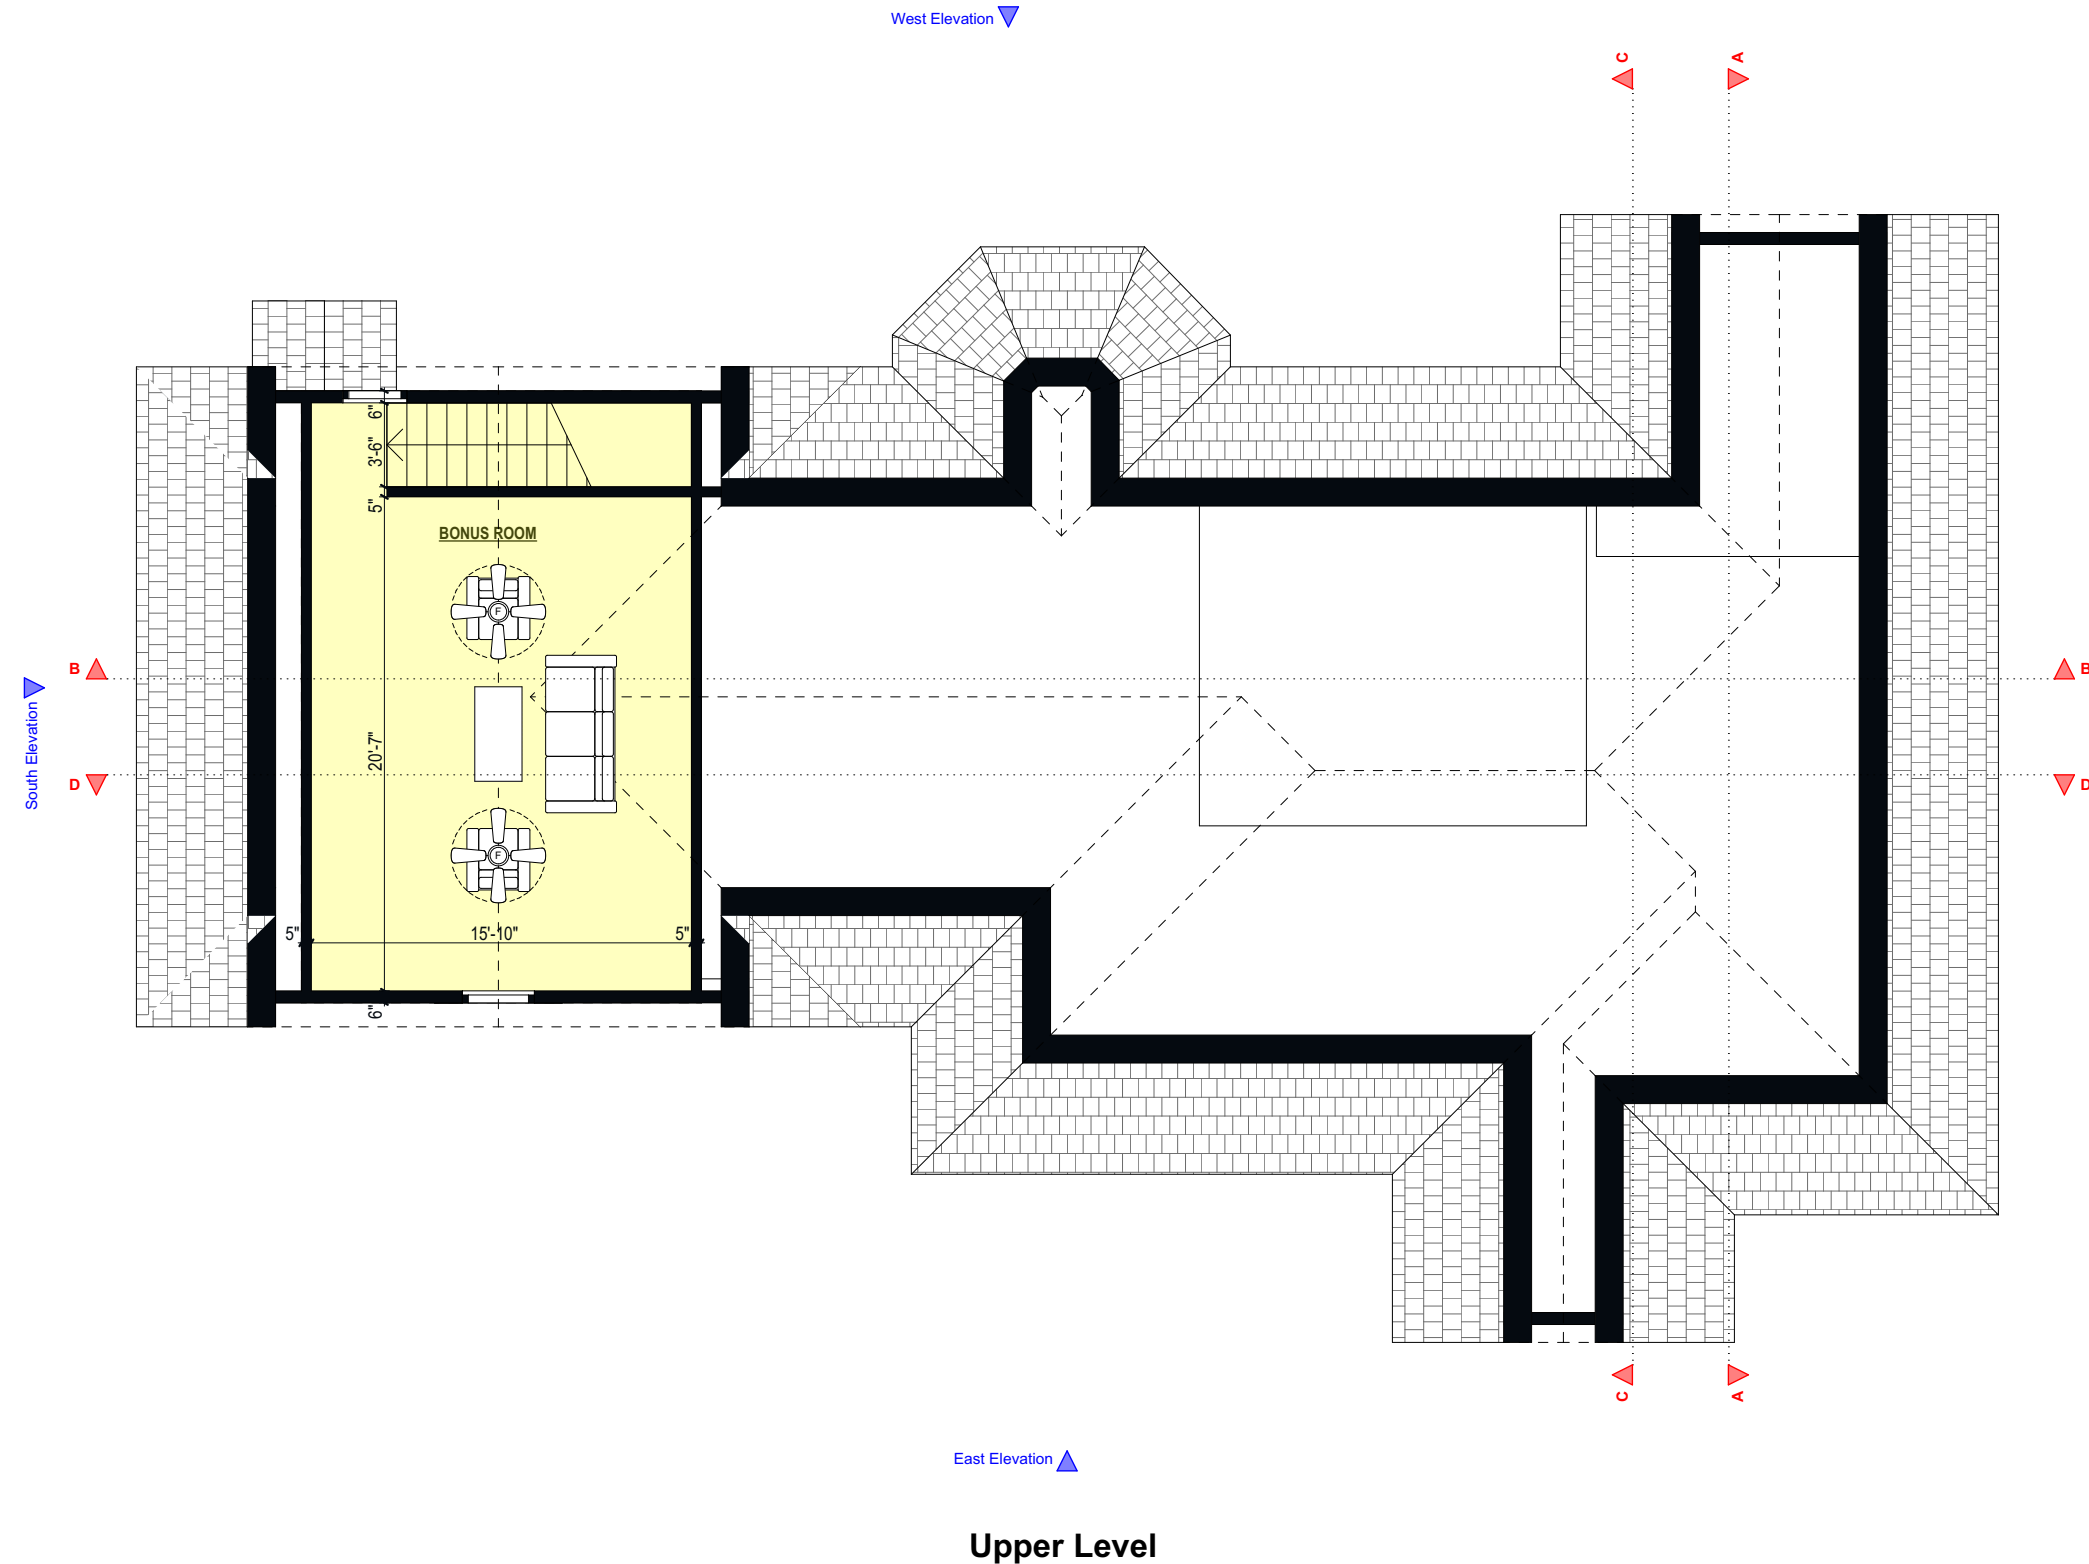

GENERAL NOTES:  
 1. DO NOT USE AS A BLUEPRINTS WITHOUT MR LLC PERMISSION.  
 2. PLEASE NOTE INTERIOR DIMENSIONS WERE NOT USED IN CALCULATING SQUARE FOOTAGE  
 3. SIZE OF HEATED AND NOT HEATED AREA AND OTHER INFORMATION WERE OBTAINED PER THE NC REAL ESTATE COMMISSION GUIDELINES (6" FOR EXTERNAL WALLS EXCEPT CONDOMINIUMS)  
 4. FOR REMODELING QUESTIONS OR MORE DETAILED CAD DRAWINGS (INC. SITE PLAN, SECTIONS, ELEVATIONS) ALSO 3D MODEL PLEASE CONTACT ALFRED ZALYS MOB. 828 231 7305 E-MAIL: A.ZALYS@HOTMAIL.COM

LEGEND MAP:  

 HEATED FINISHED  
 NOT HEATED/NOT FINISHED  
 WOOD/CER.TILES  
 CONCRETE



	MEASURE RITE LLC Robert West mob.828 691-9378, e-mail: west1946@att.net Alfred Zalys mob.828 231 7305, e-mail: a.zalys@hotmail.com	Client: : #Client E-mail #Client Phone Number	Drawing Name Upper Level, Generic Perspective / UPPER		Drawing Scale 1/8" = 1'-0", 1:137.14
	PO Box15671 Asheville NC28813 EIN #:81-4072168 TCCU BANK	Site Address: 15 Grizzley Dr, Leicester, NC 28748	Contact Name Alfred ZALYS mob. 828 231 7305	Job Nr. MR 719	Date 5/8/2021

Layouts Total 3  
Paper Size ANSI B

"AS BUILT" DRAWING  
MEASURED BY MR LLC



LOWER FLOOR (N.H) = 1,455.90 SQ.FT  
MECH./STORAGE

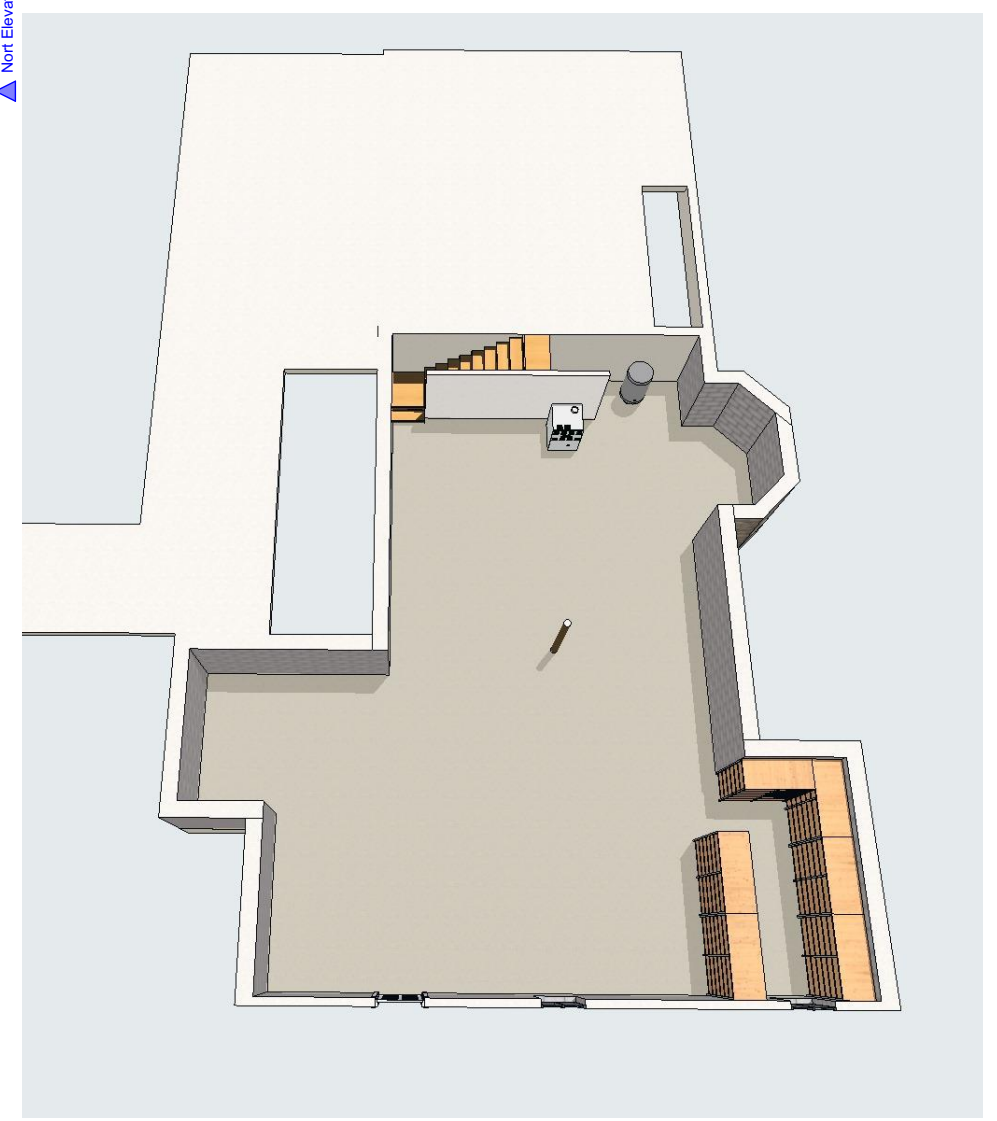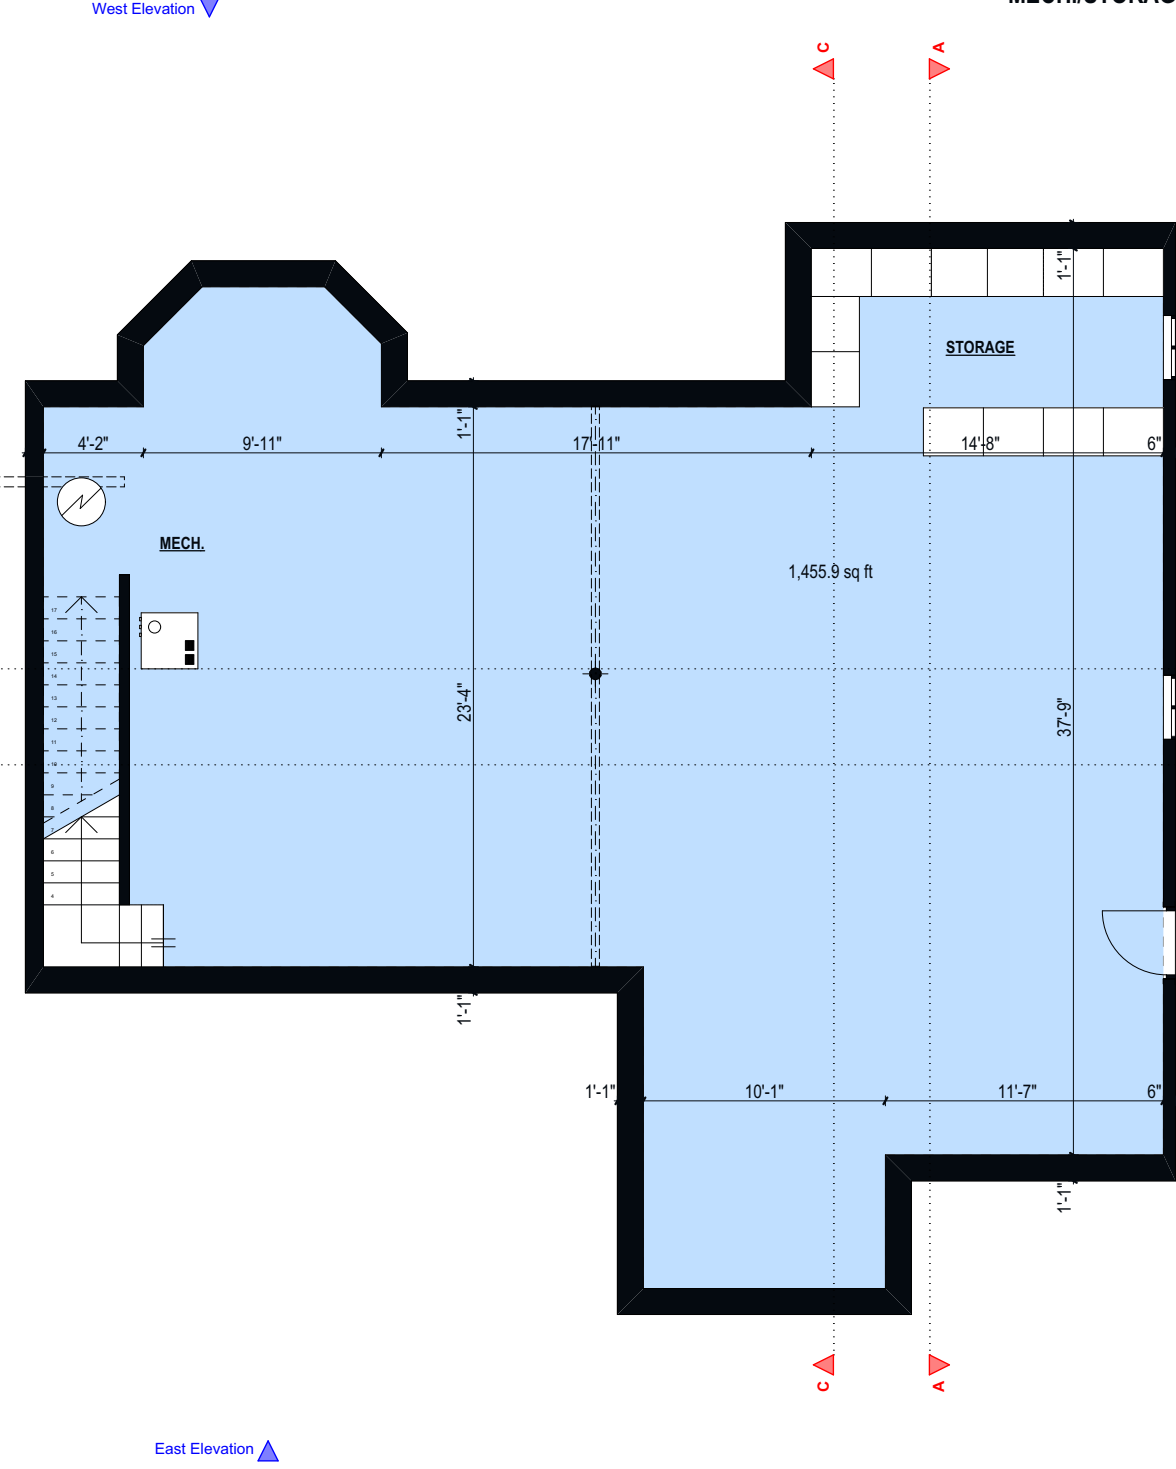

Lower Level

Generic Perspective / LOWER

GENERAL NOTES:  
 1. DO NOT USE AS A BLUEPRINTS WITHOUT MR LLC PERMISSION.  
 2. PLEASE NOTE INTERIOR DIMENSIONS WERE NOT USED IN CALCULATING SQUARE FOOTAGE  
 3. SIZE OF HEATED AND NOT HEATED AREA AND OTHER INFORMATION WERE OBTAINED PER THE NC REAL ESTATE COMMISSION GUIDELINES (6" FOR EXTERNAL WALLS EXCEPT CONDOMINIUMS)  
 4. FOR REMODELING QUESTIONS OR MORE DETAILED CAD DRAWINGS (INC. SITE PLAN, SECTIONS, ELEVATIONS) ALSO 3D MODEL PLEASE CONTACT ALFRED ZALYS MOB. 828 231 7305 E-MAIL: A.ZALYS@HOTMAIL.COM

LEGEND MAP:

	HEATED FINISHED
	NOT HEATED/NOT FINISHED
	WOOD/CER.TILES
	CONCRETE

MEASURE RITE LLC  
 Robert West  
 mob.828 691-9378,  
 e-mail: west1946@att.net  
 Alfred Zalys  
 mob.828 231 7305,  
 e-mail: a.zalys@hotmail.com  
 PO Box15671 Asheville NC28813  
 EIN #81-4072168 TCCU BANK

Client: :  
 #Client E-mail  
 #Client Phone Number  
 Site Address: 15 Grizzley Dr, Leicester, NC 28748

Drawing Name Lower Level, Generic Perspective / LOWER		Drawing Scale 1/8" = 1'-0", 1:137.14	
Layout Nr. 3		Layouts Total 3	
Contact Name Alfred ZALYS mob. 828 231 7305	Job Nr. MR 719	Date 5/8/2021	Paper Size ANSI B