

File Name: REYNOLDSWOOD

**TRANSYLVANIA COUNTY HEALTH DEPARTMENT  
ON-SITE WASTEWATER DISPOSAL APPLICATION**

8564-21-3853-000  
Pin #/Tax ID

Permit #: 04-181  
Agent/Owner: WHITMIRE, JERRY

Receipt No: 1175

Home Phone #: ( ) 862-3646

Mailing Address: 1175 View Rd. Brevard, NC

Proposed Buyer: \_\_\_\_\_

Work Phone #: ( ) \_\_\_\_\_

Home Phone #: ( ) \_\_\_\_\_

Mailing Address: \_\_\_\_\_

Property Location: View Rd. Subdivision: Reynoldswood Phase/Sect.: \_\_\_\_\_ Lot #: 15  
Road/Street

Directions to property:  Hwy. 64 west to right on Morgan Mill - right into Reynoldswood - left on View Rd. - lot 15 on right at top

**Flood Zone**  
Is the property in a flood zone?  
☐ Yes ☐ No ☐ Unknown

**Inspections**  
**Flood Zone**  
☐ Yes ☐ No  
☐ Approved ☐ Disapproved  
Initials \_\_\_\_\_ Date \_\_\_\_\_

Installation for: Mobile Home ☐ Single ☐ Double ☐ House ☒ No. Bedrooms: 3 Basement: Yes ☒ No ☐ With Plumbing: Yes ☒ No ☐ Ind./Commercial ☐ Other ☐

If Indust./Commercial/Other: Number of employees: \_\_\_\_\_ Operation: (Describe) \_\_\_\_\_ Property contains designated wet lands: Yes ☐ No ☐

Lot size: 1.17 Date lot recorded: 1977 Right of ways, easements, etc. road Water Supply: Private: ☐ Spring ☐ Well ☒ Shared Supply ☐ Public/Community

I certify the above to be correct to the best of my knowledge. Permission is hereby granted to perform a site/soil evaluation on the property described above. If the information submitted in this application is falsified or changed, the permit shall become void. I understand that it is my responsibility as the applicant/agent/owner to comply with all applicable ordinances, laws, and rules from other agencies that may affect the development of this property.

Applicant/Agent Signature: Jerry Whitmire Date: 3-25-04

**ON-SITE WASTEWATER DISPOSAL SYSTEM  
OPERATIONS PERMIT**

The issuance of this operations permit certifies that the system described on the improvement permit and the construction authorization is properly installed or repaired and that the system is capable of being operated in accordance with the conditions of the improvement permit, Article 11 of Chapter 130A of the General Statutes of North Carolina and the rules adopted pursuant to this Article. This operation permit shall remain in effect as long as the system is operated and maintained as required by the Laws and Rules for Sewage Treatment and Disposal Systems as issued by the North Carolina Department of Environment and Natural Resources, Division of Environmental Health.

System Classification Type: III f Management Entity: ☒ Owner ☐ Certified Operator Minimum inspection/maintenance review frequency N/A years.

Comments: 10" ID LDP  
Clean/Replace septic tank effluent filter as req'd

Installed by: Jerry Whitmire Grading Final Inspection by: James A. Bayer, RS Date: 5/27/04


# TRANSYLVANIA COUNTY HEALTH DEPARTMENT IMPROVEMENT PERMIT DIAGRAM

00-375

le Name: Clinton Holland

Permit No.: \_\_\_\_\_

Pin No: 8564-21-3853-000

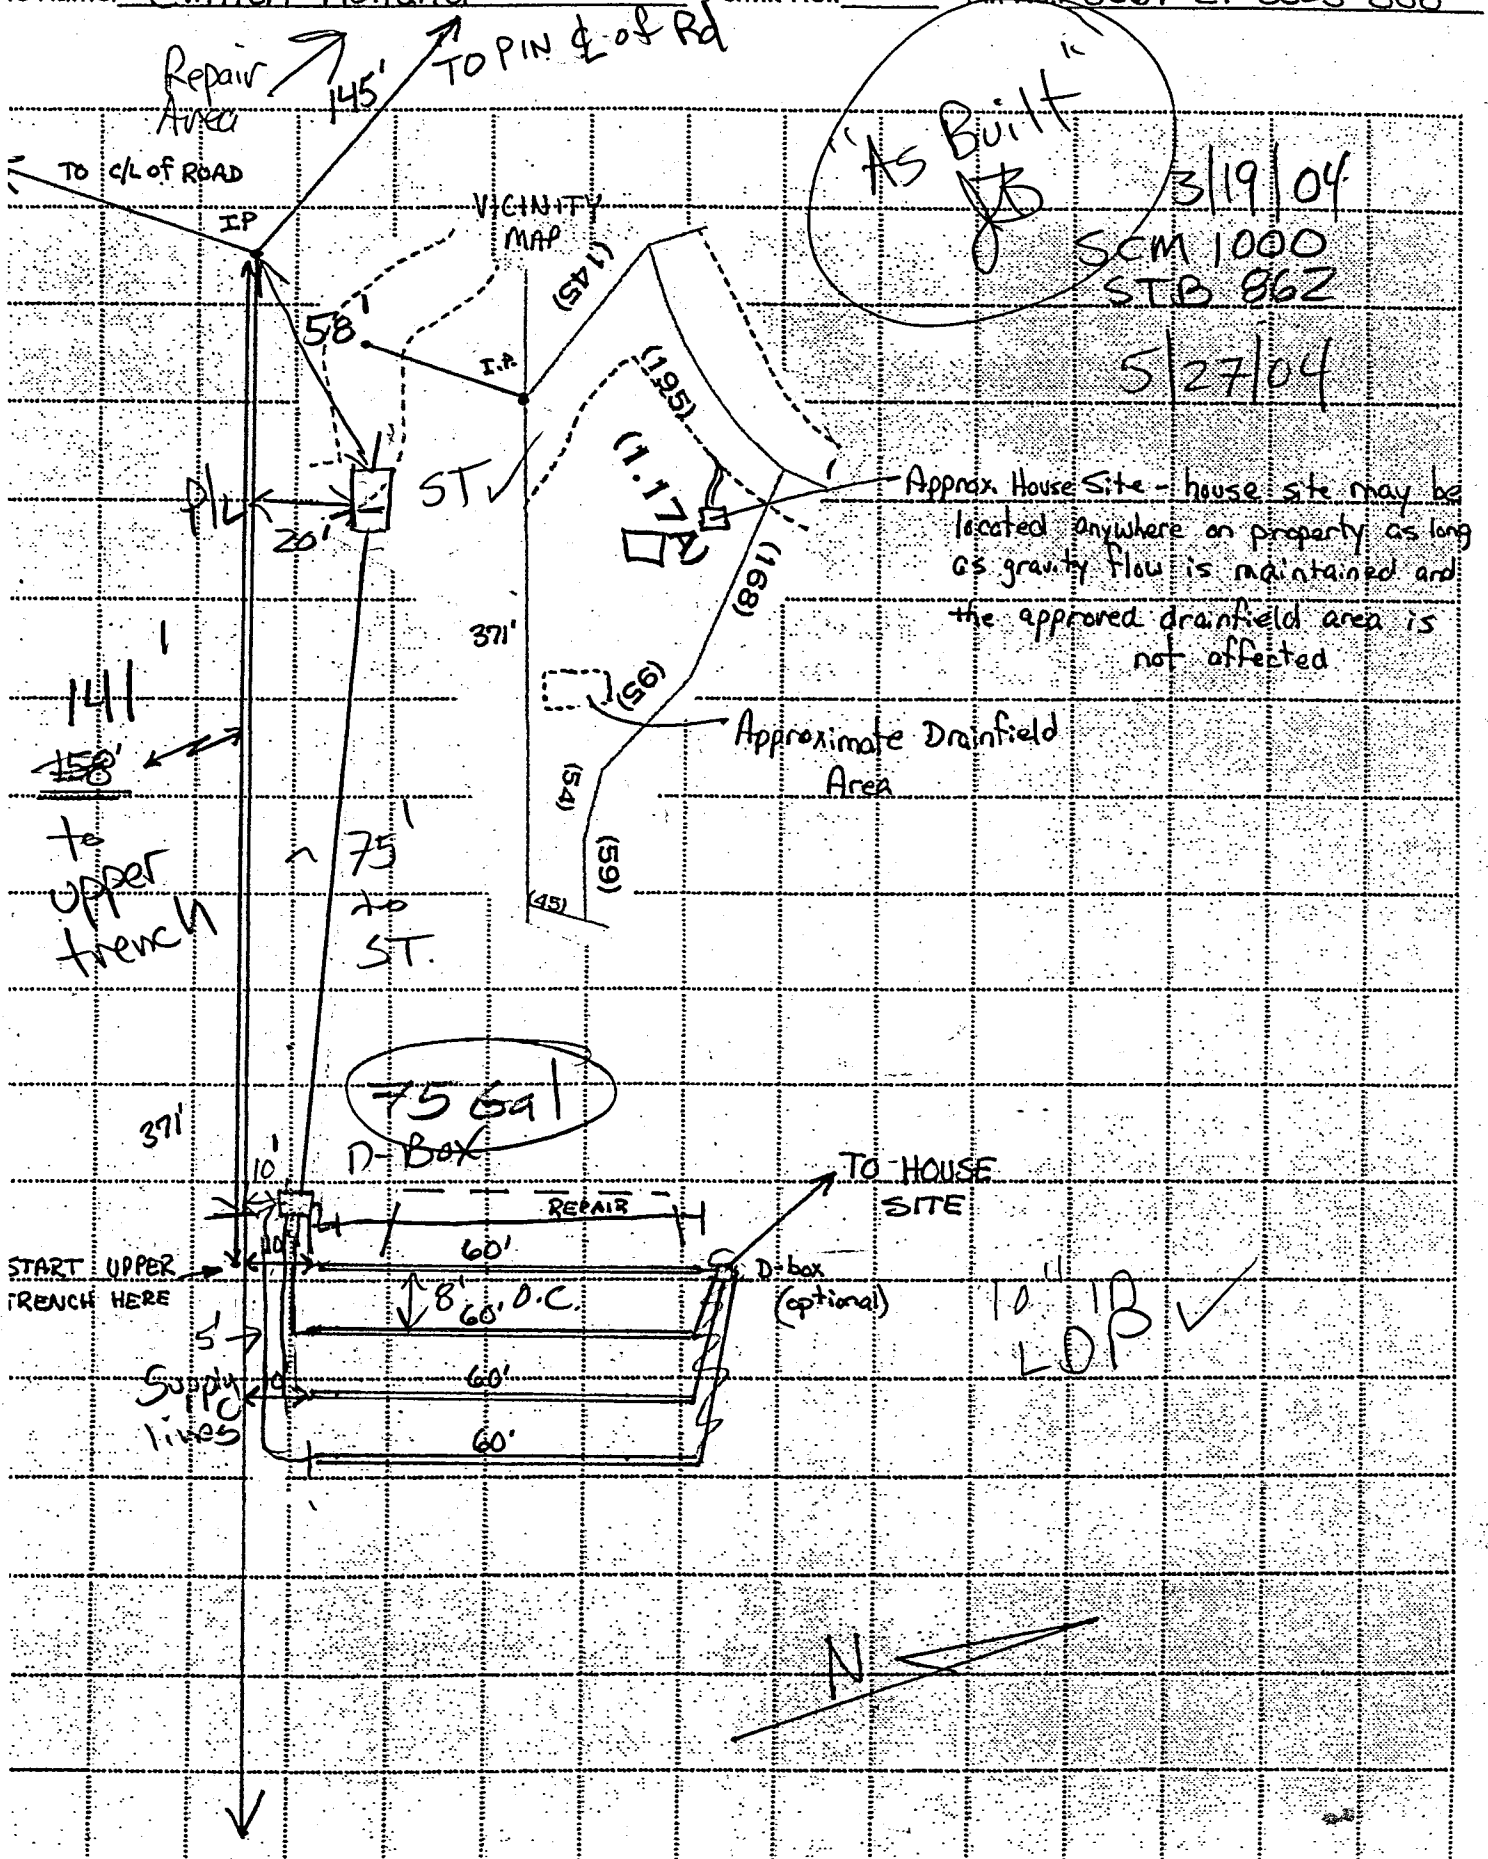

File Name: REYNOLDSWOOD

**TRANSYLVANIA COUNTY HEALTH DEPARTMENT  
ON-SITE WASTEWATER DISPOSAL APPLICATION**

8564-21-3853-000

Pin #/Tax ID

Permit #: 04-181

Agent/Owner: WHITMIRE, JERRY

Home Phone #: ( ) 862-3646

Proposed Buyer:

Home Phone #: ( )

Property Location: View Rd. Subdivision: Reynoldswood Phase/Sect.: \_\_\_\_\_ Lot #: 15  
Road/Street

Directions to property: Hwy. 64 west to right on Morgan Hill - right into Reynoldswood - left on View  
Rd. - lot 15 on right at top

Receipt No 6925 2550  
addition done

**Flood Zone**

Is the property in a flood zone?

☐ Yes ☐ No ☐ Unknown

**Inspections**

**Flood Zone**

☐ Yes ☐ No

☐ Approved ☐ Disapproved

Initials \_\_\_\_\_ Date \_\_\_\_\_

Installation for: Mobile Home ☐ Single ☐ Double ☐ House ☒ No. Bedrooms: 3 Basement: Yes ☒ No ☐ With Plumbing: Yes ☒ No ☐ Ind./Commercial ☐ Other ☐

If Indust./Commercial/Other: Number of employees: \_\_\_\_\_ Operation: (Describe) \_\_\_\_\_ Property contains designated wet lands: Yes ☐ No ☐

Lot size: 1.17 Date lot recorded: 1977 Right of ways, easements, etc. road Water Supply: Private: ☐ Spring ☐ Well ☒ Shared Supply ☐ Public/Community

I certify the above to be correct to the best of my knowledge. Permission is hereby granted to perform a site/soil evaluation on the property described above. If the information submitted in this application is falsified or changed, the permit shall become void. I understand that it is my responsibility as the applicant/agent/owner to comply with all applicable ordinances, laws, and rules from other agencies that may affect the development of this property.

Applicant/Agent Signature: Jerry V. Whitmire

Date: 3-25-04

**AUTHORIZATION FOR WASTEWATER SYSTEM CONSTRUCTION  
(Diagram and Conditions Attached)**

New Installation: ☒ Repair/Addition: ☐ Original Permittee: \_\_\_\_\_ Dated: \_\_\_\_\_  
Design waste flow: 360 GPD LTAR: 0.475 Septic Tank Capacity: 1000 gal./min. Pump Tank Capacity: \_\_\_\_\_ gal./min. Proposed Wastewater System: 10" 10 LDP  
Drainfield: Total Trench Length: 300 ft. Square Footage: 760 Trench spacing: 8 ft. on ctr. Individual Trench Length: (5) 60 ft. Maximum Trench Depth (Low Side): 16 in. Trench Width: 12 in.  
Distribution Method: Equal Min. distance between system and nearest Well: 100 ft. Water line: 10 ft. Foundation: 15 ft. Property line: 10 ft. Vertical Cut: 15 ft.  
Comments & Special Conditions: Reynoldswood lots 15 & 16 combined (Repair area is on old lot 16 and is PPBPS system as indicated on drawing.)

Construction of the wastewater system for the permit indicated is hereby authorized. The wastewater system described in the improvement permit has been designed and can be installed and operated in compliance with Article 11 of Chapter 130A of the General Statutes of North Carolina and Rules adopted pursuant to this Article. This Construction Authorization is valid for a period of 5 years from the original date of issue. The Construction Authorization must be renewed upon expiration prior to the installation/repair of the wastewater system, or prior to the issuance of any required building permits. A pre-construction conference with the owner or developer, or an agent of the owner or developer, and the health department will be required for re-issuance of the Construction Authorization.

I agree to install the wastewater disposal system in accordance with the improvement permit, construction authorization and any conditions specified therein.

Signed: Jerry V. Whitmire Date: \_\_\_\_\_ Construction Authorization prepared by: James A. Bayer, RS Date: 5/18/04

**PERMIT AND CONSTRUCTION AUTHORIZATION MUST BE ON SITE DURING ALL PHASES OF CONSTRUCTION/INSTALLATION AND INSPECTION**