
	RANSYLVANIA COUNTY HEALTH DEPARTMENT I-SITE WASTEWATER DISPOSAL APPLICATION	Pin #/Tax ID 856421311500 C
Permit #: -	FOIL PAOILIFAILE BIO. COALAIT LICENTE	Receipt No
Agent/Owner: Linda T. Whitnire	Mailing Address: 757 Catheya Creek Chuch Rd. Breva	ırd
fome Phone #: () 883-3867	Work Phone #: ()	Flood Zone
Proposed Buyer:	Mailing Address:	Is the property in a flood zone?
lome Phone #: ()	Work Phone #: ()	7 Strand Ves No Unknown Inspections
	vision: Reynods Woods Phase/Sect.: A Lot #:	7 Flood Zone
Poad/Street 64 W. to Morgan H111 Rd at the end	. 100° to Reynolds Woods go to top of Mtn. property	Yes I No Approved Disapproved Initials Date
	No. Bedrooms: 3 Basement: Yes No With Plumbing: Yes No No. Bedrooms: 1 No. Bed	
ot size: 3.39 Date lot recorded: 1988 Rig	ht of ways, easements, etc. Spri	ng K Well Shared Supply Public/Community
certify the above to be correct to the best of my knowledge. Permission is hall become void. I understand that it is my responsibility as the applicant	hereby granted to perform a site/soil evaluation on the property described above. If the informati /agent/owner to comply with all applicable ordinances, laws, and rules from other agencies that	on submitted in this application is falsified or changed, the permit may affect the development of this property.
pplicant/Agent Signature:	Date	»
	ON-SITE WASTEWATER DISPOSAL SYSTEM OPERATIONS PERMIT	
and that the system is capable of being operated in a Carolina and the rules adopted pursuant to this Articl	ne system described on the improvement permit and the construction occordance with the conditions of the improvement permit, Article 11 of e. This operation permit shall remain in effect as long as the system is Systems as issued by the North Carolina Department of Environment.	Chapter 130A of the General Statutes of North s operated and maintained as required by the
System Classification Type: ####################################	nt Entity: Owner Certified Operator Minimum inspection/	maintenance review frequency years.
Comments:		
	d on	
estalled by: Pro. What muse	Final Inspection by	10 Date: 7.28.97

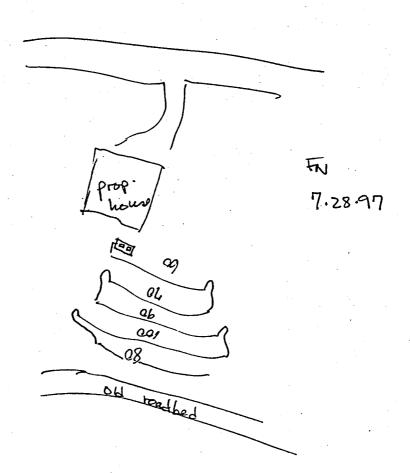

UN-811	FE WASTEWATED DISDOSAL ADDITOATION	
그러는 도로를 잘 하느라는 점점 뉴스를 맞고 하고 하는 듯한 살이 모음 그리고 있었다.	TE WASTEWATER DISPOSAL APPLICATION	Receipt No Lolo 5 (o
Permit #:	Mailing Address: 757 Cathoya Creek Chuch Rd.	
Agent/Owner: Linda T. Whitmire	Walling Address.	
Home Phone #: () 883-3867	Work Phone #: ()	Flood Zone Is the property in a flood zone?
Proposed Buyer:	Mailing Address:	Yes K No Unknown
Home Phone #: (Work Phone #: ()	Inspections
Property Location: Reynolds Woods Subdivision:	Reynods Woods Phase/Sect.: A	Lot #: Flood Zone
D 1/014	10° to Reynolds Woods go to top of Mtn. pro	operty Yes No
Directions to property.	to telephotes rooms to so est on ment to	
at the end		Initials Date
Installation for: Mobile Home Single Double House		
If Indust./Commercial/Other: Number of employees: Operation: (De	escribe) Property co	ontains designated wet lands: Yes No L
na 1866 - Marain Paris III an		化二甲基甲基甲基甲基甲基甲基甲基甲基甲基甲基甲基甲基甲基甲基甲基甲基甲基甲基甲基
Lot size: 3.39 Date lot recorded: 1988 Right of w	vays, easements, etc. GTAVEL <u>Water Supply</u> : Private	: Spring Well Shared Supply Public/Community
Lot size: 3.39 Date lot recorded: 1988 Right of w I certify the above to be correct to the best of my knowledge. Permission is hereby shall become void. I understand that it is my responsibility as the applicant/agent.	y granted to perform a site/soil evaluation on the property described above. If th	e information submitted in this application is falsified or changed, the permit
I certify the above to be correct to the best of my knowledge. Permission is hereby shall become void. I understand that it is my responsibility as the applicant/agent	y granted to perform a site/soil evaluation on the property described above. If the Nowner to comply with all applicable ordinances, laws, and rules from other age	e information submitted in this application is falsified or changed, the permit incies that may affect the development of this property.
I certify the above to be correct to the best of my knowledge. Permission is hereb	y granted to perform a site/soil evaluation on the property described above. If the Nowner to comply with all applicable ordinances, laws, and rules from other age	e information submitted in this application is falsified or changed, the permit
I certify the above to be correct to the best of my knowledge. Permission is hereby shall become void. I understand that it is my responsibility as the applicant/agent Applicant/Agent Signature: AUTHORIZ	y granted to perform a site/soil evaluation on the property described above. If the Mowner to comply with all applicable ordinances, laws, and rules from other age CATION FOR WASTEWATER SYSTEM CONSTRU (Diagram and Conditions Attached)	e information submitted in this application is falsified or changed, the permit encies that may affect the development of this property. Date: 17 - 30 - 76 CTION
I certify the above to be correct to the best of my knowledge. Permission is hereby shall become void. I understand that it is my responsibility as the applicant/agent. Applicant/Agent Signature: AUTHORIZ New Installation: Repair/Addition: Original Permittee:	y granted to perform a site/soil evaluation on the property described above. If the Mowner to comply with all applicable ordinances, laws, and rules from other age CATION FOR WASTEWATER SYSTEM CONSTRU (Diagram and Conditions Attached) Dated	e information submitted in this application is falsified or changed, the permit encies that may affect the development of this property. Date: \(\)
I certify the above to be correct to the best of my knowledge. Permission is hereby shall become void. I understand that it is my responsibility as the applicant/agent. Applicant/Agent Signature: AUTHORIZ New Installation: Repair/Addition: Original Permittee: Design waste flow: 36 O GPD LTAR: 45 Septic Tank Capacity: 4	y granted to perform a site/soil evaluation on the property described above. If the Nowner to comply with all applicable ordinances, laws, and rules from other age ZATION FOR WASTEWATER SYSTEM CONSTRU (Diagram and Conditions Attached) Dated	e information submitted in this application is falsified or changed, the permit encies that may affect the development of this property. Date: \(\)
I certify the above to be correct to the best of my knowledge. Permission is hereby shall become void. I understand that it is my responsibility as the applicant/agent. Applicant/Agent Signature: AUTHORIZ New Installation: Repair/Addition: Original Permittee:	y granted to perform a site/soil evaluation on the property described above. If the Nowner to comply with all applicable ordinances, laws, and rules from other age ZATION FOR WASTEWATER SYSTEM CONSTRU (Diagram and Conditions Attached) Dated	e information submitted in this application is falsified or changed, the permit encies that may affect the development of this property. Date: \(\)
I certify the above to be correct to the best of my knowledge. Permission is hereby shall become void. I understand that it is my responsibility as the applicant/agent. Applicant/Agent Signature: AUTHORIZ New Installation: Repair/Addition: Original Permittee: Design waste flow: Original Permittee: Design waste flow: Trench Length: Original Permittee: Trench Length: Original Permittee: Drainfield: Total Trench Length: Trench Length: Original Permittee: Drainfield: Total Trench Length:	y granted to perform a site/soil evaluation on the property described above. If the Nowner to comply with all applicable ordinances, laws, and rules from other age ZATION FOR WASTEWATER SYSTEM CONSTRU (Diagram and Conditions Attached) Dated	e information submitted in this application is falsified or changed, the permit encies that may affect the development of this property. Date: \(\)
I certify the above to be correct to the best of my knowledge. Permission is hereby shall become void. I understand that it is my responsibility as the applicant/agent. Applicant/Agent Signature: AUTHORIZ New Installation: Repair/Addition: Original Permittee: Design waste flow: 360 GPD LTAR: Septic Tank Capacity: Drainfield: Total Trench Length: Trency	y granted to perform a site/soil evaluation on the property described above. If the Wowner to comply with all applicable ordinances, laws, and rules from other age CATION FOR WASTEWATER SYSTEM CONSTRU (Diagram and Conditions Attached) Dated COCO gal./min. Pump Tank Capacity: gal./min. Proposed to spacing: ft. on ctr. Individual Trench Length: ft. Foundating system and nearest: Well: ft. Water line: ft. Foundating system and nearest: Well: ft. Water line: ft. Foundating system and nearest: Well: ft. Water line: ft. Foundating system and nearest: Well: ft. Water line: ft. Foundating system and nearest: Well: ft. Foundating system	e information submitted in this application is falsified or changed, the permit encies that may affect the development of this property. Date: \(\)

TRANSYLVANIA COUNTY HEALTH DEPARTMENT IMPROVEMENT PERMIT DIAGRAM

File Name:		Permit	No.: Pin	No.:	
			1	11	•
			1		
_comments			1	1	
1) Individual line	Jena His	mau de L	pried		
			l l		
to keep syste	n og <i>konto</i> k	A.	t		
2)Maximum Frei	ned death	9/0			
		.	(
must <u>ree</u> t Le v	exceeded.	2 N 3 N		1 1	
a House site mou	1/2005	8		r	
be repositional	6			i T	
Acheire groundy 1/1					
		43			
Systen regulars		4		7	
(a" Additional books		Lega	1 1/6		
			1 1		
	YV		7	48	
		اے اِل			
		1	N A		
	19		N.		
			88		
	y , , ,				
	3 3	v- se 30,800 b .	12		$\sqrt{2}$
λ	ja /				
			١٠٠١		
		1.3000	3		
	1 1 2 0 0 0	7	Scale l":	ft.	