

TRANSLYVANIA COUNTY HEALTH DEPARTMENT

Existing System Inspection Report

(For Building Inspection Department)

Date: 2-17-10

Tax ID No.: 8572-87-7248-000

Receipt No.: 788030 \$75.00

Owner/Agent: Jones, Virginia A Roger & Virginia Hein

885-8366

Address: 547 Dvdisdi Court 2827 Røverview Road

Brevard Macon, GA

Phone Number: Contact: Mike Krauter 421-5768

Date System Installed: 12-12-79

Original Cert. of Completion	
Name:	"Fordco Spec"
Date:	12-12-79

Name(s) of Original Permittee: "Fordco Spec"

Directions to property: 276S; R into main gate of Connestee Falls; Continue on Connestee Trail to R on Ugugu; L in Dvdisdi Court - almost to end; House on L

Subdivision Connestee Falls

Section: 23

Lot No.: 17

Inspection requested for:

- Mobile home setup
- Addition
- Business
- Remodeling
- Connection to unused system
- Other

No. of bedrooms upon connection/completion: Same

Current no. of Bedrooms: #3

Remarks: adding a den - no plumbing

Owner/Agent Signature: [Signature]

Date: 2-17-10


FORM KEPT ON FILE FOR ONE YEAR

At the time of the inspection there was no visible evidence of a malfunction in the system. The system is approved for proposed connections/additions/renovations or other improvements.

Signed: [Signature] REHSI

Date: 2-19-10

THIS REPORT IS VALID THROUGH 5-19-10

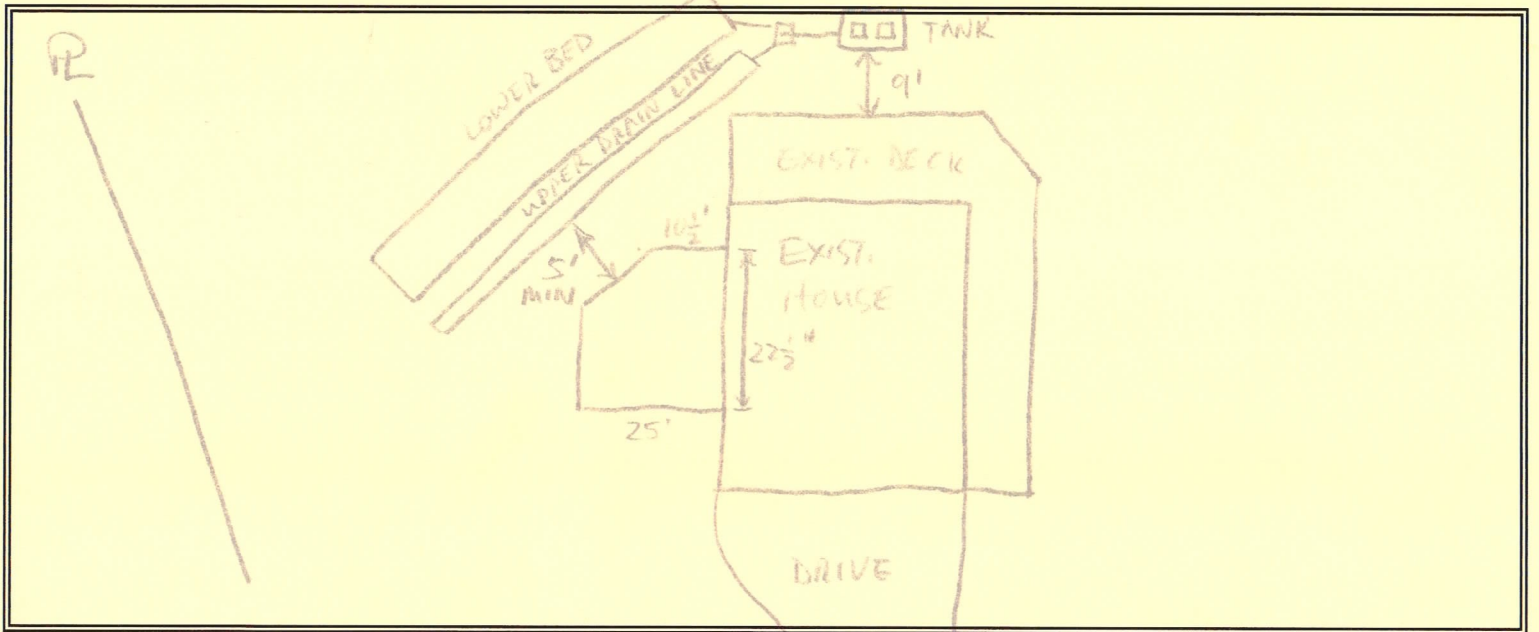


TRANSYLVANIA COUNTY HEALTH DEPARTMENT

(Sewage disposal system) Improvements Permit and Certificate of Completion


(Ground Absorption Sewage Disposal System - Section 130 - 160 of Chapter 130 of the General Statutes of North Carolina)

OWNER-OCCURANT Fordco "Spec" BUILDING CONTRACTOR same
LOCATION Dixie Court -> part 2nd house on left
SUBDIVISION Conestee Falls LOT NO. 17 SECT. OR BLOCK NO. 23
SEPTIC TANK CONTRACTOR WORLD ADDRESS Brevard, NC

HOUSE MOBILE HOME BUSINESS
NO. BEDROOMS 3 NO. BATHROOMS 2
SIZE OF SEPTIC TANK 855 GALS. (Liquid)
MATERIAL: PRE-CAST BLOCK FIBERGLASS
DISTRIBUTION BOX YES NO
NO. OF LINES 3 WIDTH 3 FT. LENGTH 70 FT.
PERCOLATION TEST YES NO
WATER SUPPLY: INDIVIDUAL PUBLIC
SITE CLASSIFICATION: SUITABLE
PROV. SUITABLE
UNSUITABLE

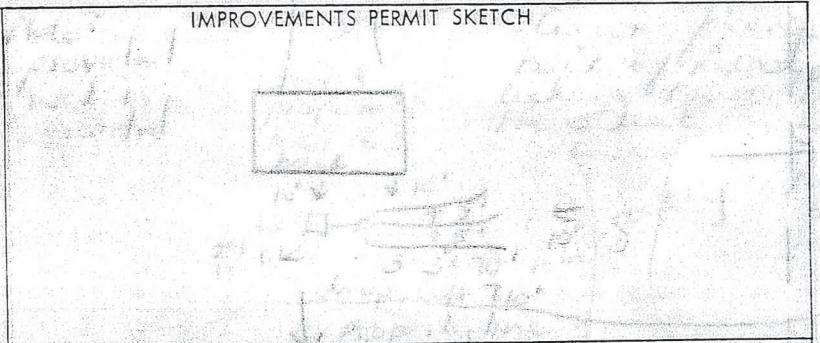

IMPROVEMENTS PERMIT: DATE: 12-12-79
BY: [Signature]
CERTIFICATE OF COMPLETION: DATE: 12-12-79
BY: [Signature]

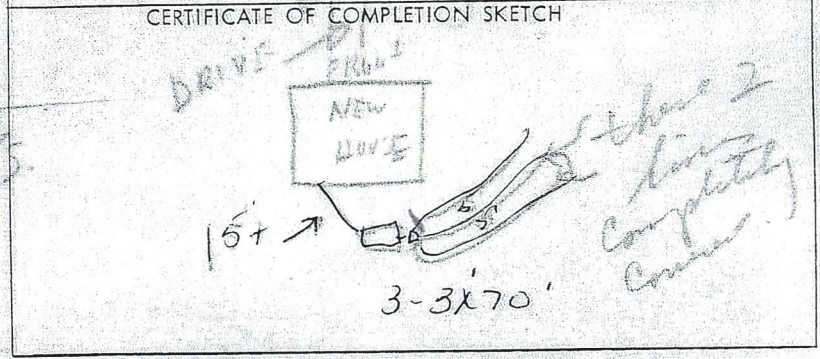

NOTICE: System installed according to Rules and Regulations but not a guarantee that it will function satisfactorily for any given period of time.
COLOR CODE: White - Owner; Pink - Improvements Permit; Blue - Contractor; Yellow - Inspection Dept.; Green - Health Dept.

Hein, Roger

PIN # 8572877248000

Transylvania County Health Department
ENVIRONMENTAL HEALTH SECTION

James A. Boyer, R.S.
Environmental Health Supervisor

203 East Morgan St.
Community Services Bldg.
Brevard, NC 28712
Phone (828) 884-3139
FAX (828) 884-3140



adding a den
no plumbing.