

TRANSYLVANIA COUNTY DEPARTMENT of PUBLIC HEALTH

Existing System Inspection Report (For Building Inspection Department)

Date: 9-3-15 Tax ID No.: 8595-76-9868-000

Receipt No.: 730048
\$ 75⁰⁰

Owner/Agent: William D. Clarke, III

Address: 55 Covered Bridge Lane
Pisgah Forest, NC 28768

Phone Number: 885-5555

Date System Installed: 7-18-06

Name(s) of Original Permittee: William Clarke

Directions to property: Williamson Creek Road .9 mi: L on Community Center Road:

Immediate L onto Covered Bridge Lane: 1st house on L # 55 on house

Subdivision: _____ Section: _____ Lot No.: 2

Inspection requested for:

- ☐ Mobile home setup
☐ Remodeling

- ☒ Addition
☐ Connection to unused system

- ☐ Business
☐ Other

No. of bedrooms upon connection/completion: 3 Current no. of Bedrooms: 3


Remarks: Add a pantry off the dining room.

Owner/Agent Signature: X William D Clarke III Date: X 9/3/15

At the time of the inspection there was no visible evidence of a malfunction in the system. The system is approved for proposed connections/additions/renovations or other improvements.

Signed: James A Bayer, REHS Date: 9/8/15

THIS REPORT IS VALID THROUGH 12/8/15

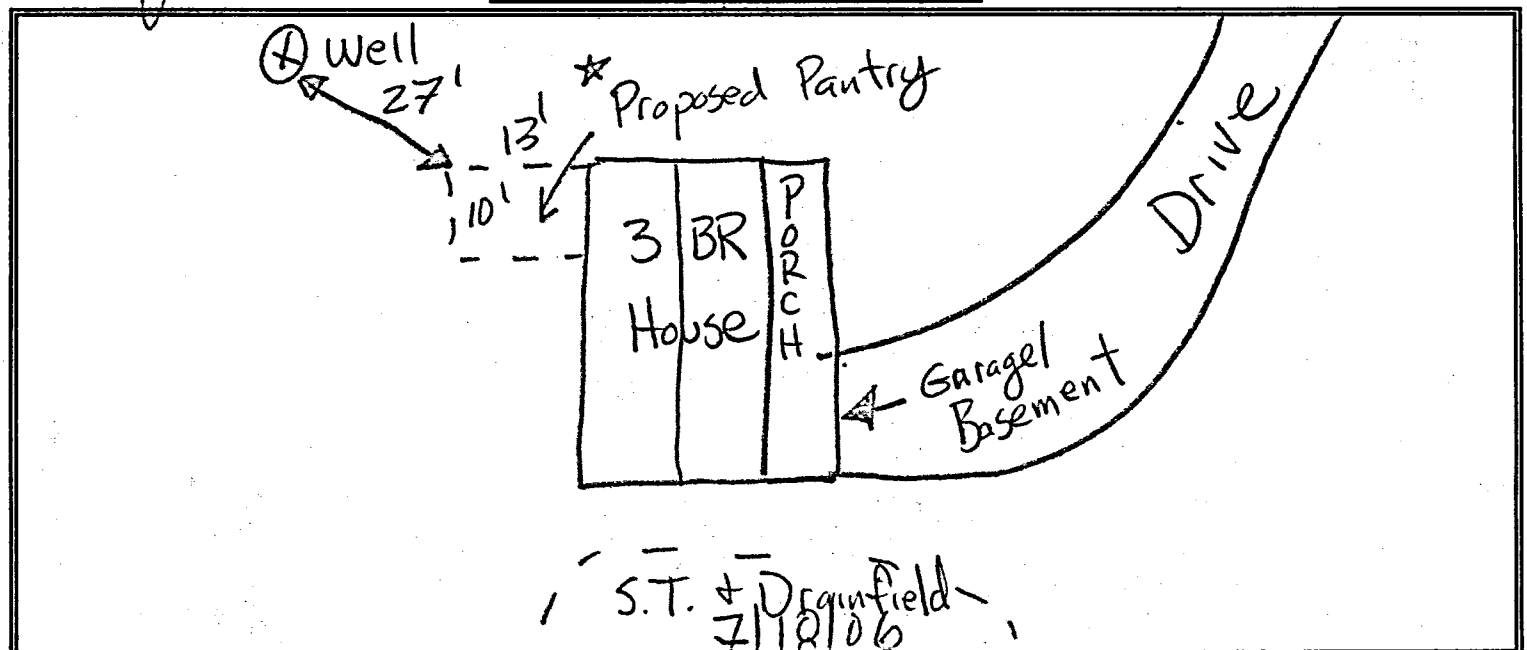

File Name: _____

**TRANSYLVANIA COUNTY HEALTH DEPARTMENT
ON-SITE WASTEWATER DISPOSAL APPLICATION**

8395-88-1521-000

Permit #: 04-117

Clark, William - new Owner

Pin #/Tax ID

8395-16-9868.000

Agent/Owner: JOE BRISON

Mailing Address: 308 Elm Bend Rd. Brevard, NC

Receipt No

2015

Home Phone #: () _____

Work Phone #: () _____

883-2064 877-3525

Proposed Buyer: HERBILL, RAYMOND

Mailing Address: Rt. 1 Box 152-A Penrose, NC 28766

Home Phone #: () _____

Work Phone #: () _____

Lot 2

Property Location: Williamson Cr. Rd.

Subdivision: _____

Phase/Sec.: _____

Lot #: _____

Road/Street

Williamson Cr. Rd. - turn left at community center - prop on left

Directions to property: _____

Flood Zone

Is the property in a flood zone?

☐ Yes ☐ No ☐ Unknown

Inspections

Flood Zone

☐ Yes ☐ No

☐ Approved ☐ Disapproved

Initials _____ Date _____

Installation for: Mobile Home ☐ Single ☐ Double ☐ House ☒ No. Bedrooms: 3 Basement: Yes ☐ No ☐ With Plumbing: Yes ☒ No ☐ Ind./Commercial ☐ Other ☐

If Indust./Commercial/Other: Number of employees: _____ Operation: (Describe) _____ Property contains designated wet lands: Yes ☐ No ☐

Lot size: 1-2 ac Date lot recorded: _____ Right of ways, easements, etc. no Water Supply: Private: ☐ Spring ☐ Well ☐ Shared Supply ☐ Public/Community

I certify the above to be correct to the best of my knowledge. Permission is hereby granted to perform a site/soil evaluation on the property described above. If the information submitted in this application is falsified or changed, the permit shall become void. I understand that it is my responsibility as the applicant/agent/owner to comply with all applicable ordinances, laws, and rules from other agencies that may affect the development of this property.

Applicant/Agent Signature: _____

Date: _____

**ON-SITE WASTEWATER DISPOSAL SYSTEM
OPERATIONS PERMIT**

Notice:

**Well must be located at least
100 ft. from any part of the
septic system.**

The issuance of this operations permit certifies that the system described on the improvement permit and the construction authorization is properly installed or repaired and that the system is capable of being operated in accordance with the conditions of the improvement permit, Article 11 of Chapter 130A of the General Statutes of North Carolina and the rules adopted pursuant to this Article. This operation permit shall remain in effect as long as the system is operated and maintained as required by the Laws and Rules for Sewage Treatment and Disposal Systems as issued by the North Carolina Department of Environment and Natural Resources, Division of Environmental Health.

System Classification Type: IIIg/IIa EZ FLOW w/ warranty Management Entity: ☒ Owner ☐ Certified Operator Minimum inspection/maintenance review frequency N/A years.

Comments: Clean & replace septic tank effluent filter as req'd

Installed by: Marshall McCall

Final Inspection by: James A Bayer, RS Date: 7/18/06

