



IMPROVEMENT PERMIT

Madison County Health Department
493 Medical Park Drive

Marshall NC 28753
Phone: 828-649-9598 Fax: 828-649-9370

For Office Use Only

*CDP File Number 277713 - 1

County ID Number: 9727-53-2272

Evaluated For: **NEW**

Township:

PERMIT VALID UNTIL: 5/16/2024

***NOTE TO INSPECTIONS DIVISION: Building Permits cannot be issued with this Improvement Permit.**

Applicant: James Thompson
Address: 139 S. Halewood Road
City: Marshall
State/Zip: NC 28753
Phone #: (941) 773-6670

Property Owner: James Thompson
Address: 139 S. Halewood Road
City: Marshall
State/Zip: NC 28753
Phone #: (941) 773-6670

Property Location & Site Information

Address/Road #: James Thompson
Subdivision: Marshall NC 28753
Phase: Lot:

Directions

213E towards Mars Hill, take left turn onto S. Halewood Road

Structure: MOBILE HOME
of Bedrooms: 2
of People: 0
*Water Supply: NEW WELL

System Specifications

Initial System

*Site Classification: Provisionally Suitable

Saprolite System? Yes No

Design Flow: 4 8 0

Soil Application Rate: 0 . 4

*System Classification/Description:
TYPE III G. OTHER NON-CONV. TRENCH SYSTEMS

*Proposed System: 25% REDUCTION

Minimum Trench Depth: 1 8 Inches

Maximum Trench Depth: 2 4 Inches

Septic Tank: 1 0 0 0 Gallons

1-Piece: Yes No

Pump Required: Yes No May Be Required

Pump Tank: _____ Gallons

1-Piece: Yes No

Repair System Required: Yes No No, but has Available Space

Repair System

*Site Classification: Provisionally Suitable

Soil Application Rate: 0 . 4

*System Classification/Description:
TYPE III G. OTHER NON-CONV. TRENCH SYSTEMS

*Proposed System: 25% REDUCTION

Minimum Trench Depth: 1 8 Inches

Maximum Trench Depth: 2 4 Inches

Pump Required: Yes No May be Required

***Site Modifications**

Open Fill Sheet

No grading or construction activity is allowed in areas designated for system and repair without approval of Health Department.

Characters Remaining
750

***Permit Conditions**

The issuance of this permit by the Health Department in no way guarantees the issuance of other permits. The permit holder is responsible for checking with appropriate governing bodies in meeting their requirements.

Prior to any construction, all driveways, structures and modifications to topography must be presented in an application for construction authorization.

Characters Remaining
599

Site Plan

The Improvement Permit shall be valid for 5 years from date of issue with a site plan (means a drawing not necessarily drawn to scale that shows the existing and proposed property lines with dimensions, the location of the facility and appurtenances, the site for the proposed Wastewater system, and the location of water supplies and surface waters).

Plat

The Improvement Permit shall be valid without expiration with plat (means a property surveyed prepared by a registered land surveyor, drawn to a scale of one inch equals no more than 60 feet, that includes: the specific location of the proposed facility and appurtenances, the site for the proposed Wastewater system, and the location of water supplies and surface waters. Plat also means, for subdivision lots approved by the local planning authority and recorded with the county register of deeds, a copy of the recorded subdivisions plat that is accompanied by a site plan that is drawn to scale).

The Department and Local Health Department may impose conditions on the issuance and may revoke the permits for failure of the system to satisfy the conditions, the rules, or this article. This permit is subject to revocation if the site plan, plat, or intended use changes (NCGS 130A-335(f)). The person owning or controlling the system shall be responsible for assuring compliance with the laws, rules, and permit conditions regarding system location, installation, operation, maintenance, monitoring, reporting, and repair (.1938(b)).

Applicant/Legal Reps. Signature Required? Yes No

Applicant/Legal Reps. Signature: _____ Date: ____ / ____ / ____

*Issued By: 1408 - LIST, JAMIE _____ Date of Issue: 05 / 16 / 2019

Authorized State Agent: _____

Valid without Expiration?
 Create CA?


Hand Drawing Import Drawing

****Site Plan/Drawing attached.****



Drawing Drawing Type: Improvement Permit

Scale: Inch Block N/A = _____ ft.

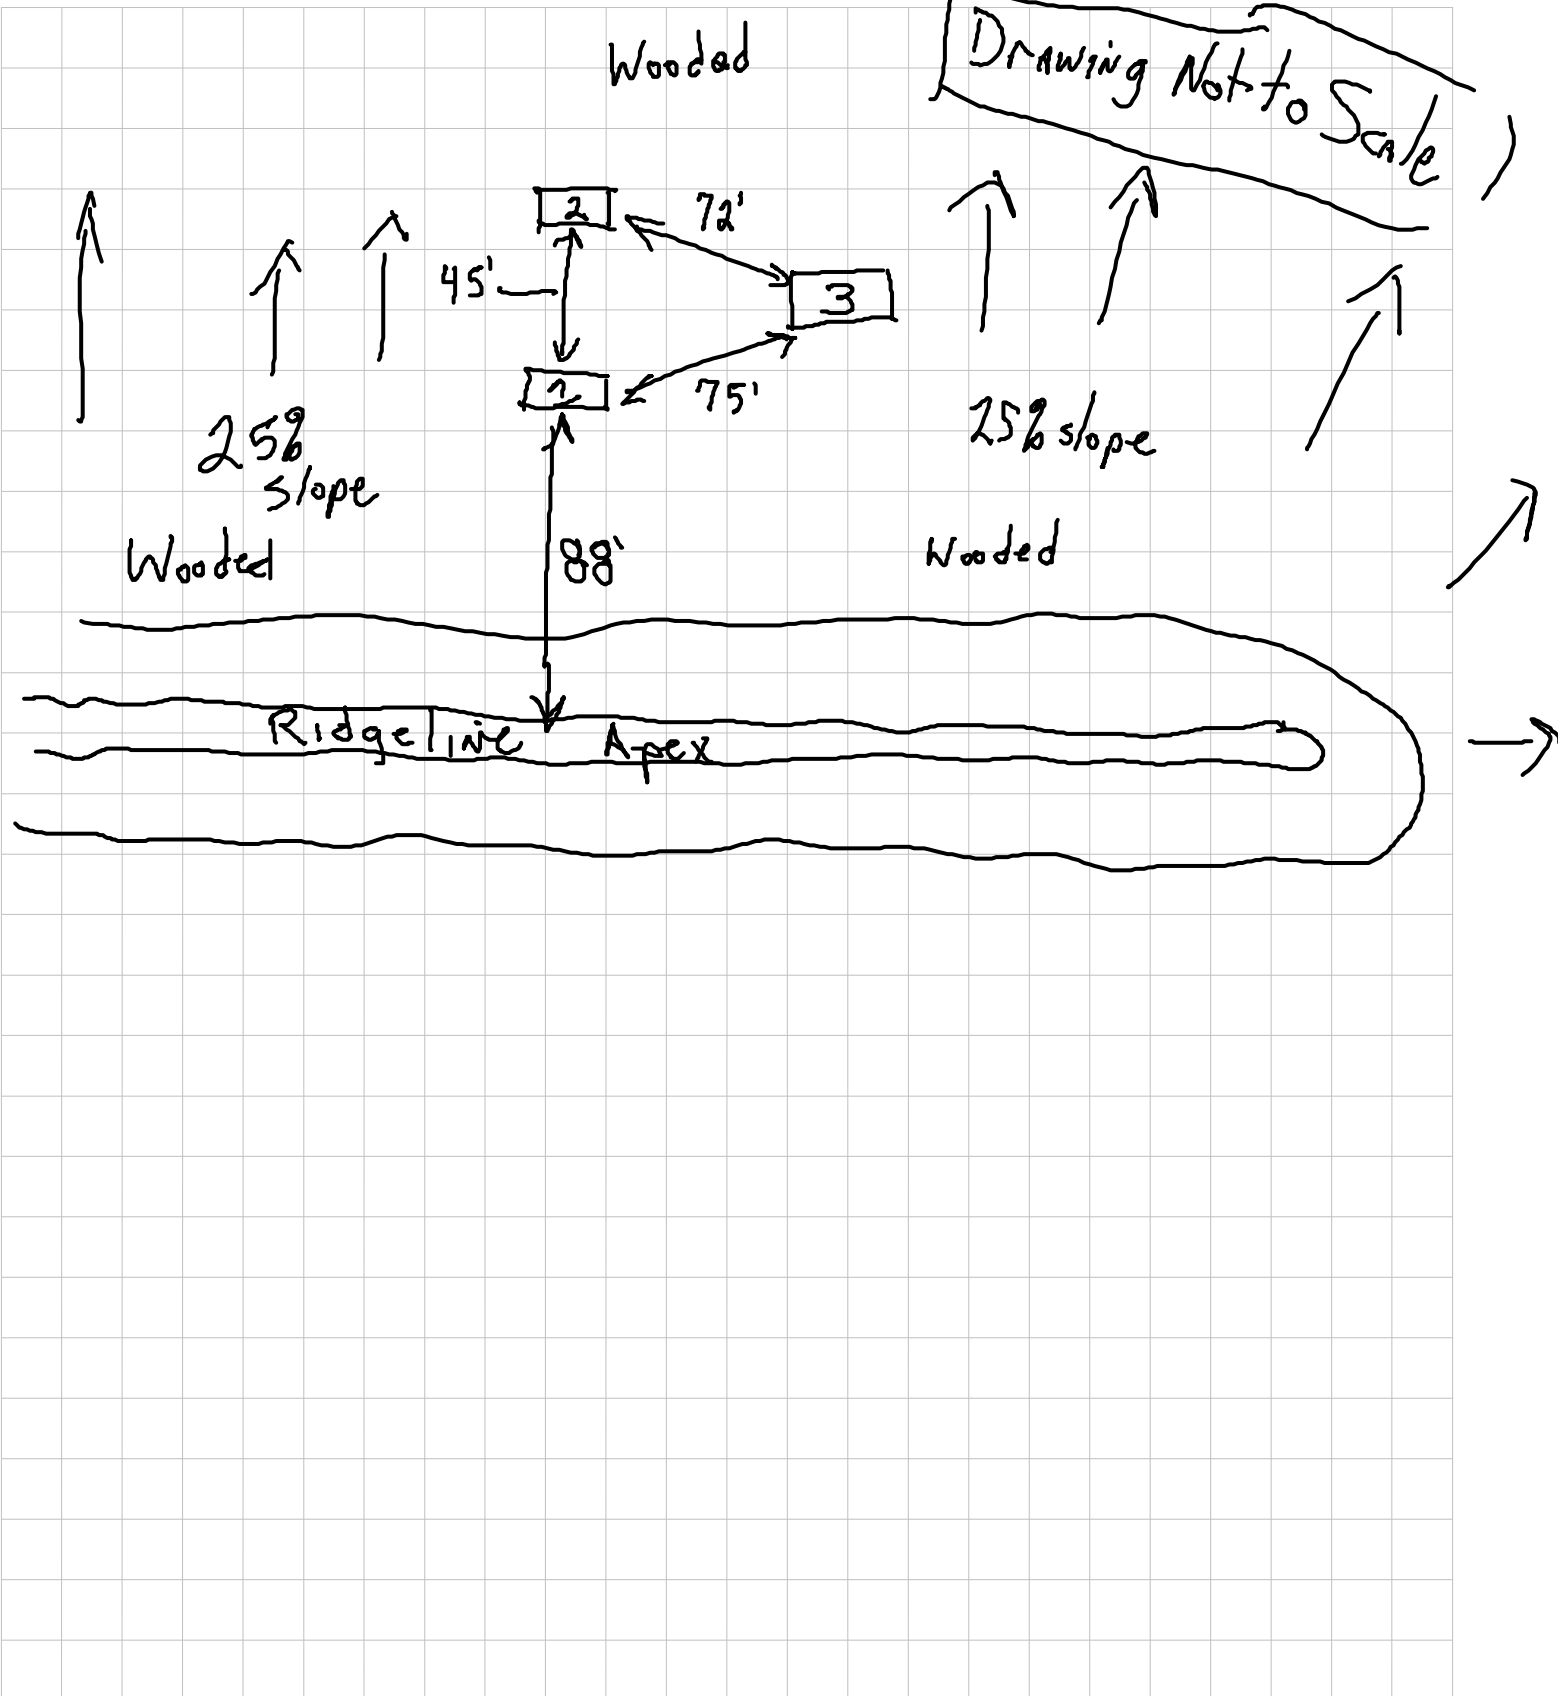

IMPROVEMENT PERMIT
Madison County Health Department
493 Medical Park Drive

CDP File Number: 277713 - 1

County File Number: 9727-53-2272

Marshall NC 28753

Date: 05 / 16 / 2019

Click below to import an image from an external location: Drawing Type: Improvement Permit