


SECOND FLOOR

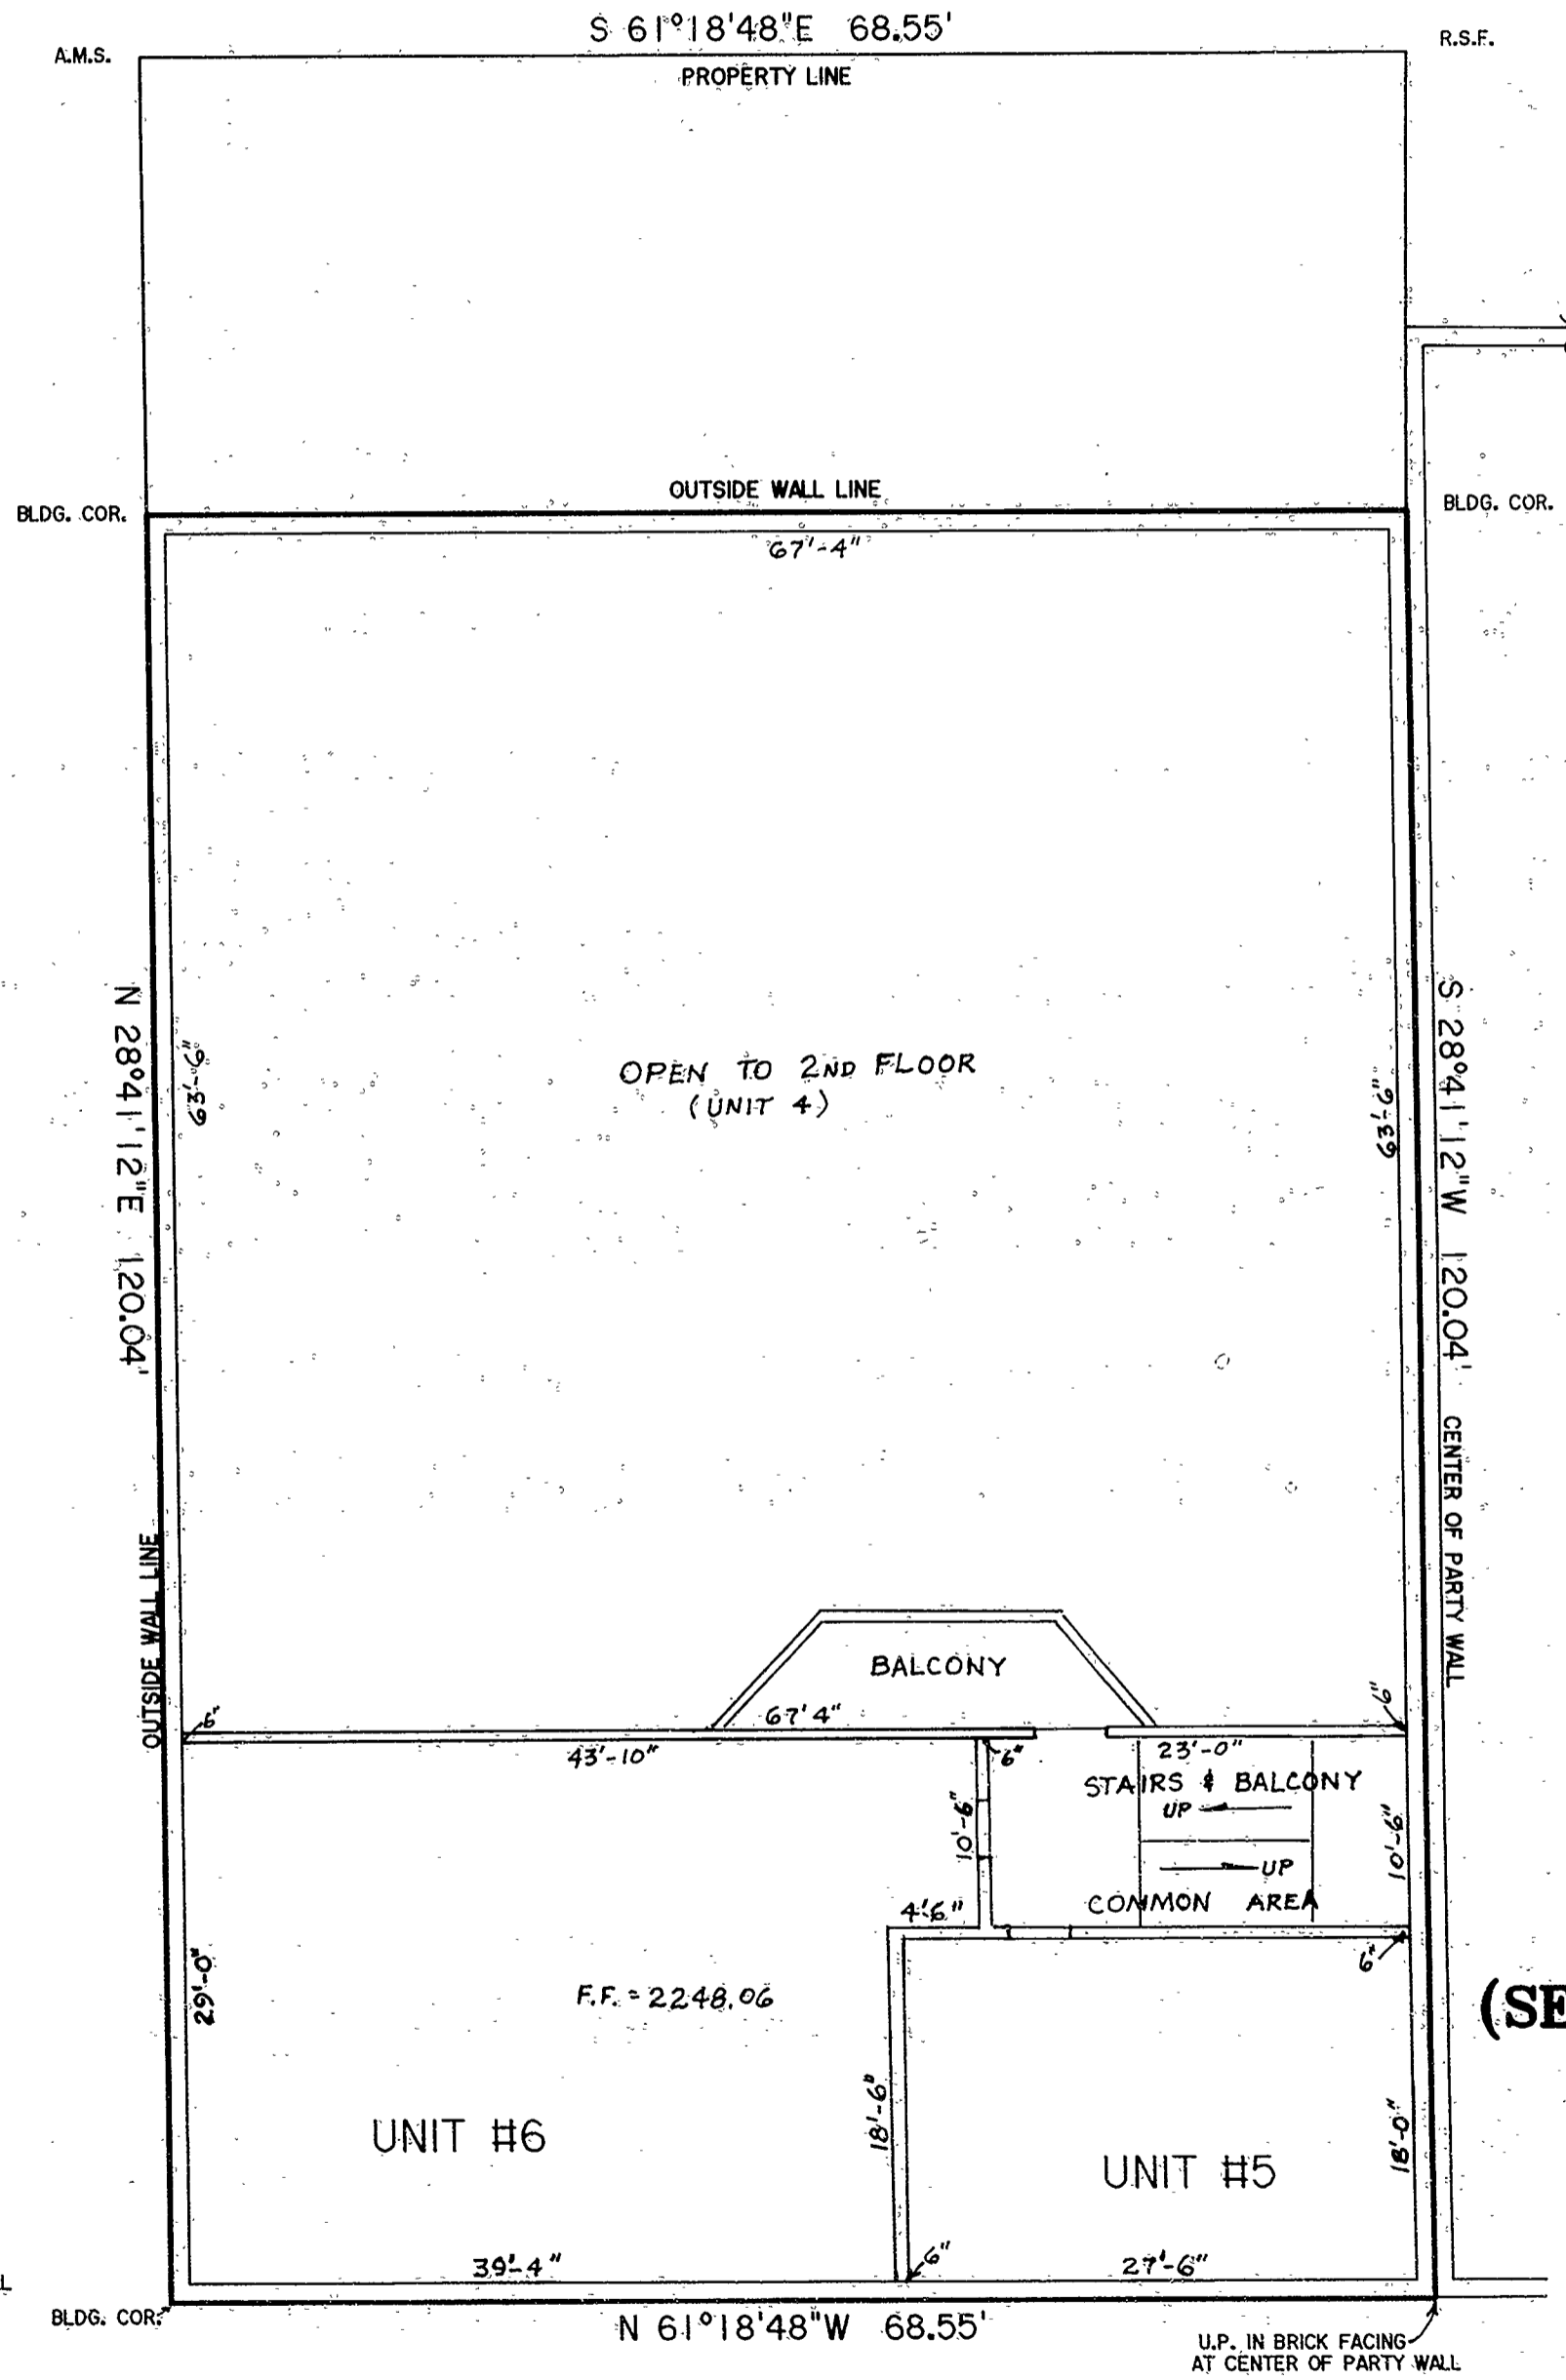

THIRD FLOOR

Filed for registration on the 30 day of March 2001 at 9:00 o'clock A.M. and registered and verified on the 30 day of March 2001 in Book No. 1169 of page Slide 129.
John H. Scales
 Register of Deeds, Transylvania County
Bo. Figs & Sons Deputy

CARRIER BUILDING CONDOMINIUMS

UNITS 3-6
(SECOND & THIRD FLOORS)
BREVARD TOWNSHIP
TRANSYLVANIA COUNTY
NORTH CAROLINA

GENE PARKER LAND SURVEYS

43 TARKILN MTN. DRIVE
HORSE SHOE, N.C. --28742--(828) 891-8373

DATE : MARCH 5, 2001	SCALE : 1" = 10'	DRAWING NO. : 01-013B-B1
TAX PIN # : 8585(.19)-51-0164		