

TRANSYLVANIA COUNTY DEPARTMENT of PUBLIC HEALTH

Existing System Inspection Report
(For Building Inspection Department)

Date: 4-13-11

Tax ID No.: 9505-40-6335-000

Receipt No.: 126507

Owner/Agent: Woolley, Lee & Jodas

\$7500

Address: 34 Sylvan Byway

Pisgah Forest, NC 28768

Original Cert. of Completion

Phone Number: Andrew Brynard 243-638899

Name: Jeff Portman

Date System Installed: Joda - 577-9538

Date: 12-9-1981

Name(s) of Original Permittee: PORTMAN, JEFF

Directions to property: Wilson Road; R on Williamson Creek Road to Cherrywood Lane; (R turn) to Sylvan Habitat; House on corner of Cherrywood and Sylvan Habitat; House has a flat roof

Subdivision: Sylvan Habitat

Section: 1

Lot No.: 9

Inspection requested for:

- Mobile home setup
 Remodeling

- Addition
 Connection to unused system

- Business
 Other

No. of bedrooms upon connection/completion: 3

Current no. of Bedrooms: 3

Remarks: Addition to Guest House Garage w/office

FORM KEPT ON FILE FOR ONE YEAR

Owner/Agent Signature: [Signature]


Date: 4-13-11

At the time of the inspection there was no visible evidence of a malfunction in the system. The system is approved for proposed connections/additions/renovations or other improvements.

Signed: James A. Bayer, REHS

Date: 6/30/11

THIS REPORT IS VALID THROUGH 9/30/11

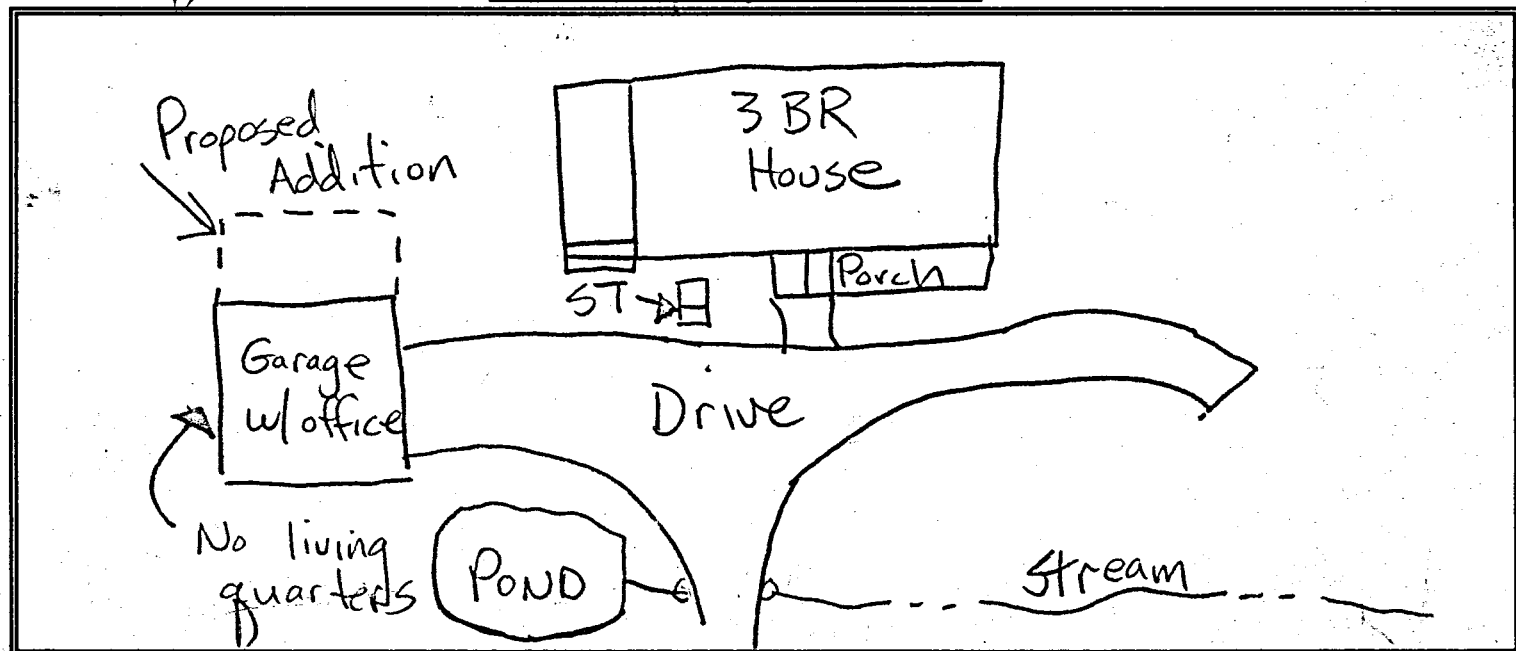

TRANSYLVANIA COUNTY HEALTH DEPARTMENT

Existing System Inspection Report

(For Building Inspection Department)

Date: 11-19-07

Tax ID No.: 9505-40-6335-000

Receipt No.: 032464 50

Owner/Agent: Woolley, Lee & Joda

Address: 1624 S 21 St St #2 Colorado Springs, CO 80904

Old Add 158 Cherrywood Lane New Add - 34 Sylvan Byway

Phone Number: 828-577-9538 - Joda - call her when going out.

Date System Installed: house built in 1979 per current owner.

Name(s) of Original Permittee:

Directions to property: Hwy. 276 S. to Park Ave. t/l onto Wilson Road; t/r onto

Williamson Creek Rd.; to to Cherrywood Ln. (right turn) and then to Sylvan Habitat; house in on the corner of Cherrywood and Sylvan Habitat; house has a rlat road, grayish tan in color.

Subdivision: Sylvan Habitat Section: 1 Lot No.: 9

Inspection requested for:

- Mobile home setup, Remodeling, Addition, Connection to unused system, Business, Other

No. of bedrooms upon connection/completion: Current no. of Bedrooms:


Remarks: slight extension of footprint to connect two parts of existing house

Owner/Agent Signature: Joda Woolley Date: 11/19/2007

At the time of the inspection there was no visible evidence of a malfunction in the system. The system is approved for proposed connections/additions/renovations/ or other improvements.

Signed: Alla Smith MS, PS Date: 12/5/2007 11-19-07

THIS REPORT IS VALID THROUGH 3/5/2008

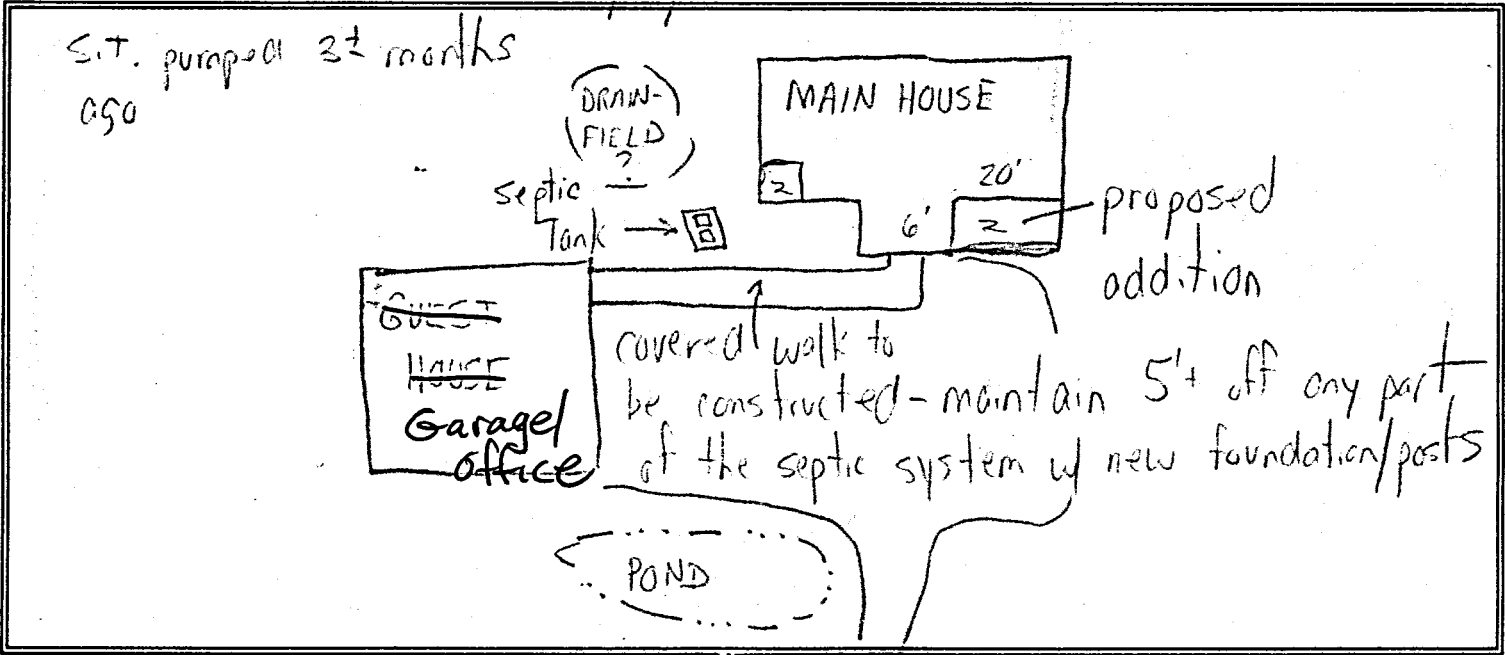

TRANSYLVANIA COUNTY HEALTH DEPARTMENT

(Sewage disposal system) Improvements Permit and Certificate of Completion

(Ground Absorption Sewage Disposal System - Section 130 - 160 of Chapter 130 of the General Statutes of North Carolina)

OWNER-OCCUPANT Moore BUILDING CONTRACTOR formally D.C. Dill Home - old system installed in 1975
 LOCATION Walnut Hollow → 1st left off Girl Scout Camp Rd
 SUBDIVISION _____ LOT NO. _____ SECT. OR BLOCK NO. _____

SEPTIC TANK CONTRACTOR Will Jager ADDRESS _____
 HOUSE MOBILE HOME BUSINESS
 NO. BEDROOMS 3 NO. BATHROOMS 2
 SIZE OF SEPTIC TANK 800 GALS. (Liquid) _____


MATERIAL: PRE-CAST BLOCK FIBERGLASS
 DISTRIBUTION BOX YES NO
 NO. OF LINES 3 WIDTH 4 FT. LENGTH 50 FT.
 PERCOLATION TEST YES NO

WATER SUPPLY: INDIVIDUAL PUBLIC
 SITE CLASSIFICATION: SUITABLE
 PROV. SUITABLE
 UNSUITABLE

IMPROVEMENTS PERMIT: DATE: _____
 BY: _____
 CERTIFICATE OF COMPLETION: DATE: 12-11-81
 BY: _____

NOTICE: System installed according to Rules and Regulations but not a guarantee that it will function satisfactorily for any given period of time.

COLOR CODE: White - Owner; Pink - Improvements Permit; Blue - Contractor; Yellow - Inspection Dept.; Green - Health Dept.

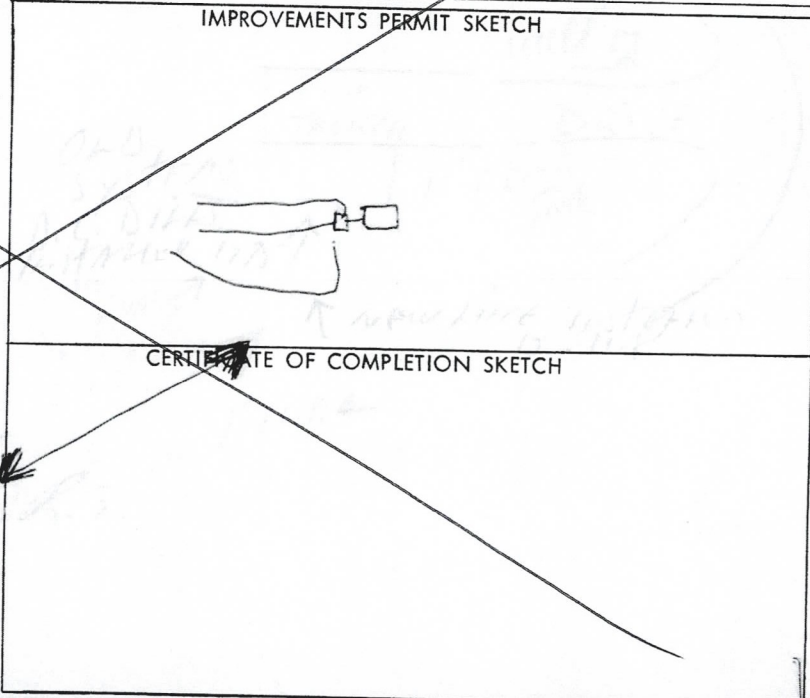

TRANSYLVANIA COUNTY HEALTH DEPARTMENT

(Sewage disposal system) Improvements Permit and Certificate of Completion

(Ground Absorption Sewage Disposal System - Section 130 - 160 of Chapter 130 of the General Statutes of North Carolina)

OWNER-OCCUPANT Jeff Portman BUILDING CONTRACTOR self
 LOCATION Amson Creek → 2nd entrance to Sweetwater → end of
 SUBDIVISION Honey Brook LOT NO. 9 SECT. OR BLOCK NO. rd on left
 SEPTIC TANK CONTRACTOR Allison Ditching ADDRESS _____

HOUSE MOBILE HOME BUSINESS
 NO. BEDROOMS 3 NO. BATHROOMS 3
 SIZE OF SEPTIC TANK 855 GALS. (Liquid) _____

MATERIAL: PRE-CAST BLOCK FIBERGLASS
 DISTRIBUTION BOX YES NO
 NO. OF LINES 3 WIDTH 3 FT. LENGTH 70 FT.
 PERCOLATION TEST YES NO 50

WATER SUPPLY: INDIVIDUAL PUBLIC
 SITE CLASSIFICATION: SUITABLE ?
 PROV. SUITABLE
 UNSUITABLE

IMPROVEMENTS PERMIT: DATE: _____
 BY: _____
 CERTIFICATE OF COMPLETION: DATE: 12-9-81
 BY: _____

NOTICE: System installed according to Rules and Regulations but not a guarantee that it will function satisfactorily for any given period of time.

COLOR CODE: White - Owner; Pink - Improvements Permit; Blue - Contractor; Yellow - Inspection Dept.; Green - Health Dept.

