


97-20487

Buncombe County Health Department  
Environmental Health Services (704-255-5691)  
Operations Permit

Property Owner: Tammy Riels Application Date: 7-15-96  
Mailing Address: 24 Shamrock Ln Fairview (Flatler) NC  
Property Address: \_\_\_\_\_  
Property Location: 746 - R Cove Creek - L Brush Creek TR Upper Brush Creek  
Contractor/Inst: Ken Lane Lot#: 1 PIN#: 968519405734  
Subdivision: The Knolls Water Supply: Municipal Well  (Shared)  Individual  In Place  (Y or N) OTHER \_\_\_\_\_

SECTION ONE: Design Flow: GPD: 480 Type of System: chamber LTAR: .40  
Septic Tank: Concrete:  Other: \_\_\_\_\_ Liquid Capacity: 1250  
Drainfield: # of Trenches: 3 Trench Length: see below Trench Width: 3  
Spacing (cc): 9' Gravel Depth: 0  
Distribution: Equal  Serial  Dams/Steps Down: NA Pump NA Alarm \_\_\_\_\_  
Pump Tank Cap: \_\_\_\_\_ Pump Switches: NA Dosing Rate \_\_\_\_\_ Valves \_\_\_\_\_  
System Classification: AI II III IV V VI Minimum Insp/Maintenance Frequency \_\_\_\_\_  
Systems classified as IV, V and VI must have a copy of the Management Entity Agreement attached.

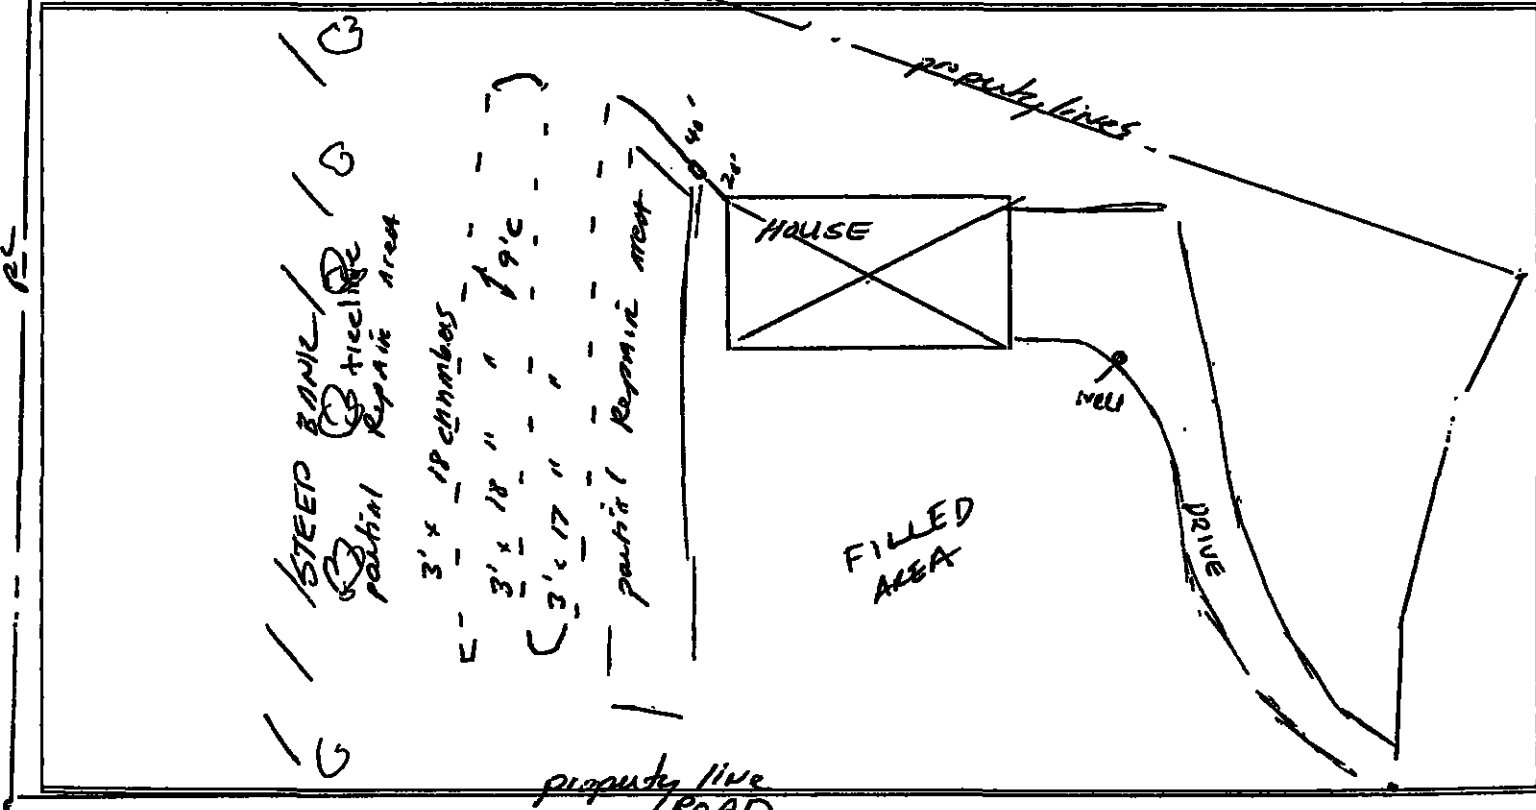

SECTION TWO: System Designed For: Residence  Mobile \_\_\_\_\_ Perm. \_\_\_\_\_ Number of bedrooms/per unit: 4  
Basement (s): Yes  No \_\_\_\_\_ New \_\_\_\_\_ Repair \_\_\_\_\_  
M.H. Width: Single \_\_\_\_\_ Double \_\_\_\_\_ Basement Plumbing: Yes  No \_\_\_\_\_  
Units: Single \_\_\_\_\_ Multiple \_\_\_\_\_  
No. of Units \_\_\_\_\_ No. of Units in Phase: \_\_\_\_\_  
M.H. Park: \_\_\_\_\_ Phase of Park: \_\_\_\_\_ Industrial Waste: Yes \_\_\_\_\_ No \_\_\_\_\_  
Busn./Industrial: \_\_\_\_\_ No. Employees: \_\_\_\_\_  
Other \_\_\_\_\_

If Industrial Waste is "Yes", a Copy of State Review and Approval Must Be Attached.  
Comments: \_\_\_\_\_  
\_\_\_\_\_

More detailed drawing, plans, conditions, etc. attached? Yes \_\_\_\_\_ No \_\_\_\_\_

Final approval of the system shall indicate that the system has been installed in accordance with State Regulations, but in no way should be taken as a guarantee that the system will function satisfactory for any given time.

VOID IF NOT IN COMPLIANCE WITH LAND USE REGULATIONS  
PLEASE CONTACT BUNCOMBE COUNTY ZONING - (704) 255-5777

Inspected by: Wayne Jordan Date: 1-28-97  
Owner/Agent: Ken Lane Date: 1-28-97