

TRANSYLVANIA COUNTY HEALTH DEPARTMENT

(Sewage Disposal System) Improvements Permit and Certificate of Completion Sewage Treatment and Disposal Rules (ARTICLE 1 of CHAPTER 130A OF THE GENERAL STATUTES OF NORTH CAROLINA)

687

APPLICATION FOR:

FEES:

Improvements Permit 8595-44-6239-000 Paid \$ 25⁰⁰ Date 4/22/87 Initials JW
 Lot Evaluation _____
 Sub-Division Evaluation _____
 Mobile Home Park Evaluation _____

Owner-Occupant Marsha Bryson Address Mtn. Glen Apts, Brevard
 Location of Property Knob Creek 3 m. N. Knish Rd to top of hill left on Laurel Ridge Rd → left on Honesuckle Ridge → 700 ft on left
 Plat of Property: Yes No _____ Phone No. 884-56233
 Type of Facility: House ; Mobile Home _____ ; Business _____ ; No. Bedrooms 2 ; No. Baths 1
 Estimated Sewage Flow: 240 Gals. Per Day: Has Any Grading Been Done On Property? Yes _____ No
 Type of Water Supply: Drilled Well _____ ; Spring _____ ; Individual _____ ; Community ; Public _____
 Are There Any Easements Or Right-of-Ways On This Property? Yes _____ ; No
 SIGNATURE OF OWNER OR AUTHORIZED AGENT: _____ DATE: _____

IMPROVEMENTS PERMIT AND CERTIFICATE OF COMPLETION

Owner-Occupant Sam &
 Location Sam &
 Subdivision Knob Creek
 Lot No. 15 Sect. of Block No. _____
 Building Contractor Michael Lipp
 Address P.O. Box 171 Saphire, N.C. 28774
 Septic Tank Contractor William Salloway
 Address Dalson NC
 Sewage Disposal System For: 0
 New Existing/Repair _____
 Addition/Renovation _____
 Mobile Home Relocation _____
 Size of Septic Tank 1000 Gals. (Liquid)
 Material: Pre-Cast Block _____ Fiberglass _____
 Distribution Box: Yes No _____
 No. of Lines: 2 ; Width 2 Ft. ; Length 70 Ft.
 (Maximum Depth of Trench) 18 (inches)
 Site Classification:
 Suitable _____ Provisionally Suitable
 Unsuitable _____
 Do You Anticipate Any Additions To Proposed Building? Yes _____ No


NOTE: There Are To Be No Changes In Above Lay-Out Without Permission Of Health Department Representative.

IMPROVEMENTS PERMIT: DATE 4/27/87
 By Jm. Walk
 CERTIFICATE OF COMPLETION: DATE 9/4/87
 By Ruth Jones K

NOTICE: System installed according to Rules and Regulations but not a guarantee that it will function satisfactorily for any given period of time.

COLOR CODE: White-Owner; Pink-Improvements Permit; Blue-Contractor; Yellow-Inspection Dept.; Green-Health Dept.

IMPROVEMENTS PERMIT SKETCH

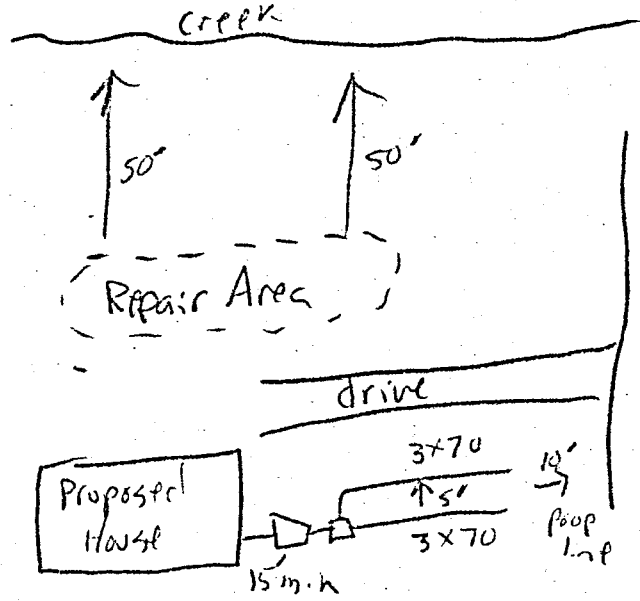

CERTIFICATE OF COMPLETION SKETCH

