

TRANSYLVANIA COUNTY HEALTH DEPARTMENT

Sewage Disposal System Improvements Permit and Certificate of Completion Sewage Treatment and Disposal Rules (Article 11 of Chapter 130A of the General Statutes of North Carolina)

9506-67-5543-000

PERMIT VALID 5 YRS.
FROM DATE OF ISSUANCE

Date: 10-24-90 Receipt No.: 0084
 Owner/Agent: Kraig & Sharon Brigham Phone No.: 883-2959
 Address: 105 Park Avenue Brevard, N.C. 28712

Location of Property: Old 64 to Everett Farm Road - 2 miles - on right - Fox Crossing, take L fork in Fox Crossing to lot on L

Subdivision: Fox Crossing Lot Number: 15 Section: _____ Plat of Property: Yes No



Type of Facility: House Mobile Home Business Basement Yes No Basement Plumbing Yes No

Number of Bedrooms: 4 Number of Bathrooms: 2 1/2 Estimated Sewage Flow: 480 gpd

Lot Size: .83 Easements, Right-of-Ways, etc.: no Date Lot Recorded: _____

Type of Water Supply: Individual Drilled Well Spring ; Public/Community

Signature/Authorized Agent: Sharon Brigham Date: 10/24/90

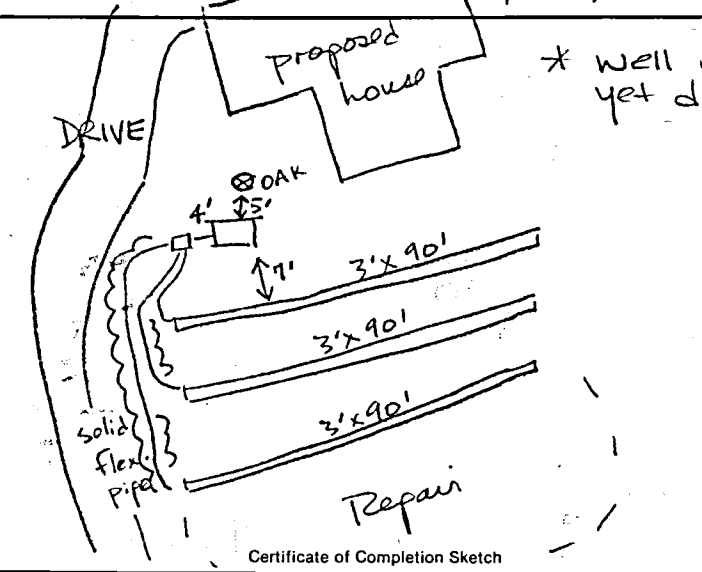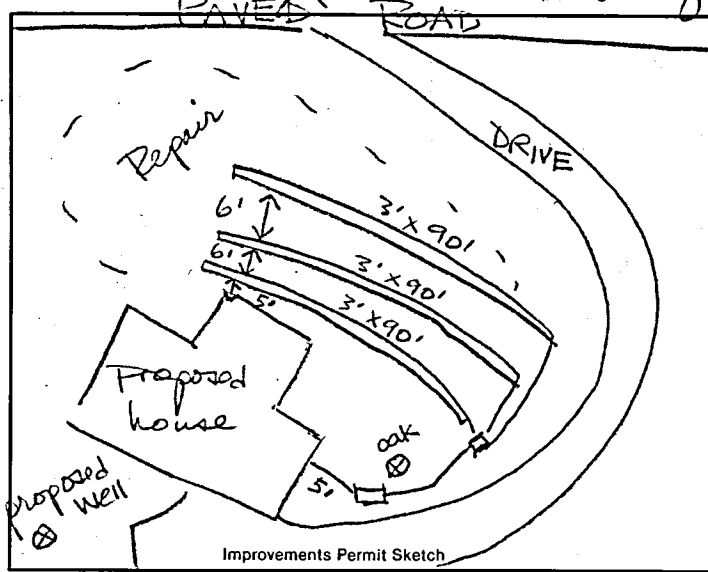

Nitrification trenches shall be installed on level grade with contour. Stepdowns permitted only when indicated.

New System Repair Addition

Size of Tank: 1000 Application Rate: .6 gpd/ft²

No. of Lines: 3 Width: 3' Linear Ft. 190'

Square Ft.: 810 Maximum Trench Depth: 18-22"

I understand and agree to install the septic tank system as specified on this Improvements Permit. Permit is void if any changes are made without consent of the Health Department Representative and/or if any false information is supplied in making Improvements Permit. on low side

Building Contractor: Jerry Miller

System Installed by: Joe McCall

This is to certify that system is installed according to Rules and Regulations but is not a guarantee that it will function satisfactorily for any given period of time.

By: Thom R. Rife, RS Date: 11/7/90

EXISTING SYSTEM: Addition/Remodeling Relocation

System functioning properly at time of inspection and is approved for proposed additions/renovations.

By: _____ Date: _____

Signature/Authorized Agent: Joe McCall Date: 11/2/90
 By: Thom R. Rife, RS Date: 11/2/90

* Keep proposed well 50' min. from the septic system/repair area.
 Color Codes: Health Dept.—Green; Owner—White; Contractor—Canary; Improvements Permit—Pink