


File & Slide 345

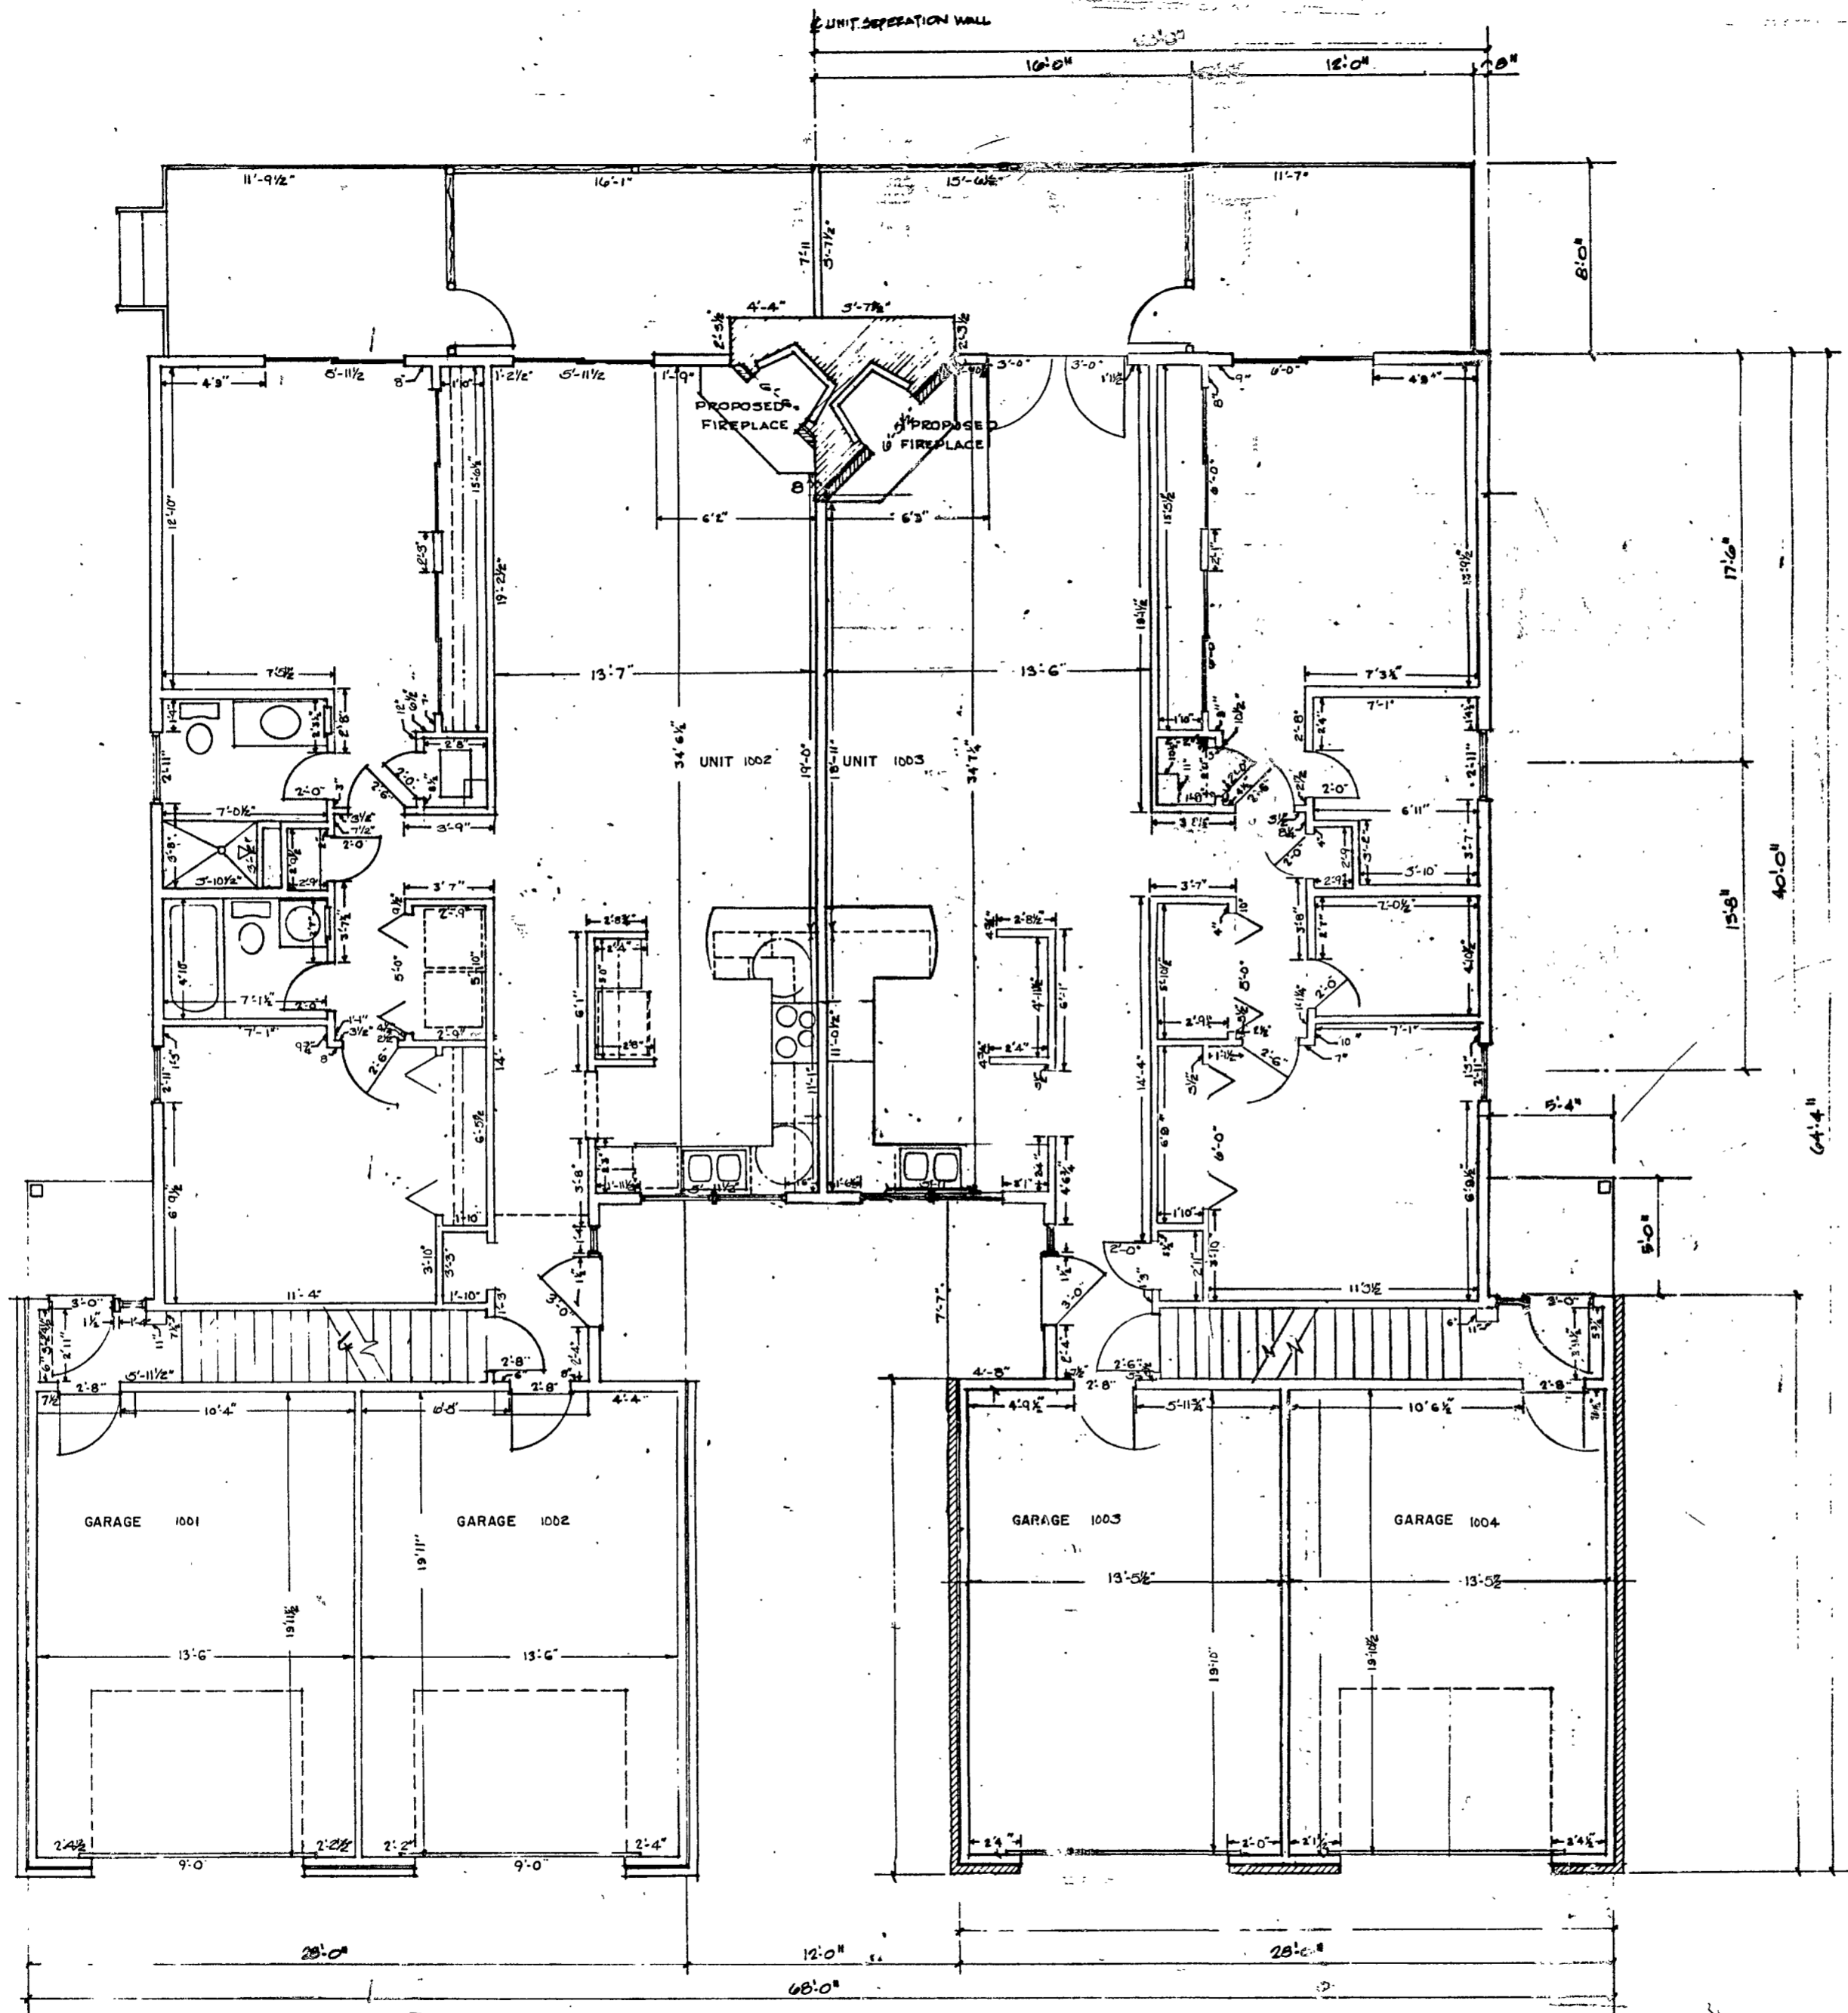

Filed for registration on the 30 day of Oct.
 19 84 at 4:00 o'clock P.M. and registered and
 verified on the 30 day of Oct 19 84
 In Book No. 2 of page 345
Frank H. Small
 Registrar of Deeds, Transylvania County



WATERFORD PLACE
 CONDOMINIUM NO. TEN
 OWNER, WATERFORD PLACE PARTNERSHIP

TYPICAL FIRST FLOOR

Phyllis Lanning

EXHIBIT-B RECORD DRAWING		
SCALE: AS SHOWN	APPROVED BY	DRAWN BY RWA
DATE: 10-15-84		
THE THOMPSON COMPANY 1830 Asheville Highway HENDERSONVILLE, NC 28739 (704) 693-0976		DRAWING NUMBER 2 of 5

File & Slide 345

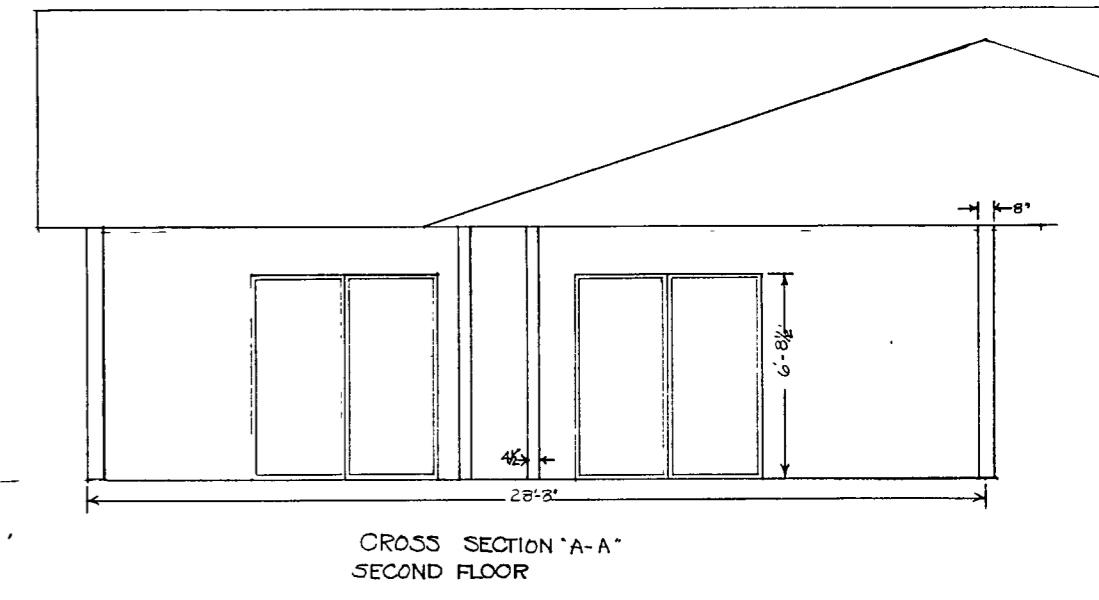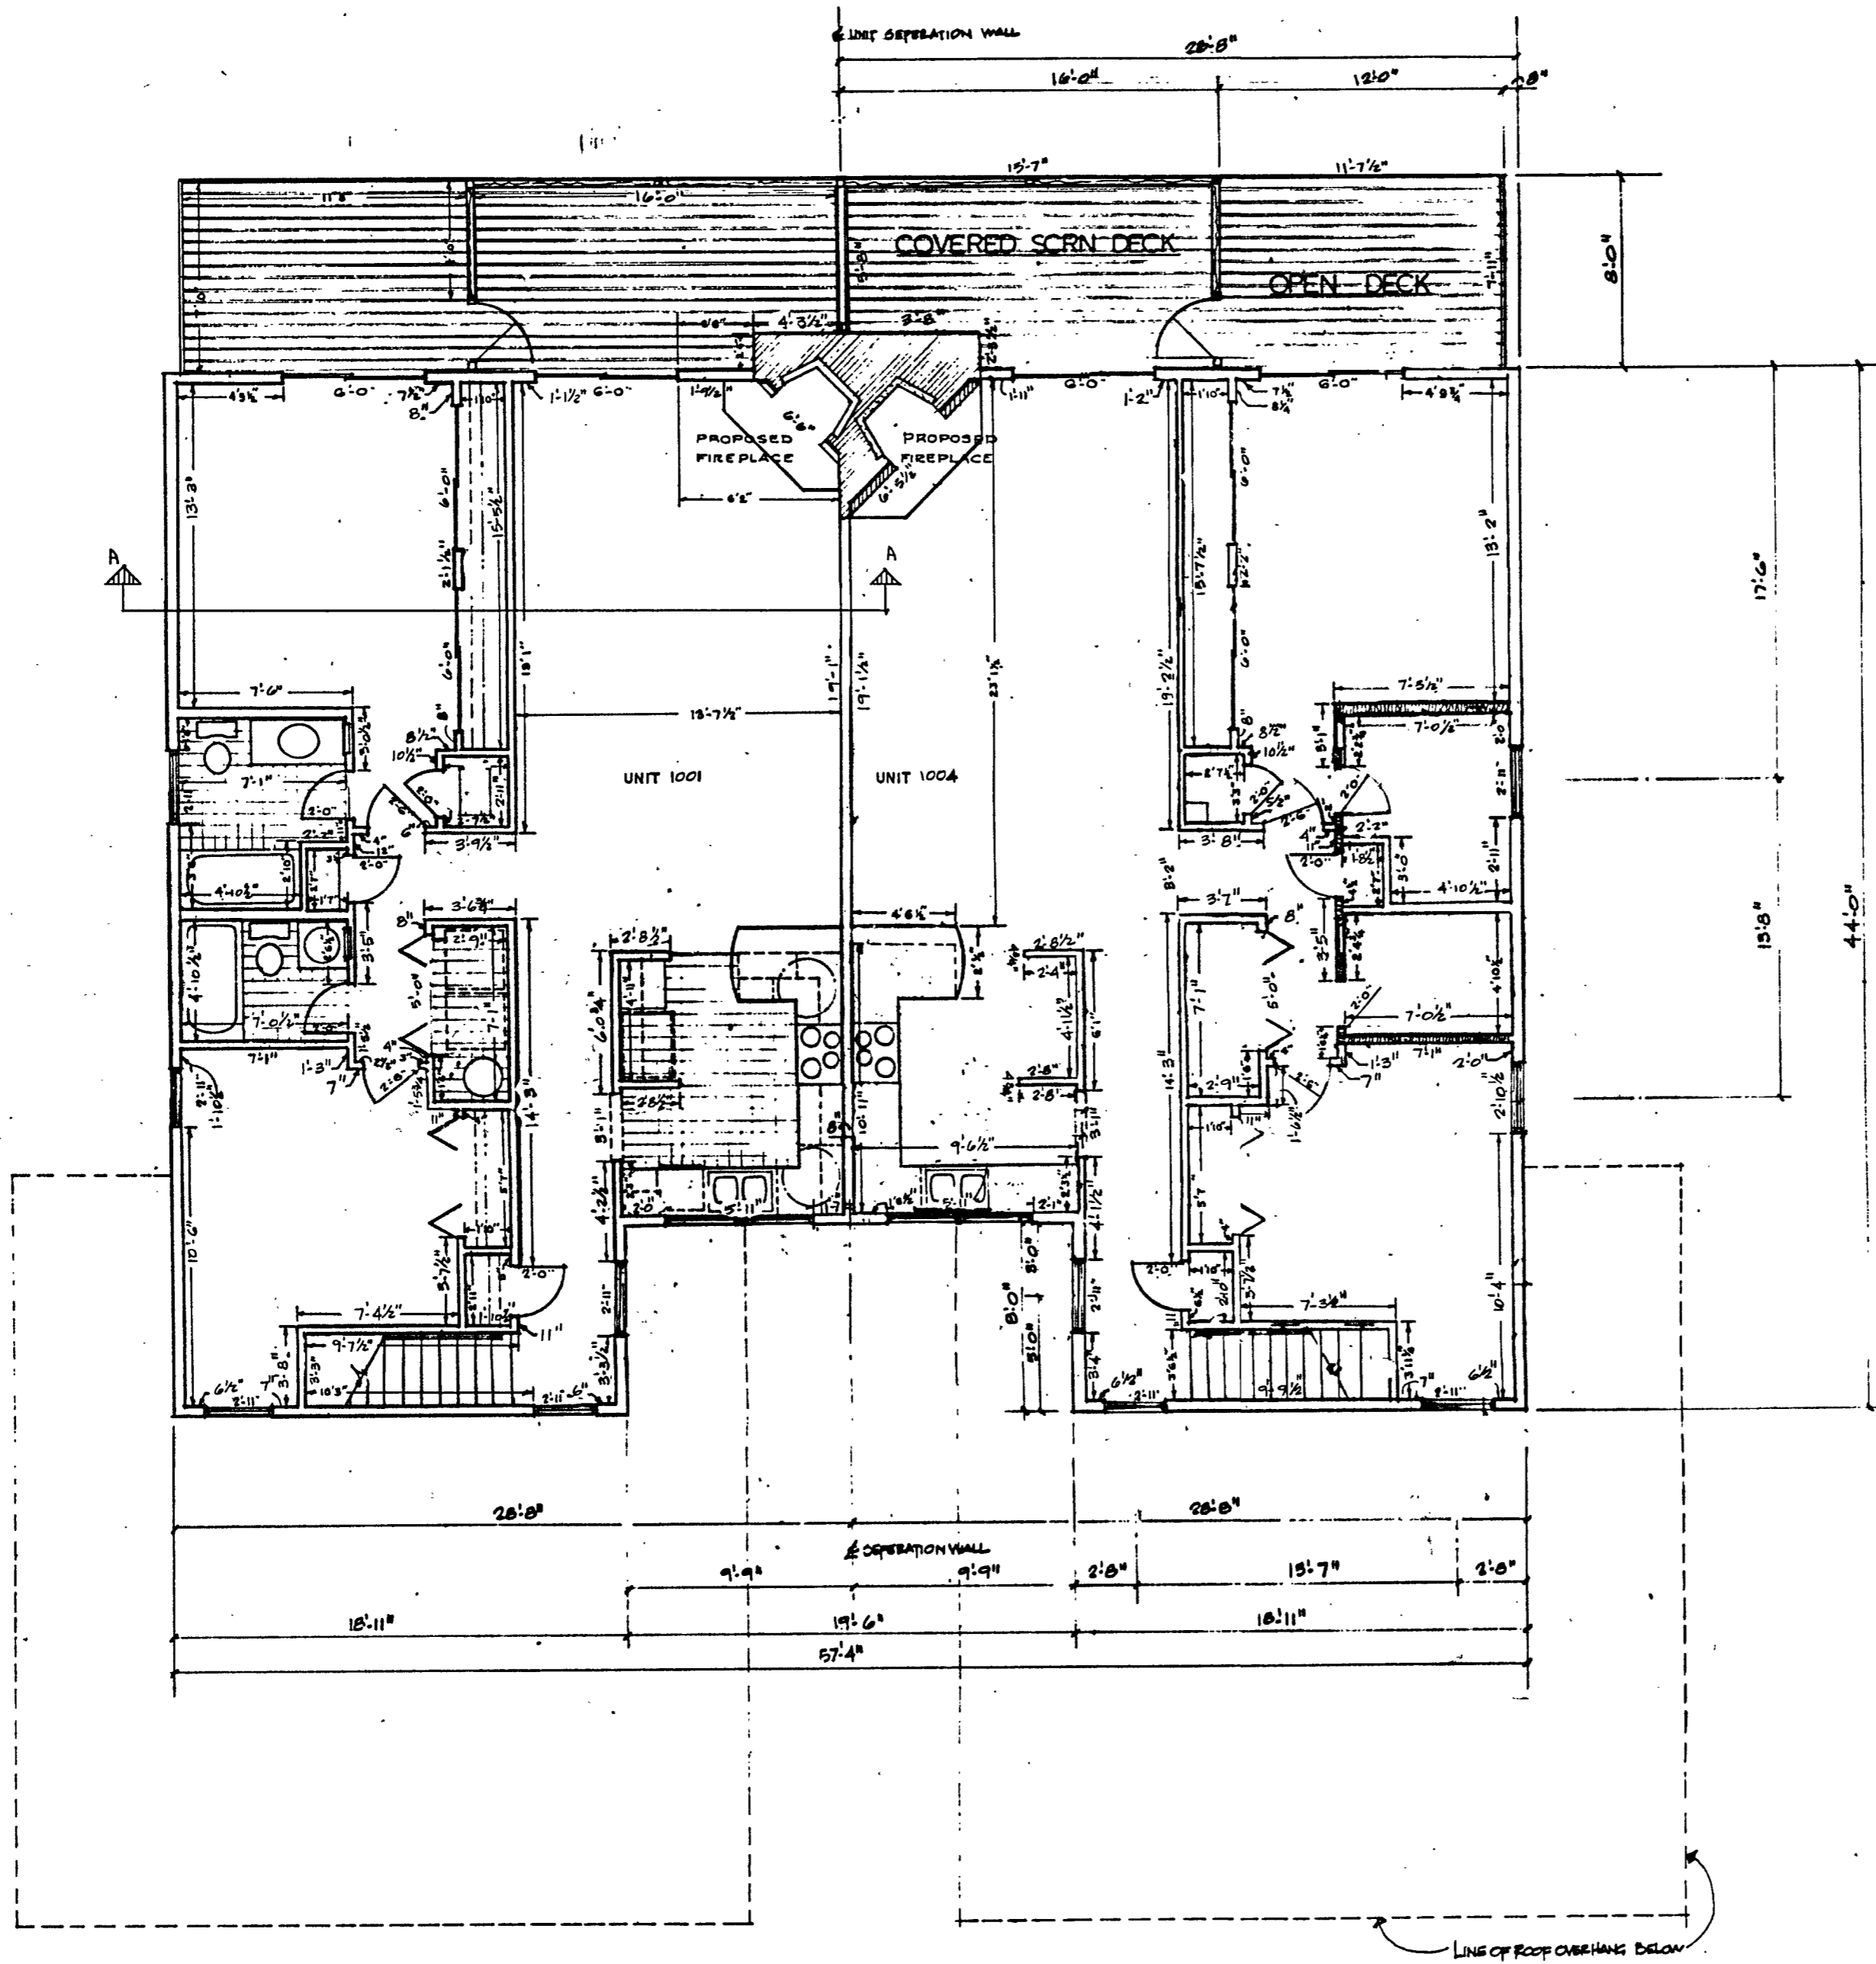


Filed for registration on the 30 day of Oct
 1984 at 4:00 o'clock P.M. and registration
 verified on the 30 day of Oct 1984
 in Book No. 2 of page 345
Fred H. Israel
 Register of Deeds, Transylvania County

WATERFORD PLACE
 CONDOMINIUM NO. 10
 OWNER, WATERFORD PLACE PARTNERSHIP

SECOND FLOOR PLAN

Paul Perry


EXHIBIT-B RECORD DRAWING		
SCALE: AS SHOWN	APPROVED BY	DRAWN BY RWA
DATE: 10-15-84		
THE THOMPSON COMPANY 1830 Asheville Highway HENDERSONVILLE, NC 28739 (704) 693-0976		DRAWING NUMBER 3 OF 5

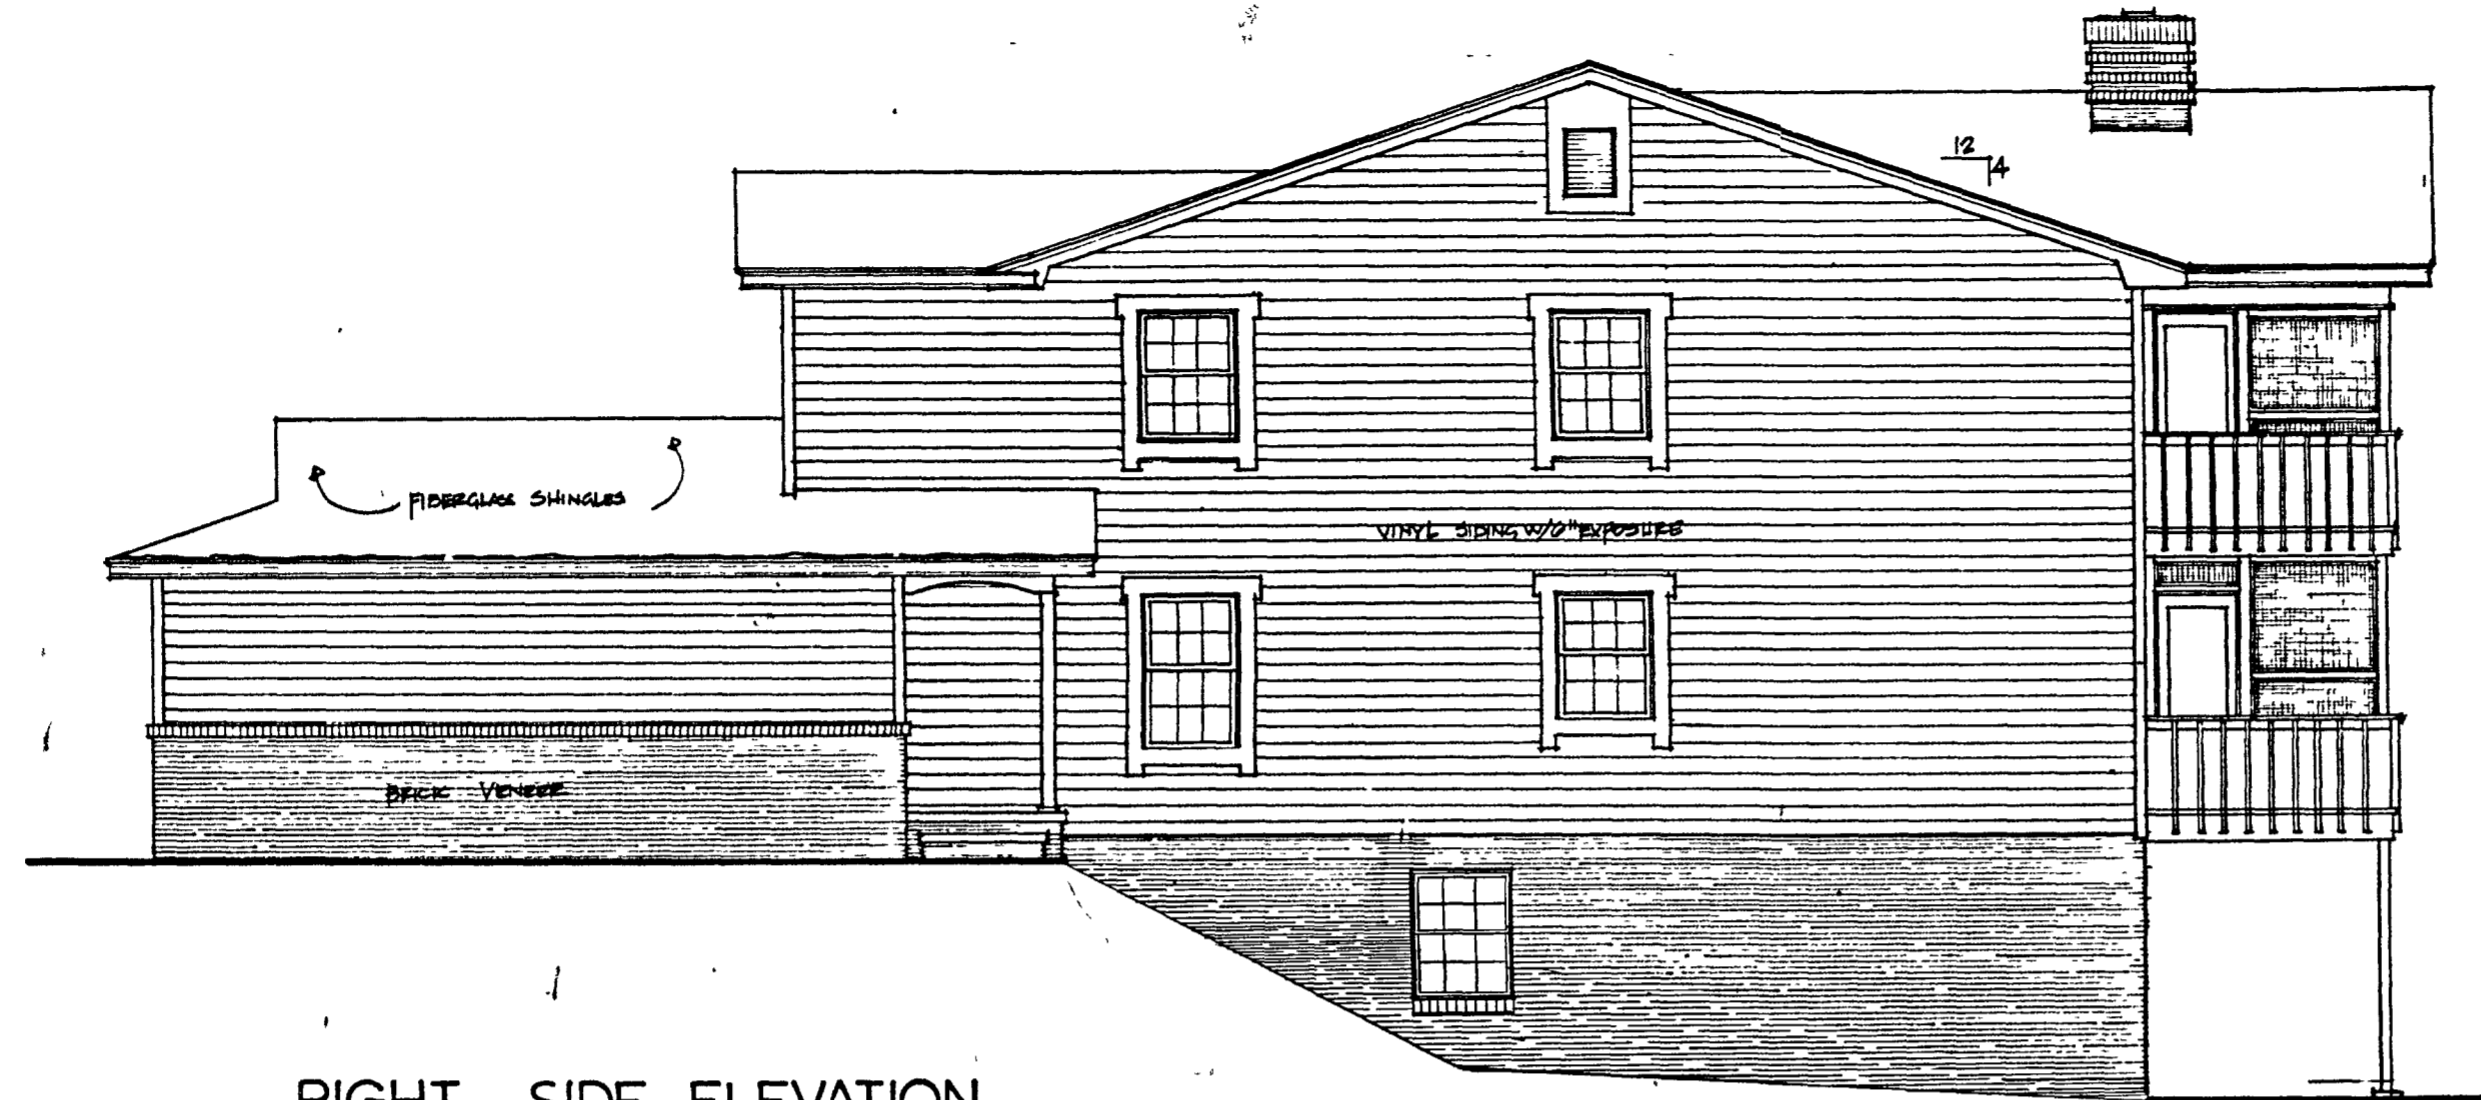

RIGHT SIDE ELEVATION

File 2 Slide 345

Filed for registration on the 30 day of Oct
 1984 at 900 o'clock P., and registered as
 verified on the 30 day of Oct 1984
 in Book No. 2 of page 345
Frederic H. Israel
 Register of Deeds, Transylvania County

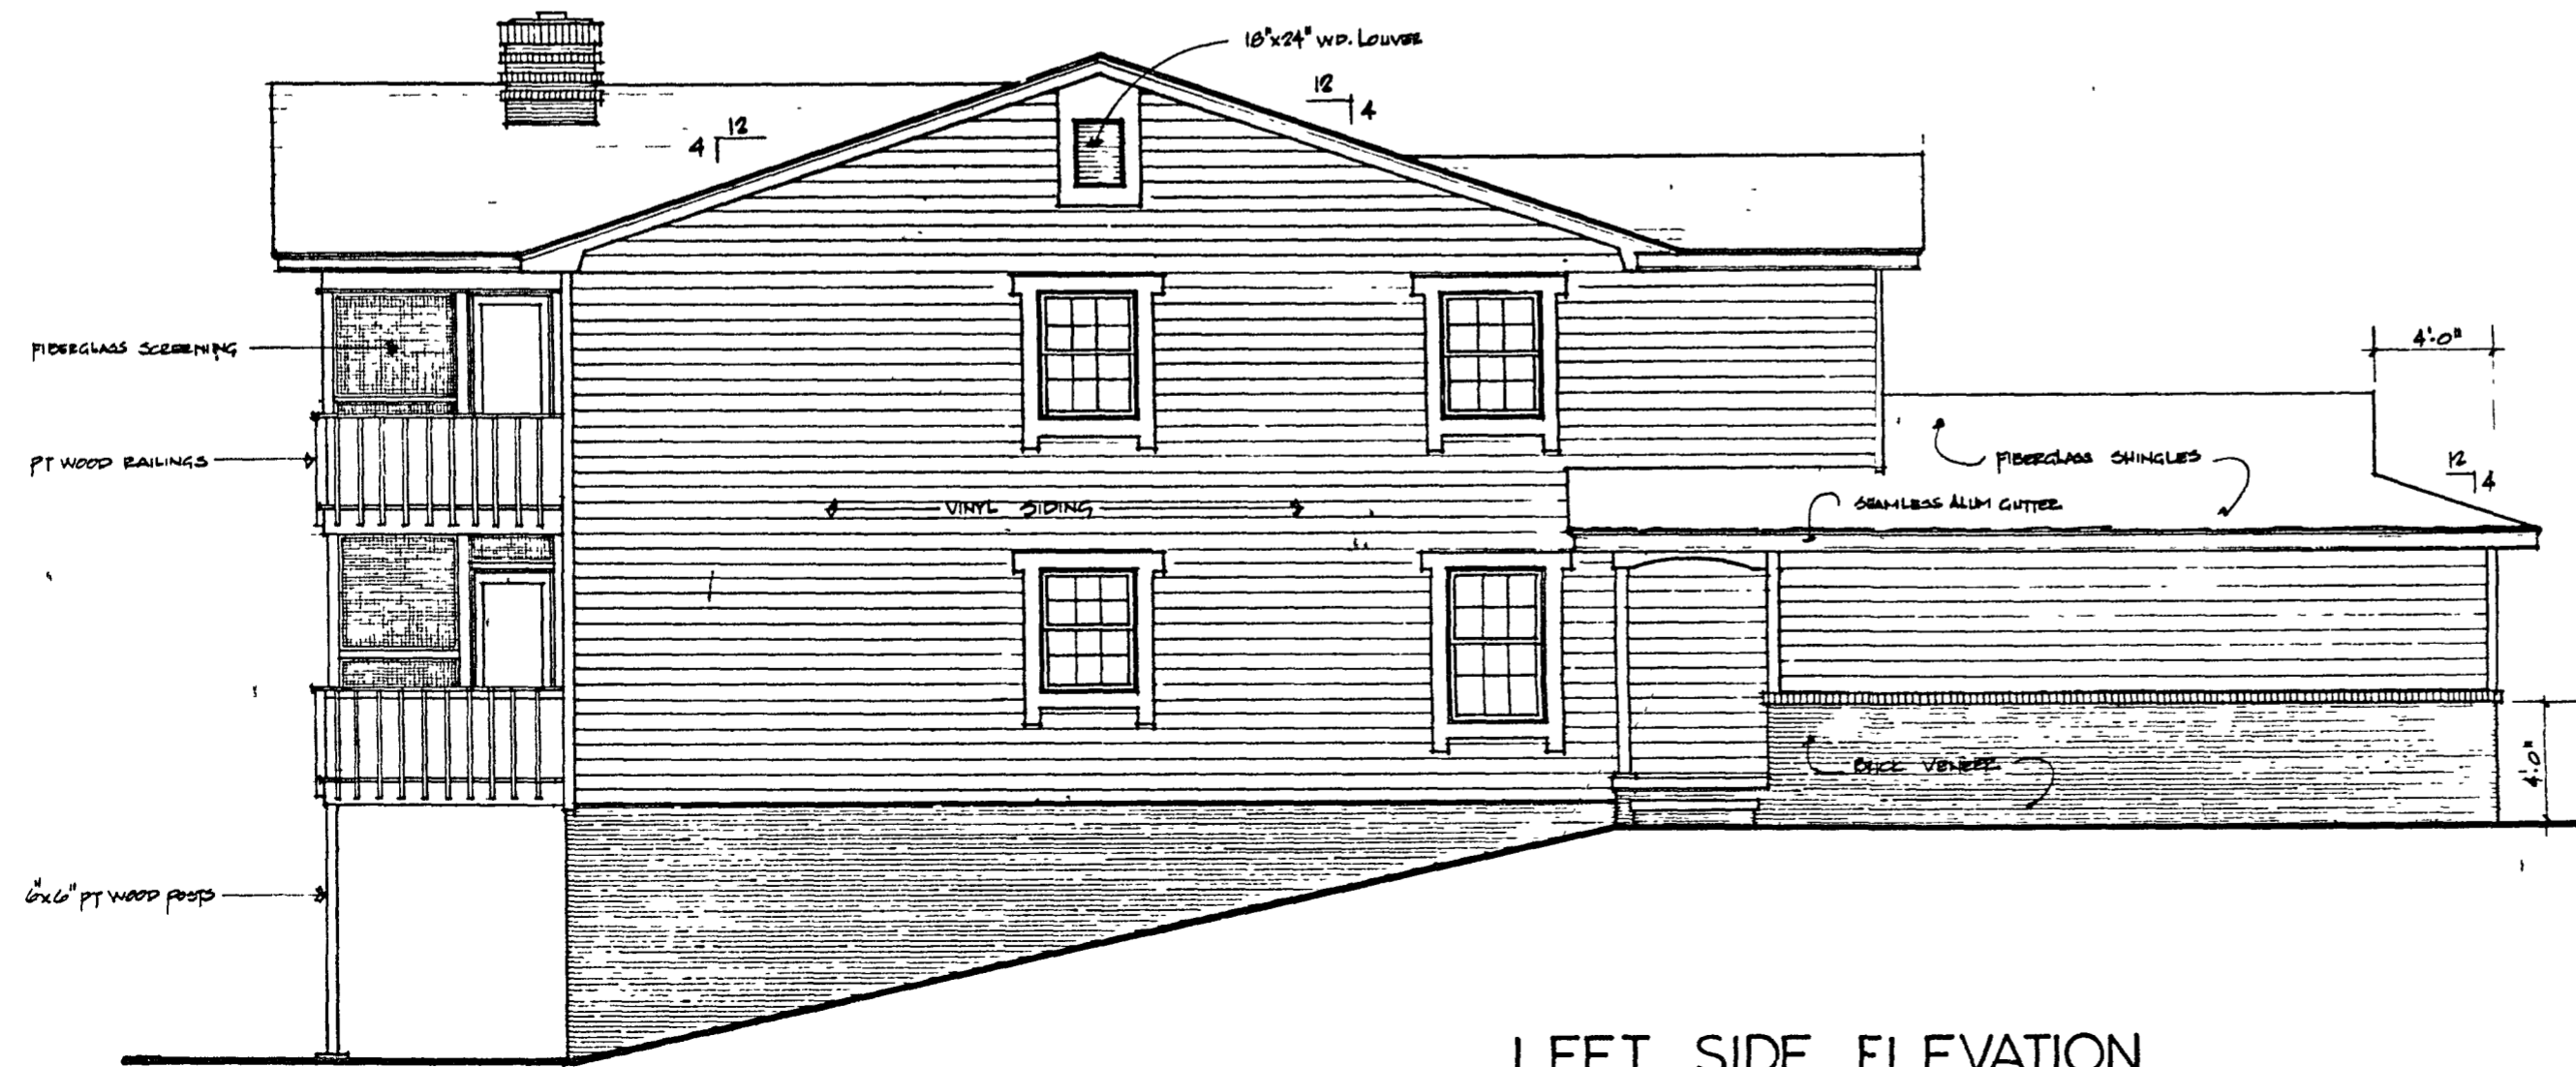


LEFT SIDE ELEVATION

WATERFORD PLACE
 CONDOMINIUM NO TEN
 OWNER, WATERFORD PLACE PARTNERSHIP

Philip R. [Signature]

EXHIBIT-"B" RECORD DRAWING		
SCALE AS SHOWN	APPROVED BY	DRAWN BY RWK
DATE 10-15-84		
THE THOMPSON COMPANY 1830 Asheville Highway HENDERSONVILLE, NC 28739 (704) 693-0976		DRAWING NUMBER 5 OF 5


File 2 Slide 345

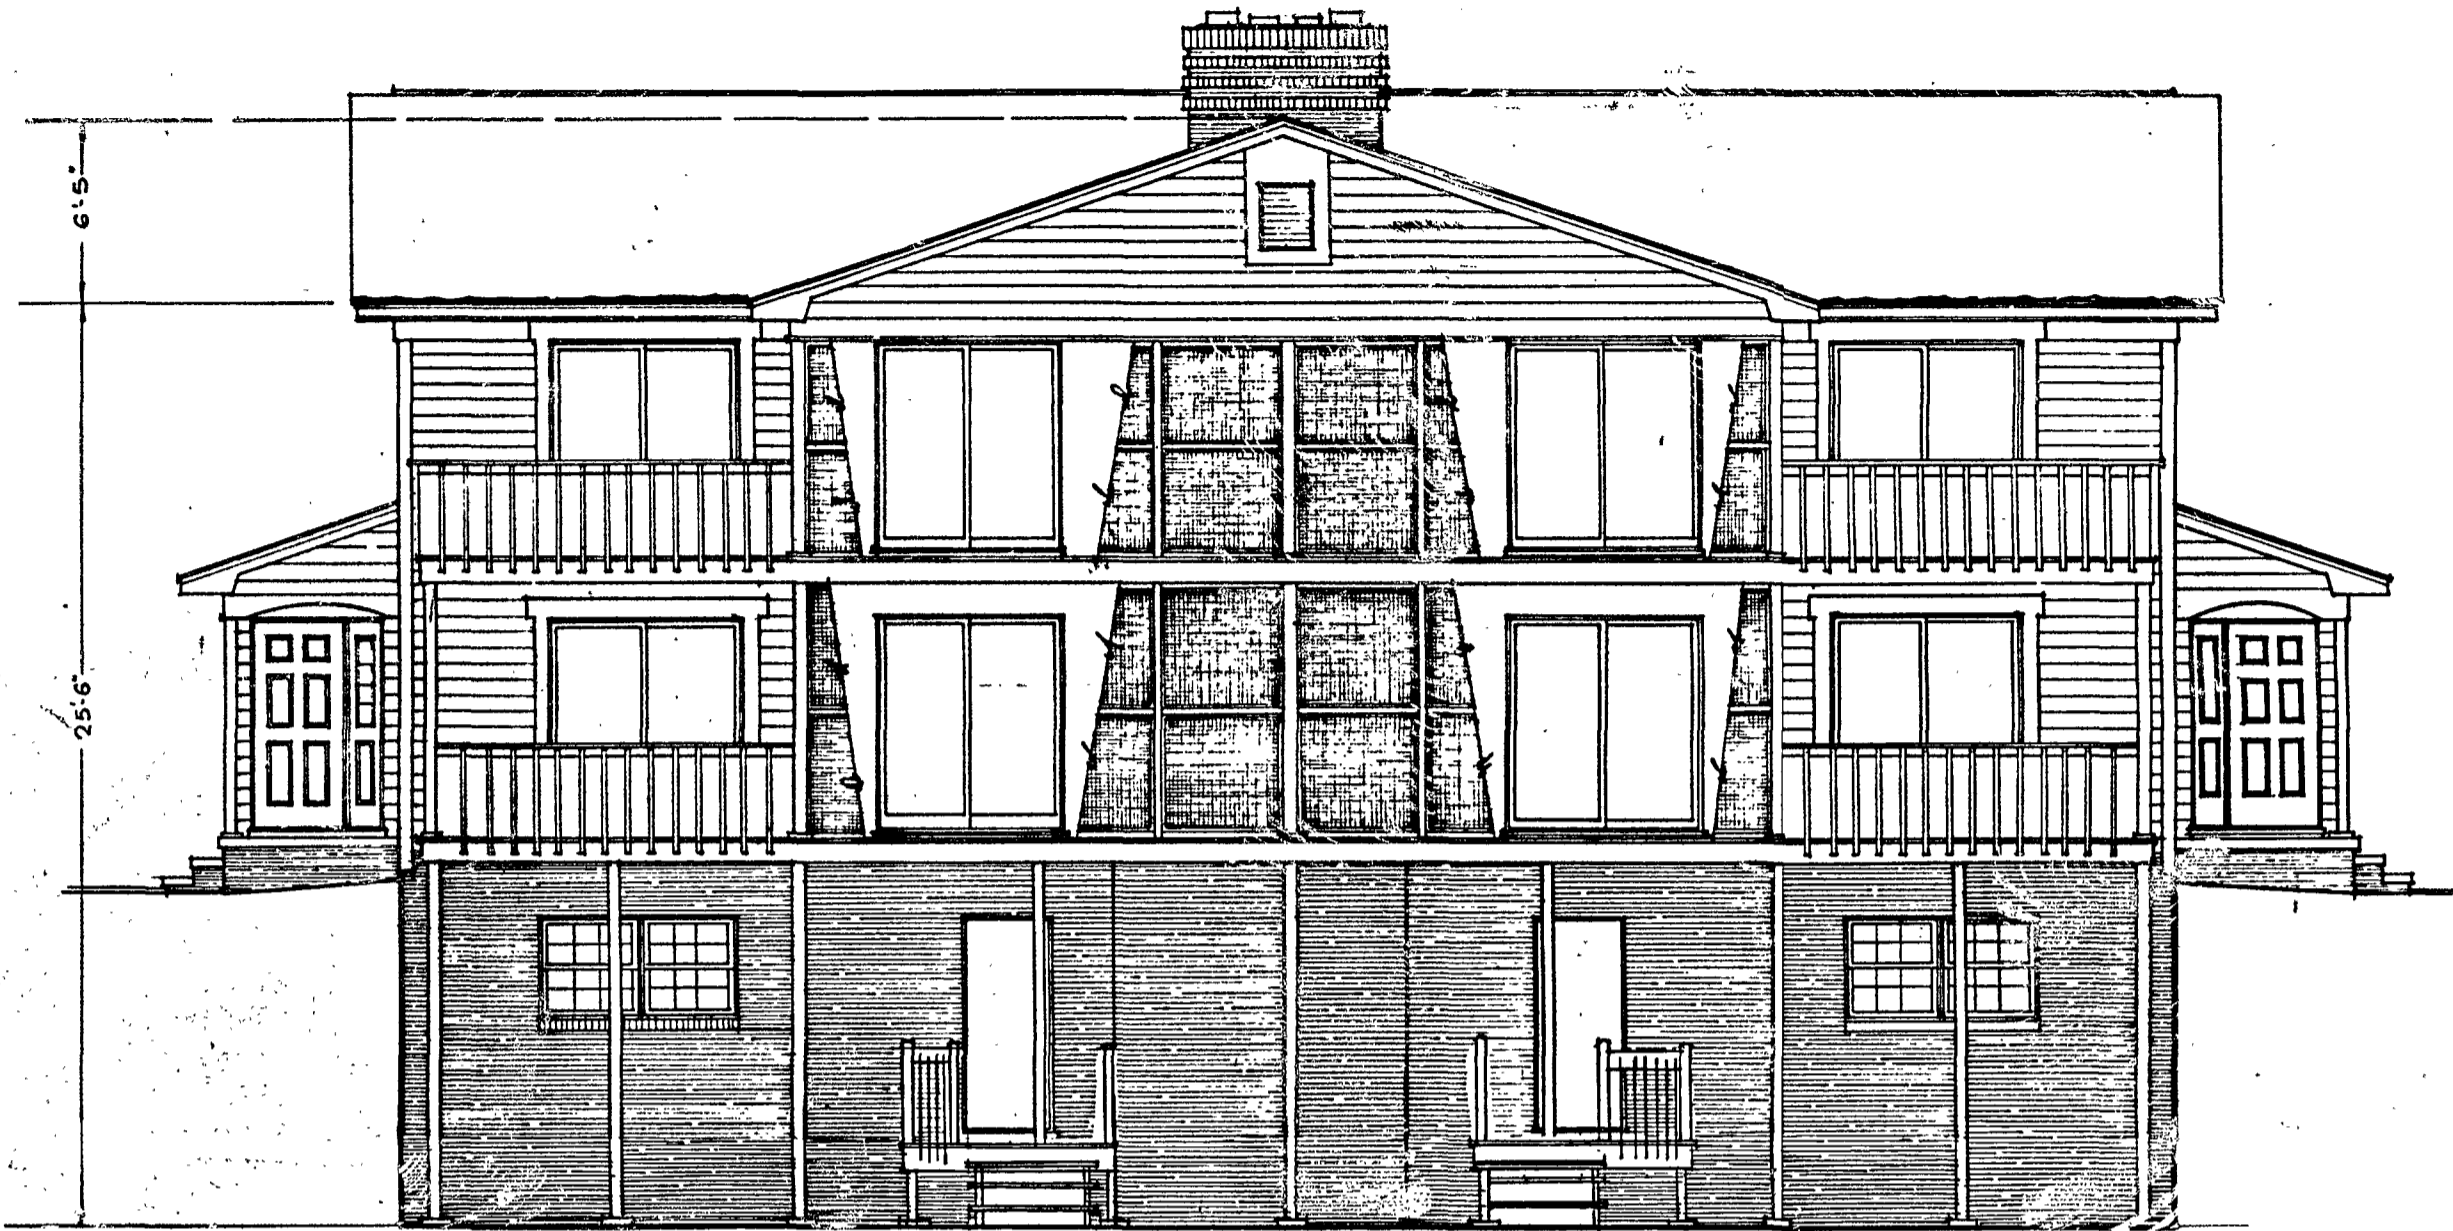

REAR ELEVATION

Filed for registration on the 30 day of OCT
1984 at 4:00 o'clock M, and registered and
verified on the 30 day of OCT 19 84
In Book No. 2 of page 345
Frederick D. Ornel
Register of Deeds, Transylvania County

WATERFORD PLACE
CONDOMINIUM NO. TEN
OWNER, WATERFORD PLACE PARTNERSHIP

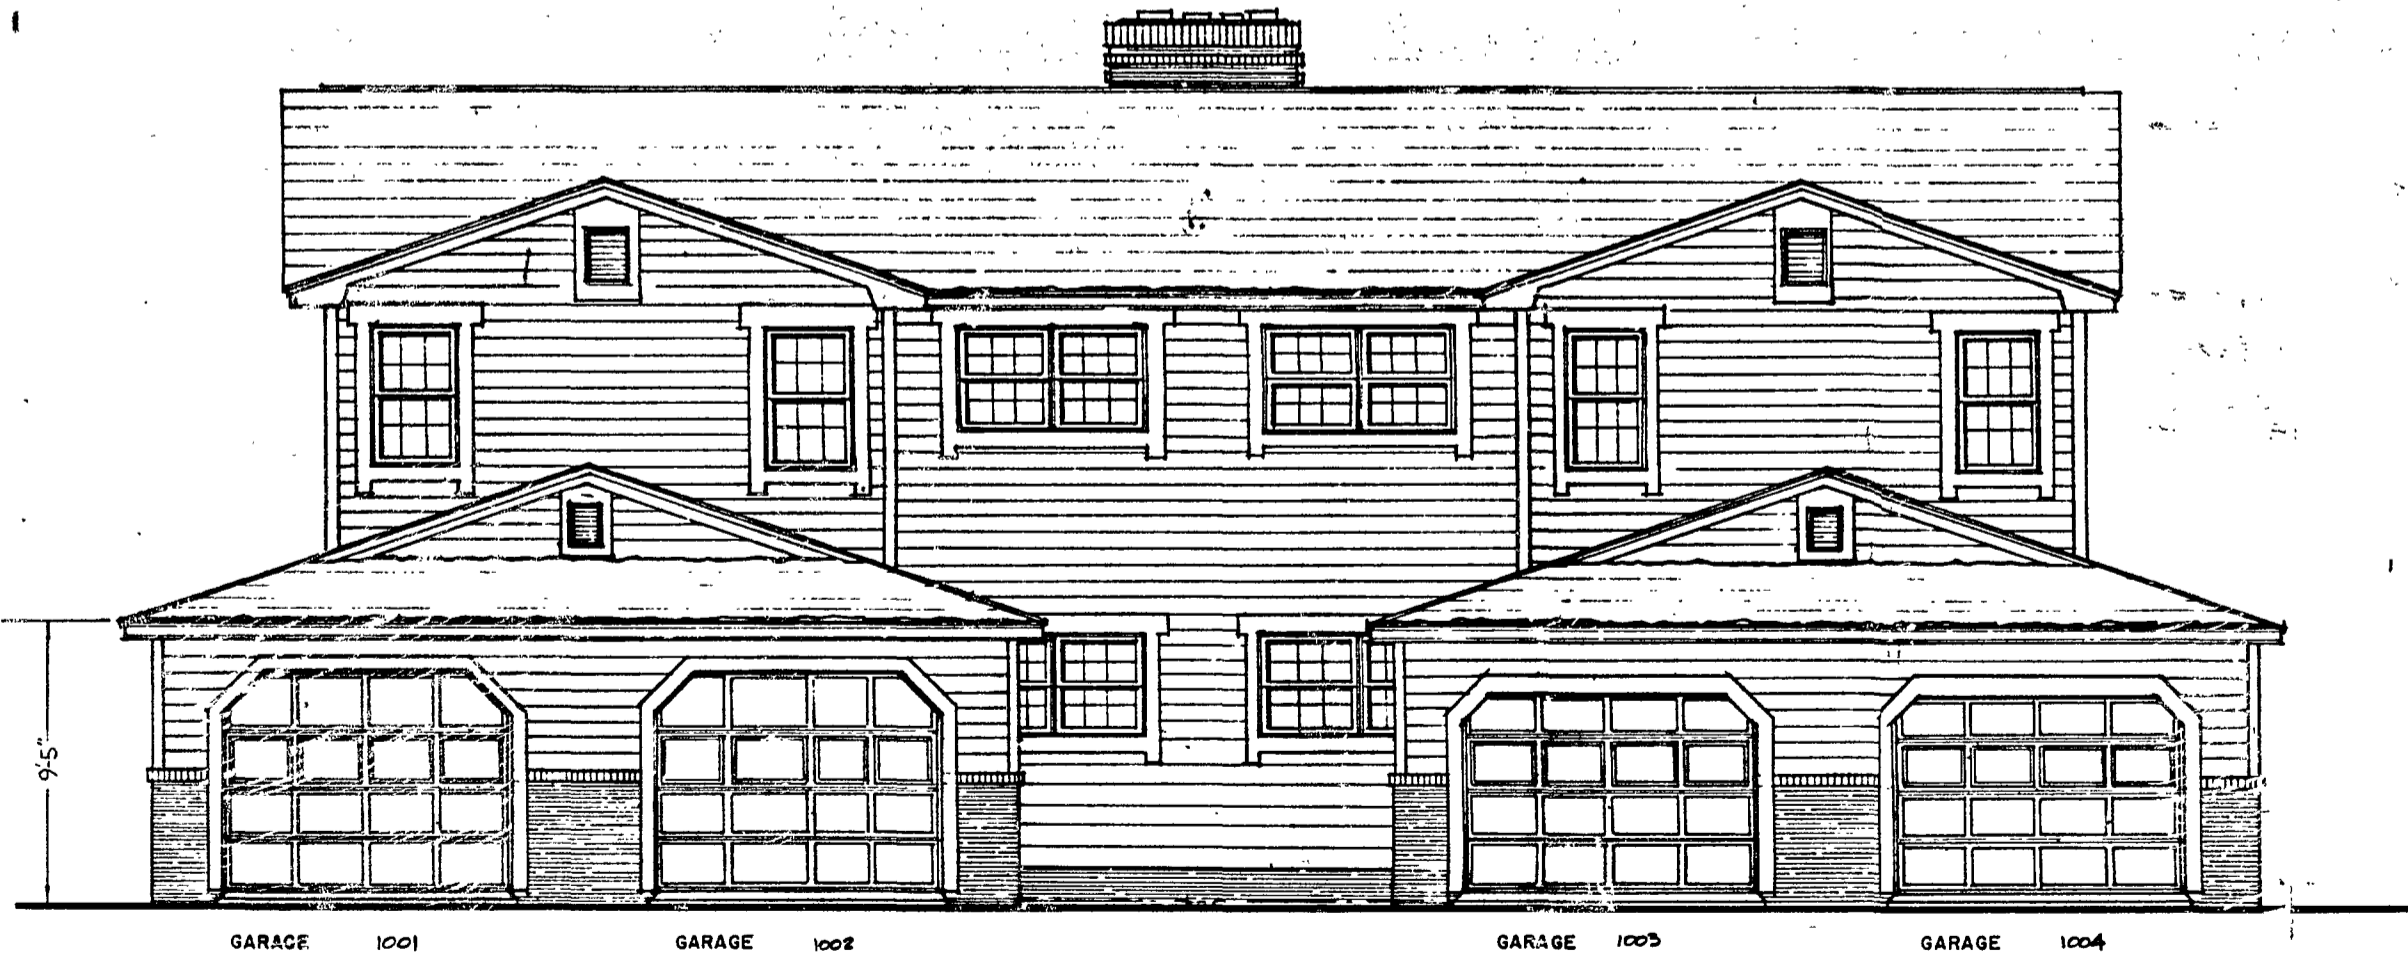

FRONT ELEVATION

Blair B. Blasing

EXHIBIT-"B" RECORD DRAWING		
SCALE: AS SHOWN	APPROVED BY	DRAWN BY RWA
DATE: 10-16-84		
THE THOMPSON COMPANY 1830 Asheville Highway HENDERSONVILLE, NC 28739 (704) 693-0122		DRAWING NUMBER 4 OF 5