


(Sewage disposal system) Improvements Permit and Certificate of Completion


(Ground Absorption Sewage Disposal System - Section 130 - 160 of Chapter 130 of the General Statutes of North Carolina)

OWNER-OCCUPANT Paul Handrickson BUILDING CONTRACTOR Bill Griffin
LOCATION Top of Hill Farm Rd. New Hope - (200 yds)
SUBDIVISION Right Forest Farm LOT NO. _____ SECT. OR BLOCK NO. _____
SEPTIC TANK CONTRACTOR Hand ADDRESS _____

HOUSE MOBILE HOME BUSINESS
NO. BEDROOMS 3 NO. BATHROOMS 3
SIZE OF SEPTIC TANK 850 GALS. (Liquid) _____
MATERIAL: PRE-CAST BLOCK FIBERGLASS
DISTRIBUTION BOX YES NO
NO. OF LINES 2 WIDTH 3 FT. LENGTH 40 FT.
PERCOLATION TEST YES NO
WATER SUPPLY: INDIVIDUAL PUBLIC
SITE CLASSIFICATION: SUITABLE
PROV. SUITABLE
UNSUITABLE

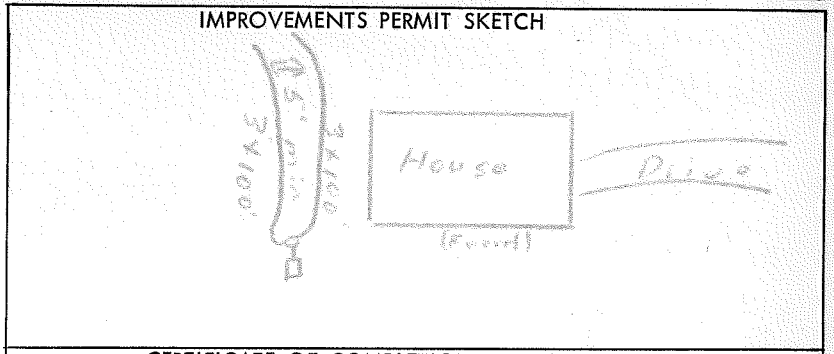

IMPROVEMENTS PERMIT: DATE: 8-21-78
BY: Wes Patterson Jr.
CERTIFICATE OF COMPLETION: DATE: 10-25-78
BY: Keith Jones

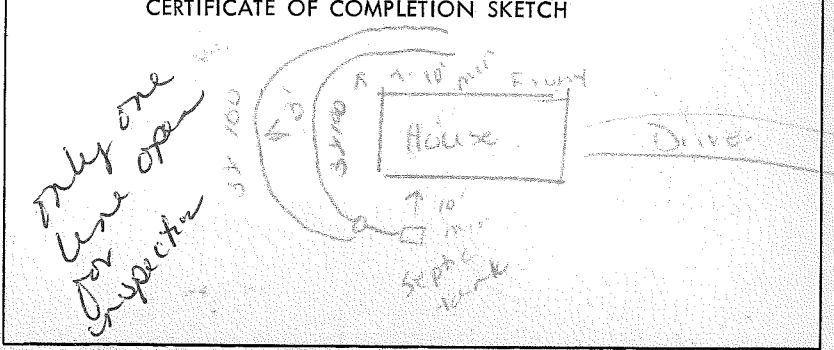

NOTICE: System installed according to Rules and Regulations but not a guarantee that it will function satisfactorily for any given period of time.
COLOR CODE: White-Owner; Pink-Improvements Permit; Blue - Contractor; Green - Health Dept.