



TRANSYLVANIA COUNTY DEPARTMENT OF PUBLIC HEALTH
WELL PERMIT OR WELL REPAIR PERMIT.
CERTIFICATE OF COMPLETION

New Well Repair To Existing Well []

WP20-113 8595-65-7879-000 Bryson, Joe
Permit No. Parcel I.D. Issued To
TBD Knob Road Timber Ridge, Lot 3
Property Street Address Subdivision /Sec/Lot#

Well Grouting Inspection

Casing Type PVC Casing Thickness/Weight SDR-21 Casing Depth 67'
Diameter 6.25" Grout Type Bentonite Grout Depth 20'
Grout Method Pump

Inspected By: Yulio Cofu REHS Date: 10/13/2020

Well Head Inspection

Inches Above Grade 12" Air Vent Threadless Sample Tap
Sanitary Seal (if hose bib) Anti-Siphon Present Well Plate
Pump Plate Well Depth 705' Static Water Level 100' Yield 3/4 GPM

Contractor McCrary
Certification # 3156a
Date 11/9/2020 Depth 680'
Horsepower 1.5HP

F+W
5GPM
230V

Inspected By: James A Bayer, REHS Date: 12/29/2020

Well Report Received (GW-1a)

Well Contractor McCrary Well Certification # 3156a
Matthew T. Parker


Issued By James A Bayer, REHS Date 12/29/2020

File Name: Timber Ridge

WELL
Permit No. **WP 20-113**

Pin No.: 8595-65-7879-000

LOT 3
Bryson, Joe

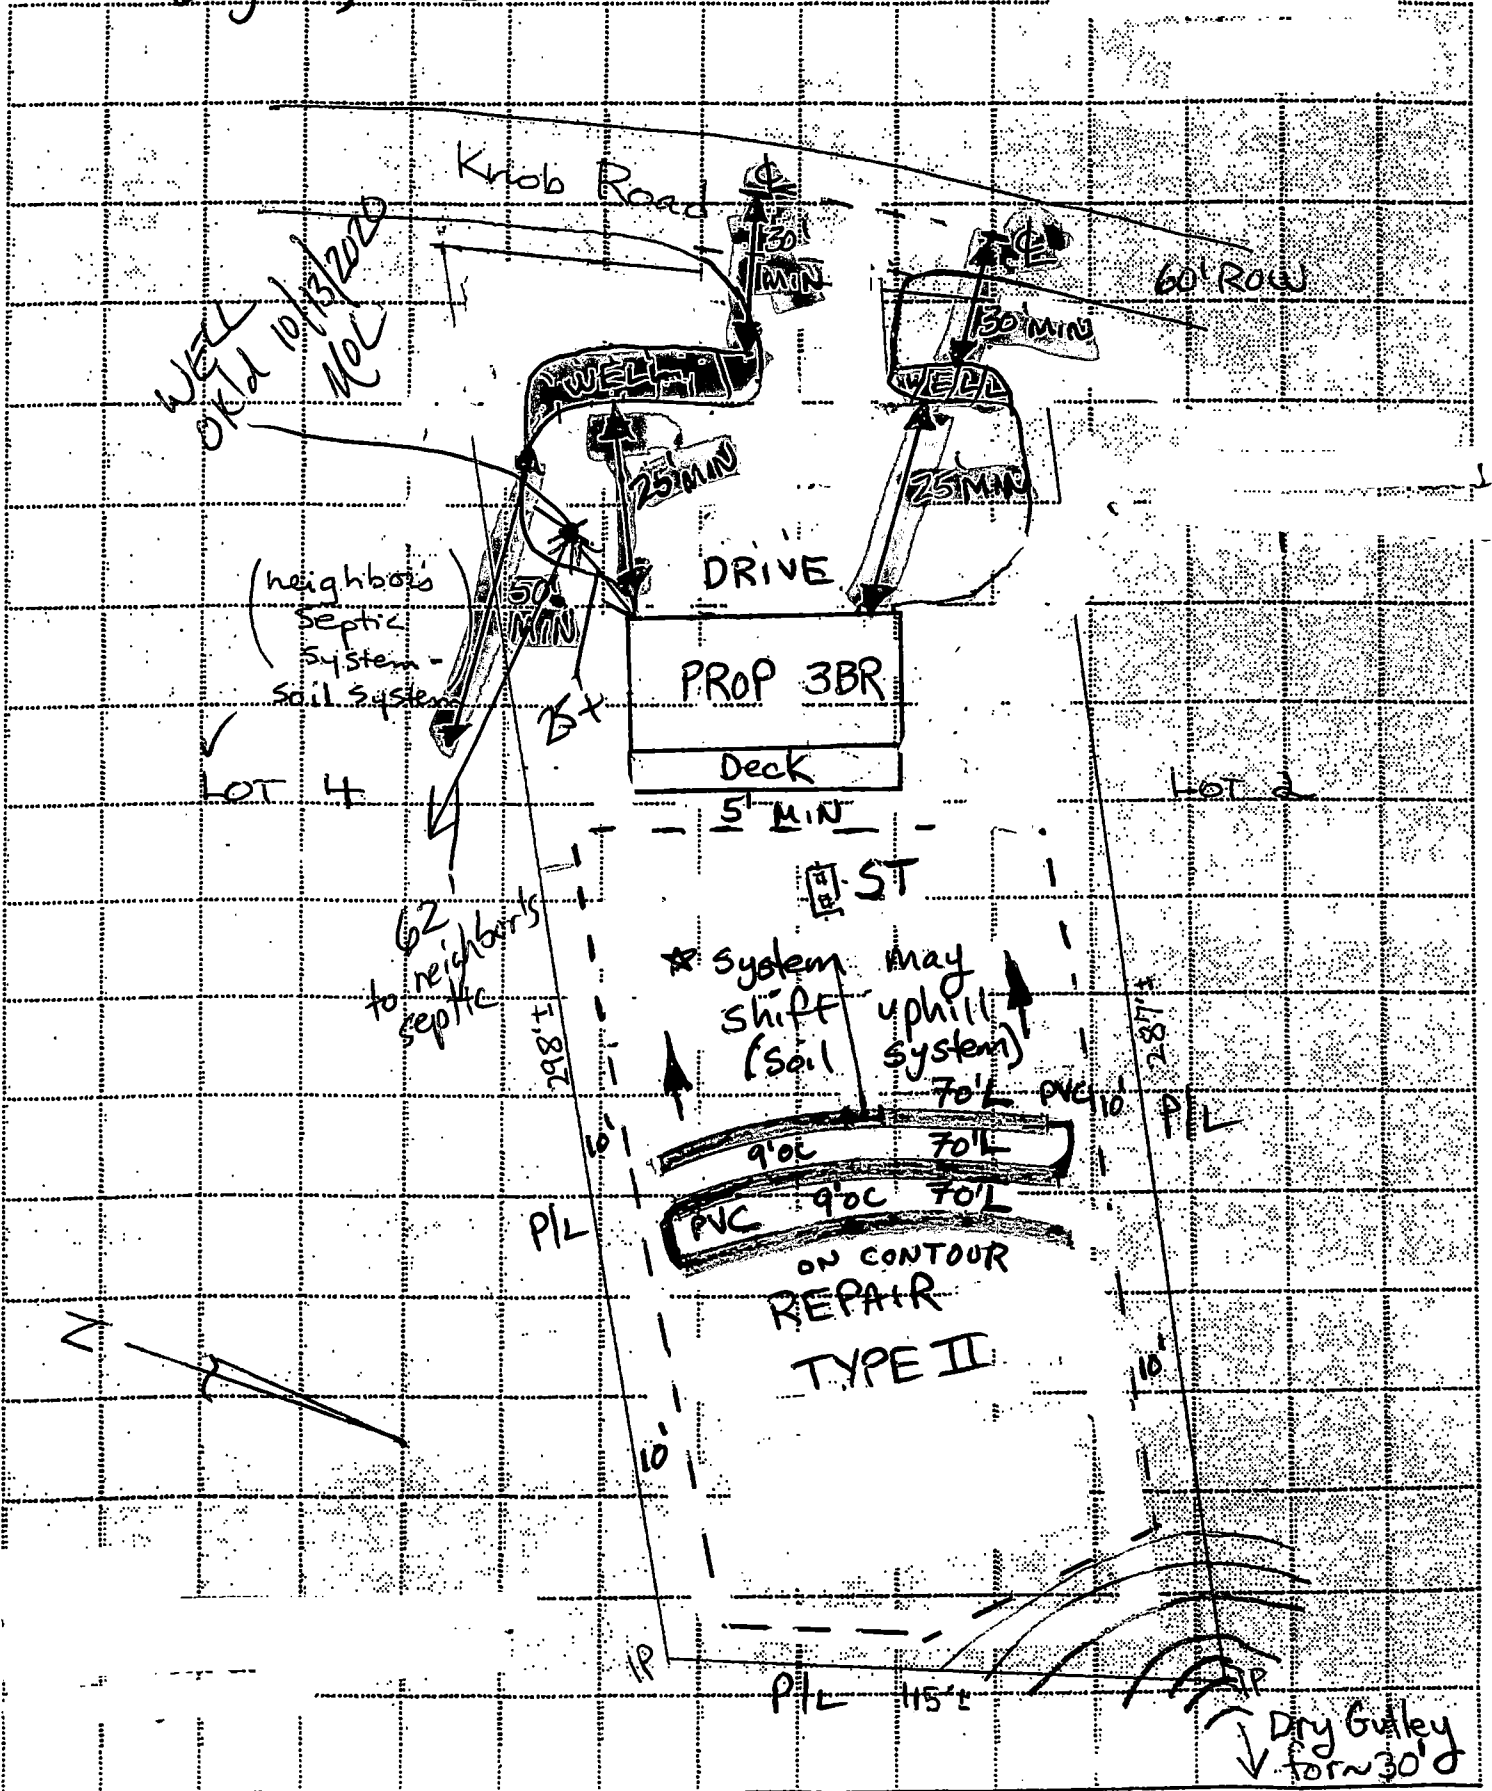

SCALE: 1" = 40'