



Henderson County Department of Public Health

Steven E. Smith, MPA, Health Director | Seth Swift, R.H.E.S., Environmental Health Supervisor

1200 Spartanburg Highway, Suite 100, Hendersonville, NC 28792
Main Phone: (828) 694-6060 | Administration FAX: (828) 697 4523

Public Health
Prevent. Promote. Protect.

Septic and/or Well Permit Search Request

CONTACT INFORMATION:

Name: Jason Shepherd Date of Request: 7/29/22
Phone #: 828-423-9010
FAX #: _____ EMAIL: jason@lookingglassrealty.com

PROPERTY INFORMATION

Address (REQUIRED) Tract 23 4989 Chimney Rock Rd.
Subdivision: Hardison Estates Lot# Tract 23

List Current and All Previous Owners of Property (If the ownership records do not go back as far as the date the house was built, we may have difficulty finding a record. Please make sure to include as much information as possible): _____

Adam Murray & Heather Murray 2012
Joseph Hucks & Susan Hucks 2003
Thomas Huml 1994
F.K Joe Harrelson 1977

Previous Road Name(s): Jeep Rd ?

Year Residence was Built: Not Sure PIN: 0613631296

Please submit your completed request to:

Fax # 828-697-4523

Email: HCDPH_EnvHealth@hendersoncountync.gov

ENVIRONMENTAL HEALTH DEPARTMENT SEARCH RESULTS:

Search Completed by: SW Date: 7/31/2022

- Record Located Copy Attached
- No Record Located
- Incomplete property information provided unable to process


**HENDERSON COUNTY HEALTH DEPARTMENT
OPERATIONS PERMIT**

OP No. 2063

Owner THOMAS H. J. M. L. Date 3-7-90
 Building Contractor _____
 Septic Tank Installer DUANE LYDA
 Lot No. _____ Development _____
 Location 5/4 E. TO BAT CAVE T/C ON DIRT RD WITH 2
 STONE PILLARS ≈ 3/4 MI BEFORE HWY 74 COUP
 DIRT RD = 1.9 MI CABIN AT END OF RD
 House Mobile Home
 Other CABIN
 No. Bedrooms 2 Design Flow GPD 240
 Lot Size 9 AC ±
 Owner's Signature [Signature]

AC No. 30522
 I No. 30522
 WI No. 3529
 Water Supply: Community Shared
 Individual City
 Tank Size ACME 1000 Gal.
 Drainfield 480 Sq. Ft.
 Stone Depth 12 Inches
 System Type CONVENTIONAL
 Min. System Review Frequency _____
 Issued By: [Signature]
 Environmental Health Specialist

**VALID ONLY FOR USE AS DESCRIBED ABOVE
DRAWING NOT TO SCALE**

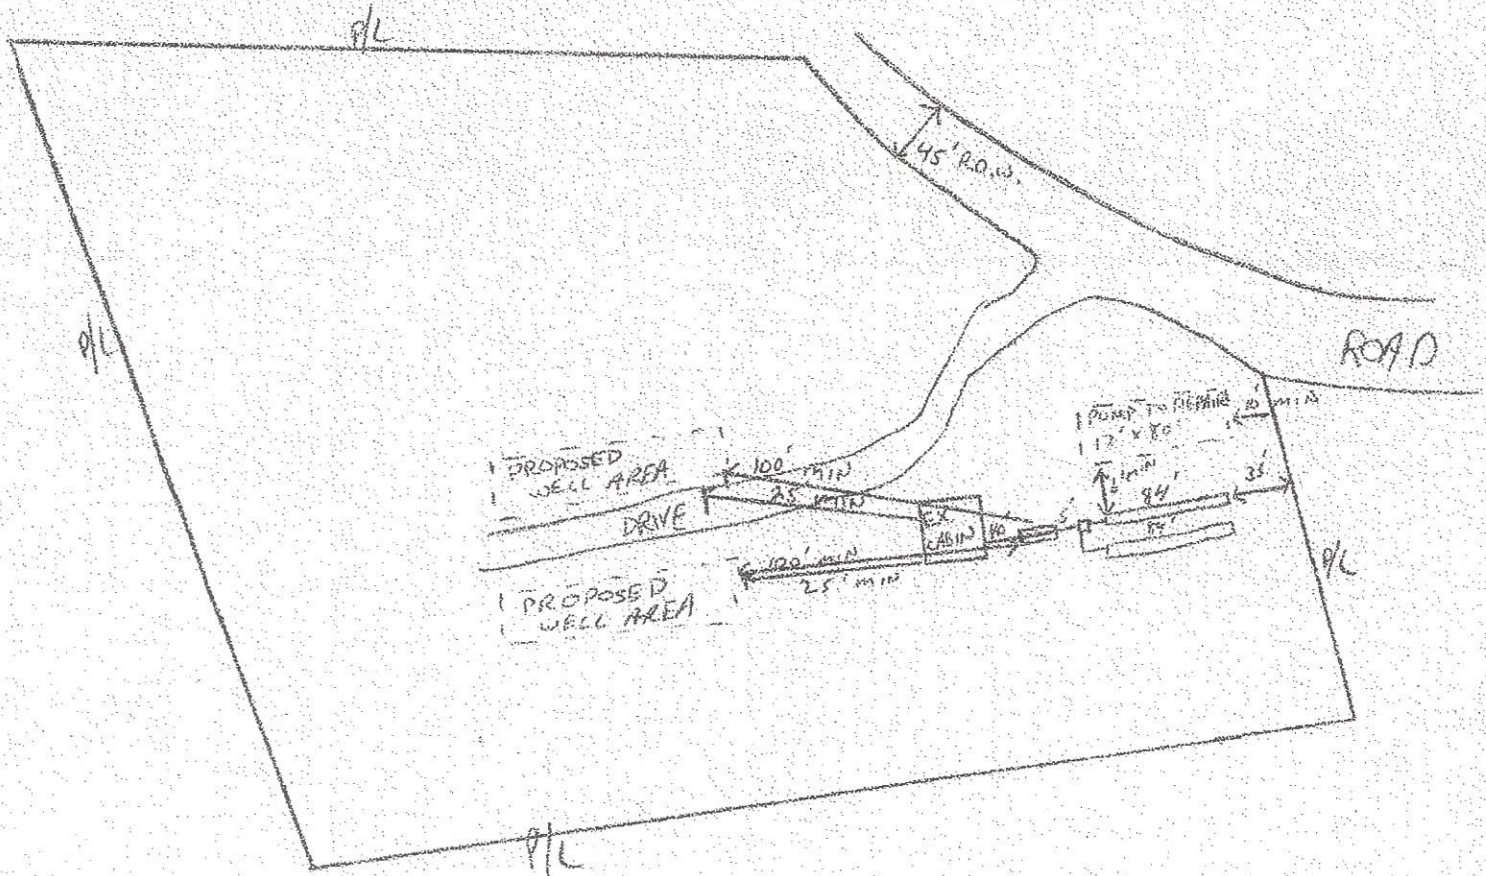

Tracts 18, 19, 20

Electrical Well ^ Permit

Henderson County (Building Code) – Electrical Permit

100 N. King Street, Suite 220, Hendersonville, N.C. 28792
 Phone:(828) 697-4830, Fax: (828)698-6185
 Fax:



Project No: 21010100007
Permit No: 21160105599
Status: APPLIED FOR
Appl. Dt.: 3/24/2021
Exp. Dt.: 9/24/2021
Status Dt.: 3/24/2021

Owner Information

Name : Adam Murray
Address : 2840 Chimney Rock Rd
 Hendersonville NC 28792
Phone(W) :
Phone(H) :
Phone(M) : 8087508

Property Information

PIN # : 0613741271
Address : 0 Chimney Rock Rd
 Hendersonville NC 28792
Type & Use : L1SFD
Subdivision : Hardison Estate 19.83 Ac
Lot # : 18-20
Living Units # :
Directions : 0 CHIMNEY ROCK RD. 64E, LEFT
 JUST PAST TUCKAWAY RIDGE DR.
 5003 CHIMNEY ROCK RD AT
 DRIVEWAY, 1.5 MILES TO SITE.
 DRIVEWAY ON RIGHT PAST
 SWITCHBACKS.

Prop Type : Private
Total (Sq.Ft.) : 0
Front Ft :
Rear Ft :
Side Ft :
Side St. Ft :

Utility Details

Power Co. :
Premise/Work # :
Water : Private
Sewer : Private

Contractor Details

Contractor : Owner
Address : Owner
 Owner NC 28739
Phone(W1) :
Phone(W2) :
Phone(M) :
ID # : 207945
License # : OWNER
Job Type : OTHER
Contact :

Applicant Information

Name : Adam Murray
Address : 2840 Chimney Rock Rd
 Hendersonville NC 28792
Phone(W) :
Phone(H) :
Phone(M) : 8087508

Occupant Information

Name : Adam Murray

Job Details

Job Type : New
Description : NEW SERVICE FOR EXISTING
 WELL ...JP

Electrical Details

Service Size :
Additions/ Renovations :
Total Cost :

Notes : NEW SERVICE FOR EXISTING WELL ...JP

Signature: _____
 (Department)

Signature: _____
 (Owner/Applicant/Contractor)

Print Name: Adam Murray

Date: 3/24/21

Payment Information

Permit	Receipt No.	Fee	Ref#1	Amount	Status	Ref#2	Amount	Status	Ref#3	Amount	Status
MAINPERMIT	21160103334	50.00	MURRAY CREDIT-CARD	50.00	PAID						



100 N King St
Hendersonville, NC 28792
Phone: 828-697-4830

Owner Exemption

STATE OF NORTH CAROLINA

Henderson County

Parcel Identification Number and address where the building is to be constructed: PIN 0612741271

Address: O Chimney Rock Rd Bat Cave NC

Type of Construction: Residential Commercial Industrial Other

Intended use after completion (e.g. Personal Residence): Well

Building permit number associated with this application: 21160105599

I, Adam Murrey (Print Full Name) 828 808 7508 (Phone Number)


Hereby claim exemption from licensure under by initialing numbers 1-4 below attesting to the following:

- 1. I certify I am the owner of the property set forth above on which a building is to be constructed or altered and for which application for a building permit is hereby made.
- 2. I will personally perform all work concerning the trade(s) checked below.
- 3. I will be present for all for the inspections for the trade(s) checked below.
- 4. I understand I am required by law to occupy the building for which the licensing exemption is granted for twelve months after completion, during which time it may not be rented, leased, sold or gifted.

[Signature] (Signature of Affidavit) 3/24/21 (Date)


Sworn or affirmed and subscribed before me this the 24th day of March, 2021

[Signature] (Signature of Notary Public)
Jennifer L Pickens (Printed Name of Notary Public)

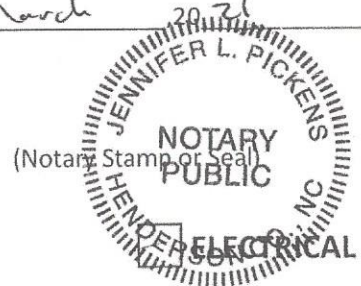

<input type="checkbox"/> MECHANICAL	<input type="checkbox"/> PLUMBING	<input type="checkbox"/> ELECTRICAL
OWNER EXEMPTION AFFIDAVIT	OWNER EXEMPTION AFFIDAVIT	OWNER EXEMPTION AFFIDAVIT
PURSUANT TO G.S. 87-21(a) (5)	PURSUANT TO G.S. 87-21 (a) (5)	PURSUANT TO G.S. 87-43 & 87-43.1

Tracts 18, 19, 20 existing Septic

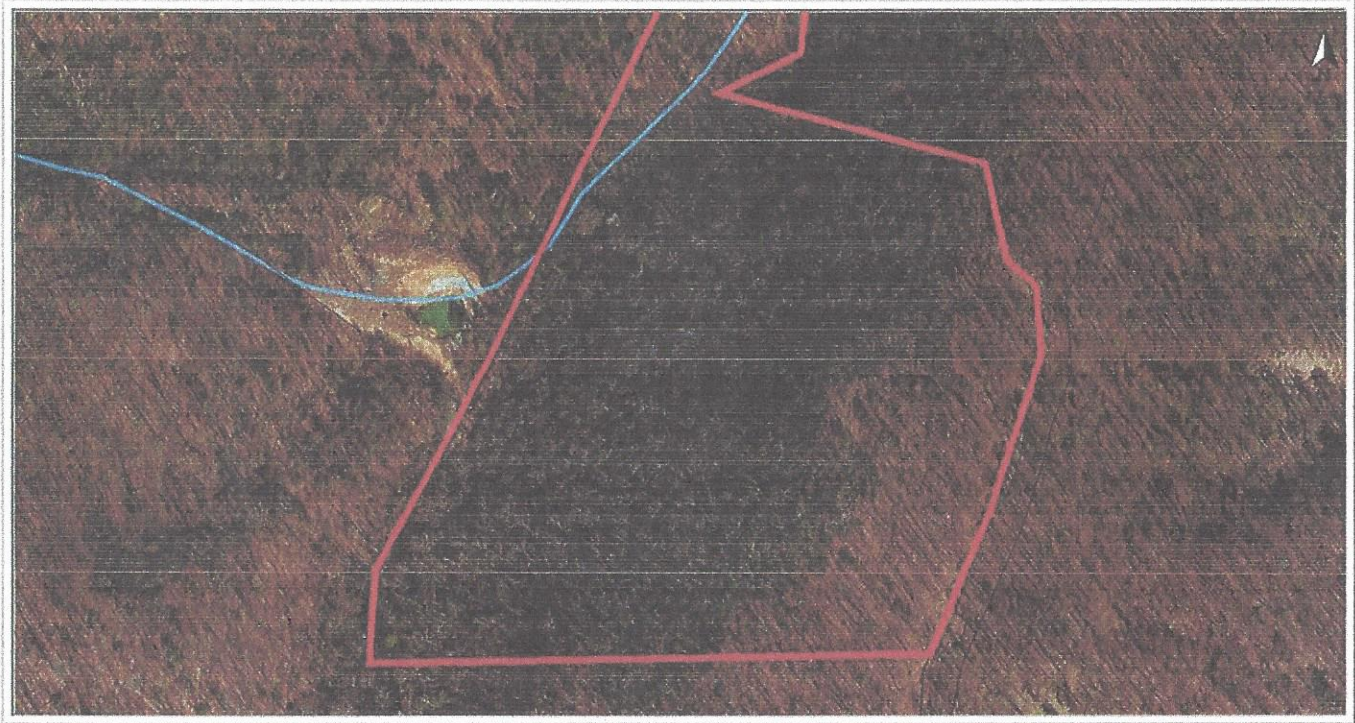

WARNING: THIS IS NOT A SURVEY

Parcel Information

REID:	10001151	Pin:	0613741271
Listed to:	MURRAY, ADAM RAY;MURRAY, HEATHER REBECCA	Neighborhood:	BAT CAVE
Mailing Address:	2840 CHIMNEY ROCK RD	Township:	Edneyville
Mailing City, State, Zip:	HENDERSONVILLE, NC 28792	Municipality:	
Physical Address:	0 NO ADDRESS ASSIGNED	Tax District:	BAT CAVE FIRE
Deed:	003420/00238	Plat:	C 267
Date Recorded:	2019-11-27 11:44:00.0	Elementary School District:	EDNEYVILLE
Revenue Stamps:	220	Middle School District:	APPLE VALLEY MIDDLE
County Zoning:	R3	High School District:	NORTH HIGH
Property Description:	HARDISON ESTATE 19.83 AC LO18-20	Soil:	Edneyville (edneytown) fine sandy loam, 25 to 45 percent slopes
Map Sheet:	0613.00	Voting Precinct:	Bat Cave
Assessed Acreage:	19.58000000	Commissioner District	4
Building Value:	\$0.00	Agricultural District	None Found
Land Value:	\$137,100.00	North Carolina House District	117
Value To Be Billed:	\$137,100.00	U.S. House District	11
North Carolina Senate District	48	Flood Zone:	Zone X, Not Shaded (Areas outside of the floodplain)




Henderson County
 Geographic Information Systems (GIS)
 200 North Grove Street
 Hendersonville, NC 28792
 P: (828) 698-5124
 F: (828) 698-5122

THIS IS NOT A SURVEY.

All information or data provided, whether subscribed, purchased or otherwise distributed, whether in hard copy or digital media, shall be at the user's own risk. Henderson County makes no warranties or guarantees, including the warranties of merchantability or of fitness for a particular purpose. Map data is not appropriate for, and is not to be used as, a geodetic, legal, or engineering base system. The data is not intended as a substitute for surveyed locations such as can be determined by a registered Public Land Surveyor, and does not meet the minimum accuracy standards of a Land Information System/Geographic Information System Survey in North Carolina (21 NCAC 56.1608).

Site Plan Not Shown to Scale

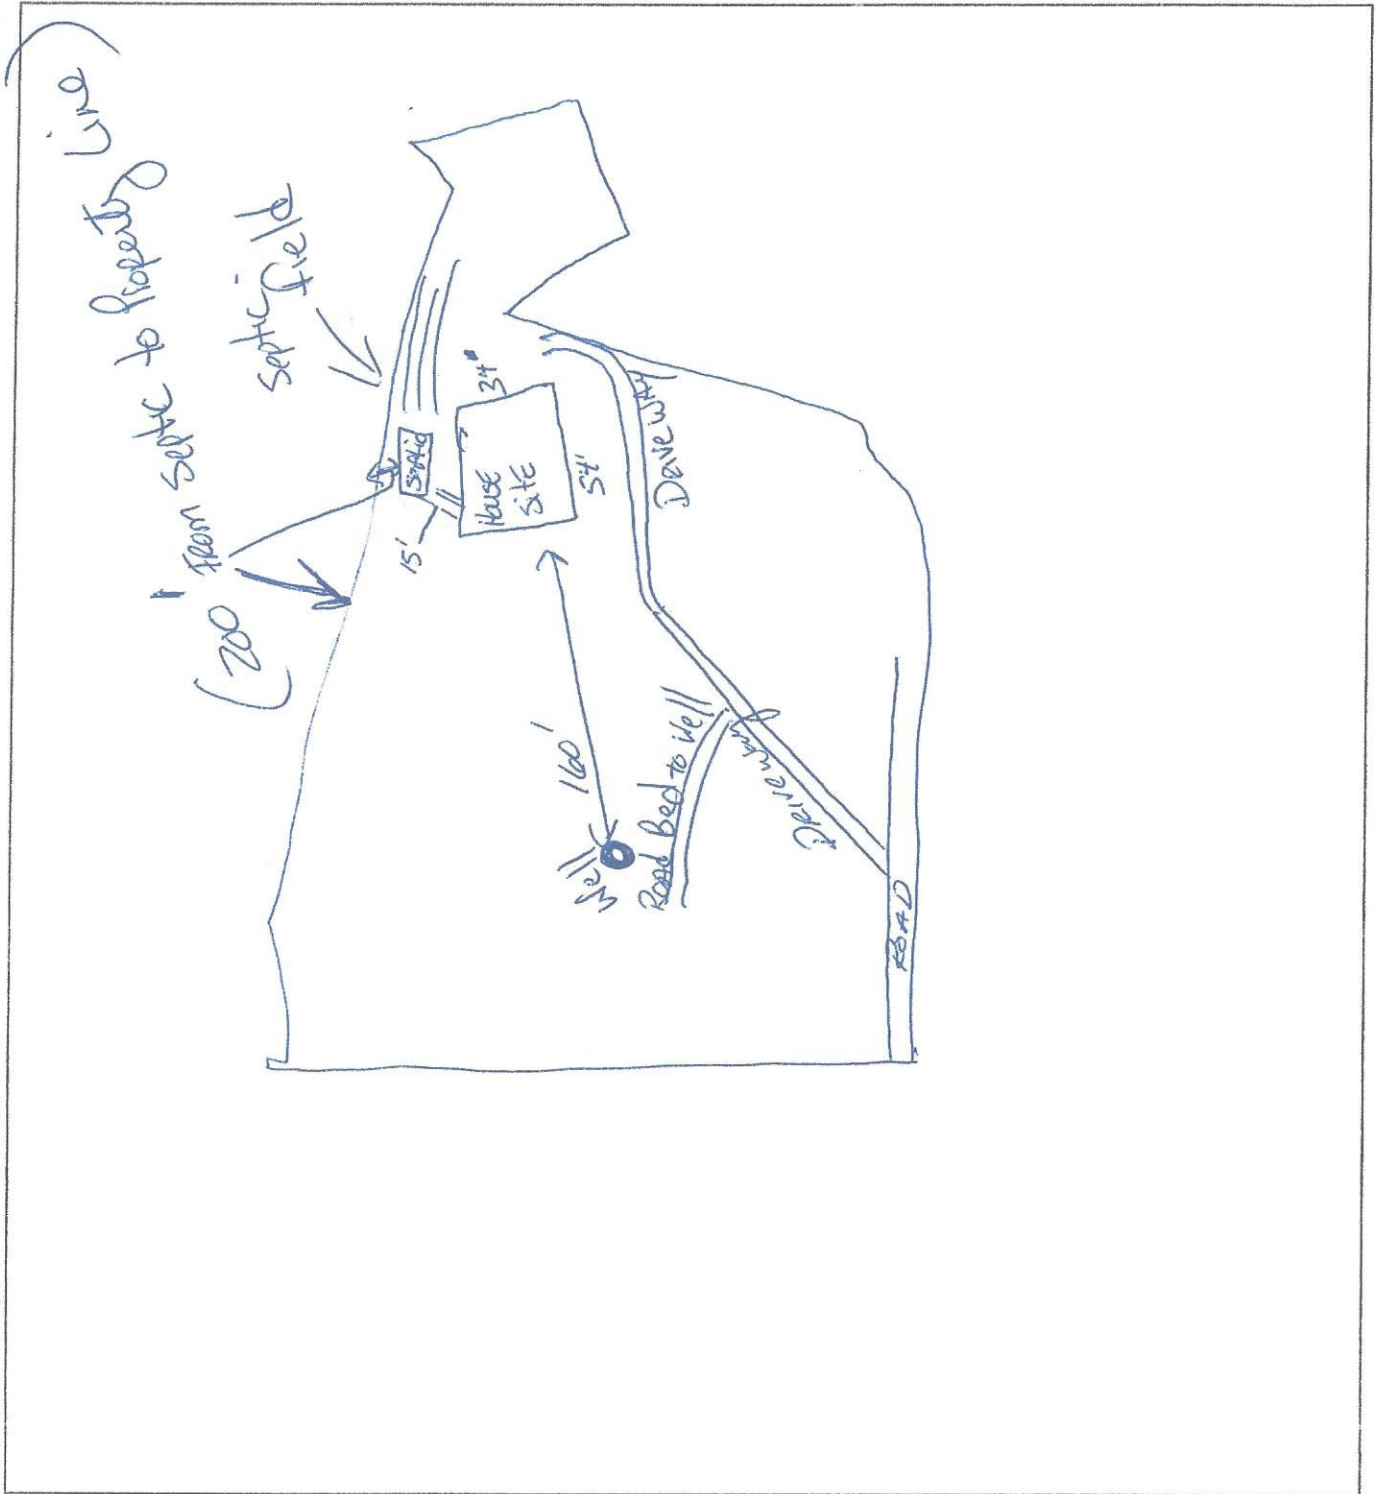

I hereby agree that the information shown is correct to the best of my knowledge. I understand that any changes to the property lines, building orientation, or location of driveways may void this site plan and require a new site evaluation by environmental health or result in a change to the property address.


Signature of Authorized Agent/Owner

1/4/21
Date

Permits & Inspections

Search Project/Permit#

Go User: BWOODRING Logout

Projects My Inspections Reports/Letters Options Help

EH Legacy Permit

Legacy EH Permit Details

Legacy Permit # 1-2241 Status Approved
 Appl. Dt. 07/13/1979
 New Permit #

[Print Form](#)

Permit Details

PIN #			
Building Type	HOUSE	Number of beds	3
Basement Plumbing	N		

Site Details

Water Supply	INDIVIDUAL	Site Eval	PROVISIONAL
Tank Size	1250	Drain Field	1000
Tank Cons Type	NEW-CONSTRUC	Septic Tank Ins	RHODES

Well Details

Imp. Permit #		Collector	
Well Driller		WC Date	
Name On Sample		Sample Date	

Property/Owner Details

Owner Name	TRICE,CHARLES		
Address1			
Address2			
Lot	1 A +	Tel #	
Directions	TURN L AT W.A. BURCH THROUGH STONE PILLARS		

Other Details

Comp No	C-3029	Comp Date	06/27/1980
Ins.Comp.ID	FRANK HERBERT		
WI		WC	

[Cancel](#)

[Submit](#)

Current Database: **HENDERSON**



Henderson County Department of Public Health

Steven E. Smith, MPA, Health Director | Seth Swift, R.H.E.S., Environmental Health Supervisor

1200 Spartanburg Highway, Suite 100, Hendersonville, NC 28792
Main Phone: (828) 694-6060 | Administration FAX: (828) 697-4523

Public Health
Prevent. Promote. Protect.

Septic and/or Well Permit Search Request

CONTACT INFORMATION:

Name: Jason Shepherd Date of Request: _____
Phone #: 828-423-9010
FAX #: _____ EMAIL: jason@lookingglassrealty.com

PROPERTY INFORMATION

Address (REQUIRED) Tract 26 off Chimney Rock Rd
Subdivision: Hardison Estates Lot# Tract 26

List Current and All Previous Owners of Property (If the ownership records do not go back as far as the date the house was built, we may have difficulty finding a record. Please make sure to include as much information as possible): Adam Murray + Heather Murray 2015

Jeff Rogers + Holly Scott ~~1990~~ 1992

Connie P. Norton + Carolyn Carter 1990

J. R. Heaton

S.G. Norton W. Scott Shepherd 1977

Previous Road Name(s): Jeep Rd?

Year Residence was Built: _____ PIN: 0613645860

Please submit your completed request to:

Fax # 828-697-4523

Email: HCDPH_EnvHealth@hendersoncountync.gov

ENVIRONMENTAL HEALTH DEPARTMENT SEARCH RESULTS:

Search Completed by: SW Date: 7/31/2022

Record Located Copy Attached

No Record Located

Incomplete property information provided unable to process



Public Health
Prevent. Promote. Protect.

Tract 18, 19, 20 Septic Request

Henderson County Department of Public Health

Steven E. Smith, MPA, Health Director | Seth Swift, R.H.E.S., Environmental Health Supervisor

1200 Spartanburg Highway, Suite 100, Hendersonville, NC 28792
Main Phone: (828) 694-6060 | Administration FAX: (828) 697-4523

Septic and/or Well Permit Search Request

CONTACT INFORMATION:

Name: Jason Shepherd Date of Request: 7/29/22
Phone #: 828-423-9010
FAX #: _____ EMAIL: jason@lookingglassrealty.com

PROPERTY INFORMATION

Address (REQUIRED) Tract 18, 19, 20 Chimney Rock Rd
Subdivision: Hardison Estates Lot# Tract 18, 19, 20

List Current and All Previous Owners of Property (If the ownership records do not go back as far as the date the house was built, we may have difficulty finding a record. Please make sure to include as much information as possible): Adam + Heather Murray 2019

Clyde + Jan Whitener 1995
Charles + Velma Trice 1976

Previous Road Name(s): Jeep Rd. ?
Year Residence was Built: Not Completed PIN: 0613741271

Please submit your completed request to:

Fax # 828-697-4523

Email: HCDPH_EnvHealth@hendersoncountync.gov

ENVIRONMENTAL HEALTH DEPARTMENT SEARCH RESULTS:

Search Completed by: [Signature] Date: 7/31/2022

- Record Located Copy Attached
- No Record Located
- Incomplete property information provided unable to process