

Pisgah Forest Farms Trawick, Benjamin

Transylvania County Health Department
IMPROVEMENTS PERMIT / CERTIFICATE OF COMPLETION
Subsurface Sanitary Sewage Systems

(Article 11 of Chapter 130A of the General Statutes of North Carolina)

IMPROVEMENT PERMIT IS VALID FIVE (5) YEARS FROM DATE OF ISSUANCE

9515-06-1443-000

Date: 20 August 92

Tax ID No.:

Owner/Agent: Benjamin Trawick

Receipt No.: 2460

Address: 205 Pisgah Forest Drive Pisgah Forest
379 Facecraker, Orlando FL, 32809

Phone No.: 407 240 8975

Location of Property: Pisgah Forest Farms Lot 11. Approx 1/2 mi. up on R.

Subdivision: Pisgah Forest Farms Lot Number: 11 Section: Plat of Property:



Type of Facility: House Mobile Home Business Other Basement Yes No Basement Plumbing Yes No

Number of Bedrooms: 3 Number of Bathrooms: 2 1/2 Estimated Sewage Flow: 360

Lot Size: 1.76 acres approx 3 acres approx Easements, Right-of-Ways, etc.: Date Lot Recorded: pre '83

Type of Water Supply: Private: Drilled Well Spring Shared Supply Public/Community

Signature/Authorized Agent: [Signature] Date:

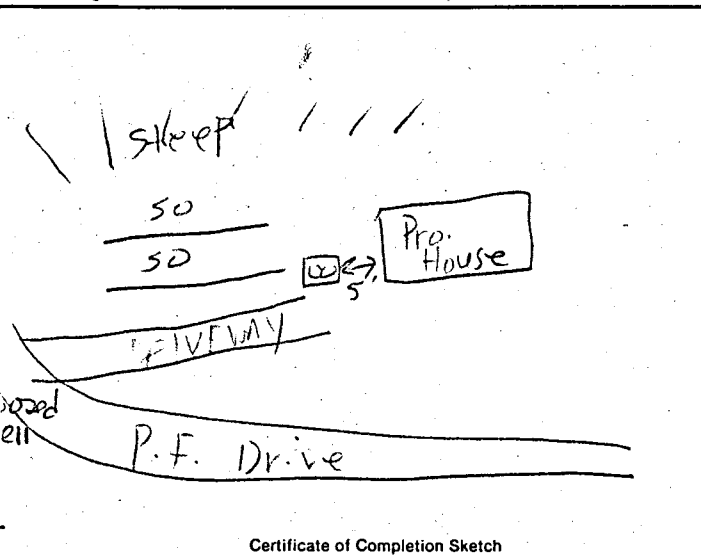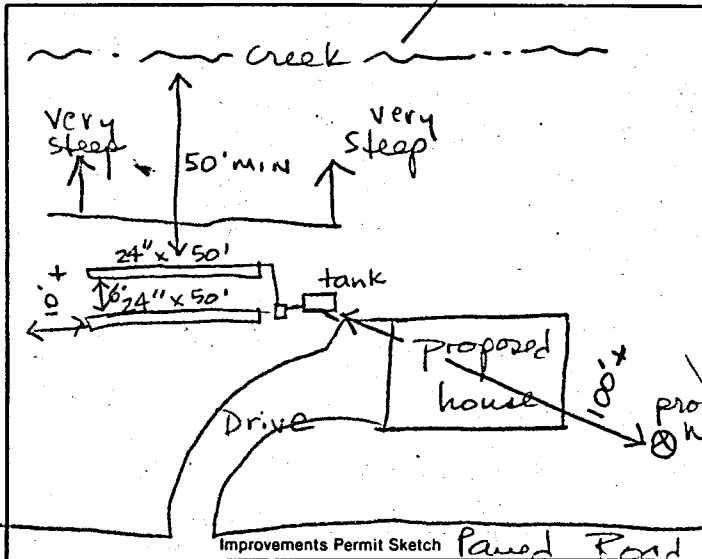

Nitrification trenches shall be installed on level grade with contour. Stepdowns permitted only when indicated.

New System Repair Addition

Size of Tank: 1000 Application Rate: .6

No. of Lines: 2 Width: 24" Linear Ft.: 50'

Square Ft.: 600 Maximum Trench Depth: 24"

I understand and agree to install the septic tank system as specified on this Improvements Permit. Permit is void if any changes are made without consent of the Health Department Representative and/or if any false information is supplied in making Improvements Permit.

Signature/Authorized Agent: [Signature] Date: 9/21/92

Building Contractor: [Signature]

System Installed by: Ron Hubbard

This is to certify that system is installed according to Rules and Regulations but is not a guarantee that it will function satisfactorily for any given period of time.

By: Jeff McCall, RS 8.11.97 Date

EXISTING SYSTEM: Addition/Remodeling Relocation

Other

System functioning properly at time of inspection and is approved for proposed additions/renovations or other improvements.

By: Date:

* Recommend - Install septic system prior to start of house foundation. Color Codes: Certificate of Completion, Owner - White; Health Dept. - Green; Improvements Permit - Pink

* Drainfield shall be the PPBPS (PANEL) system.

TRANSYLVANIA COUNTY HEALTH DEPARTMENT

Existing System Inspection Report

(For Building Inspection Department)

Date: 6-8-06

Tax ID No.: 9515-06-1443-000

Receipt No.: 182212 \$50

Owner/Agent: TRAWICK, BENJAMIN

Address: 53 Pisgah Forest Dr.

Pisgah Forest, NC

Phone Number: 862-8682

Date System Installed: 8-11-97

Name(s) of Original Permittee:

Directions to property: Everette Rd. to Hart Rd. - right on Pisgah Forest Drive - 53 about 1/2 mile up mt. on right - 53 on mailbox on left side of drive

Original Cert. of Completion
Name: Benjamin Trawick
Date: 8-11-97

Subdivision: Pisgah Forest Farms Section: Lot No.: 11

Inspection requested for:

- Mobile home setup, Addition, Business, Remodeling, Connection to unused system, Other

No. of bedrooms upon connection/completion: Current no. of Bedrooms:

Remarks: carport

Owner/Agent Signature: Benjamin J. Trawick Date: 6-8-06

At the time of the inspection there was no visible evidence of a malfunction in the system. The system is approved for proposed connections/additions/renovations or other improvements.

Signed: James A Boyer, RS Date: 6/9/06

THIS REPORT IS VALID THROUGH 9/9/06

