

PIN: 8581-59-6787-000 File Name: 3400 East Fork Road Permit No.: 19-146

TRANSLYVANIA COUNTY DEPARTMENT OF PUBLIC HEALTH

Operation Permit

New _____ Repair _____ **Addition/Expansion**

No. of Bdrms: 3 System Type: II Proprietary Name: Infiltrator IQ4 chamber

Porter, Robert Landon Bradley # 3876
Owner's Name System Installer and Certification Number

James A Bayer, R.E.H.S. 11/21/2019
Authorized State Agent Date of Operation Permit Issuance

This system has been installed in compliance with applicable NC General Statutes, Rules for Sewage Treatment and Disposal and all conditions of the Improvement Permit and Construction Authorization

Septic Tank Manufacturer: Infiltrator IM 1060 STB- 2071 Date of Manufacture: N/A
Filter Brand: Polylok PL-68

See "as built" drawing for system location and measurements.


New system to serve the existing 3 bedroom house. The garage apartment will use the 2 BR system installed 10/8/93 (Sherrill Woods).

Conditions/Comments: Clean and replace septic tank effluent filter as required.

Subsurface system operator required? No X Yes _____ If yes, see attached sheet for additional operation conditions, maintenance and reporting.

The septic tank should have all compartments pumped out every 3-5 years, on average, or when the solids are more than 1/3 of the liquid depth in any compartment. Depending upon trench depth, maximum fill over the drainfield cannot exceed two feet. Establish cover over drainfield and divert surface waters to prevent erosion or degradation of the system. No part of the septic system should be subjected to: traffic or any other compaction; vegetation with aggressive and/or hydrophilic (water loving) root systems such as maples or willows; excessive fill or heavy landscaping materials such as rocks/boulders; or any other activities or circumstances that may alter site conditions and may cause problems with the initial system or the repair area as permitted.


Ink Heater
1060 IM
STB2071
PL-68

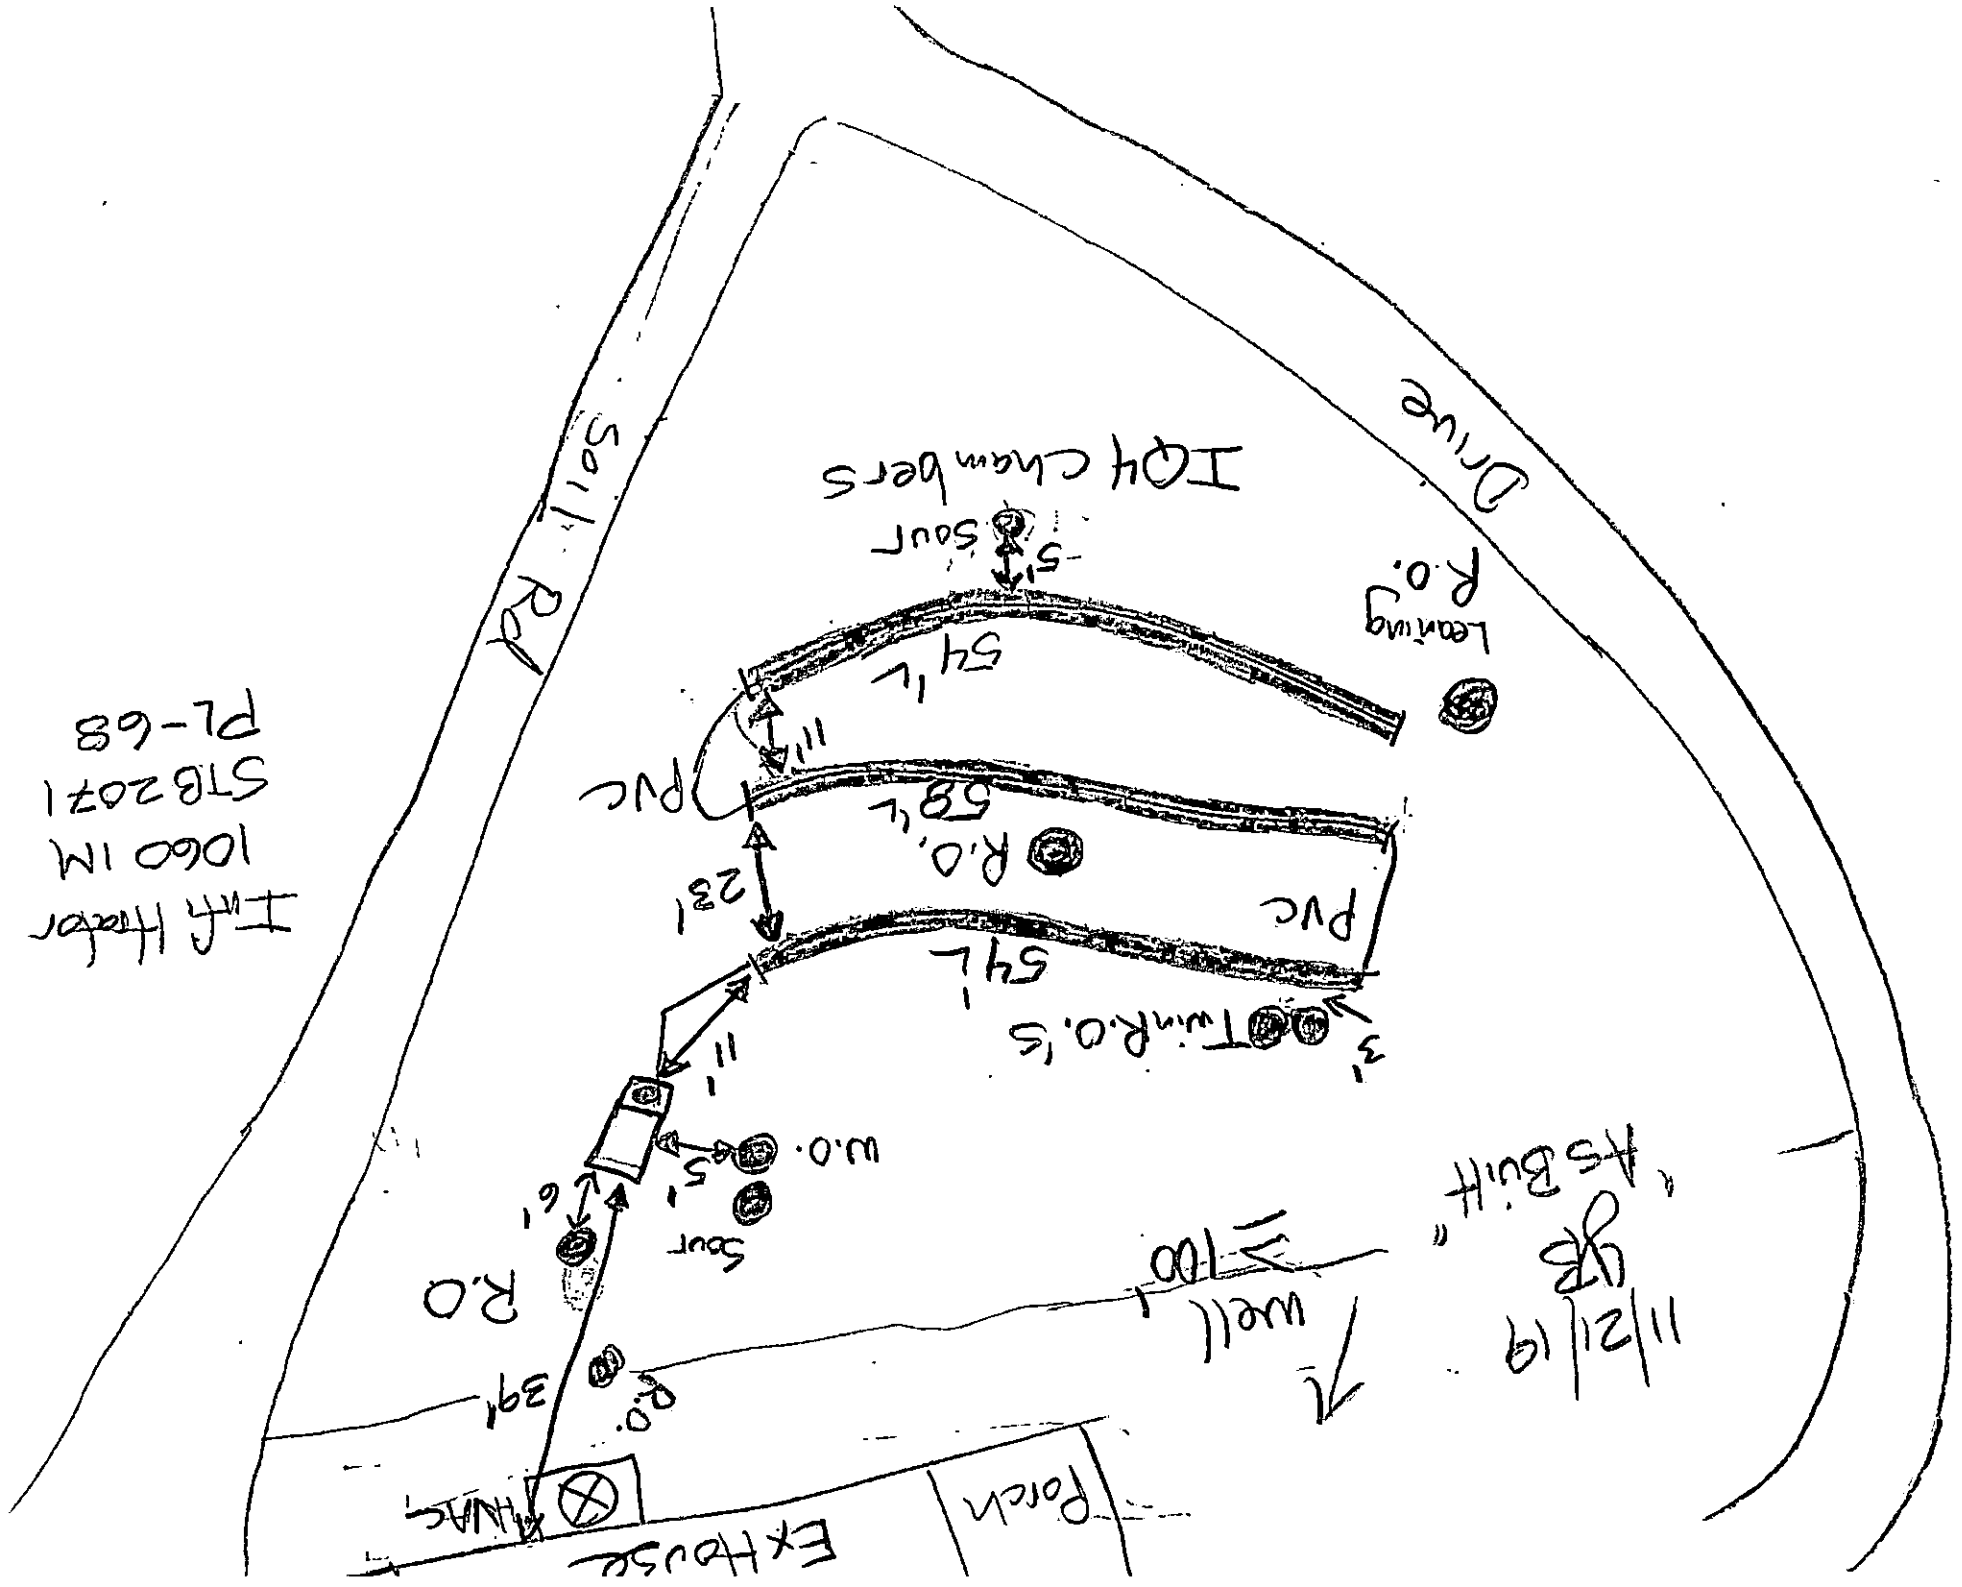

TRANSYLVANIA COUNTY DEPARTMENT OF PUBLIC HEALTH IMPROVEMENT PERMIT DIAGRAM

File Name: PORTER, ROBERT & DENISE Permit No.: 19-146 PIN: 8581-59-6787-000
3400 EAST FORK RD.

KEEP SEPTIC AND REPAIR OUT
 OF PLACEMENT OR
 RIGHT OF WAYS.
 KEEP EXISTING 2BR SEPTIC
 FOR UN-LAW SITE - NEW
 SEPT SYSTEM WILL SERVE
 EXISTING 3BR HOME.
 CALL EARTH DEPT WITH
 ANY QUESTIONS.
 GO TO PLAN SEPTIC AND
 REPAIR BUT REPAIR
 AREA STILL LEGAL.
 180' TOTAL OF DRAIN
 LINES (35' x 30")
 EXHIBIT ON OTHER SHEET

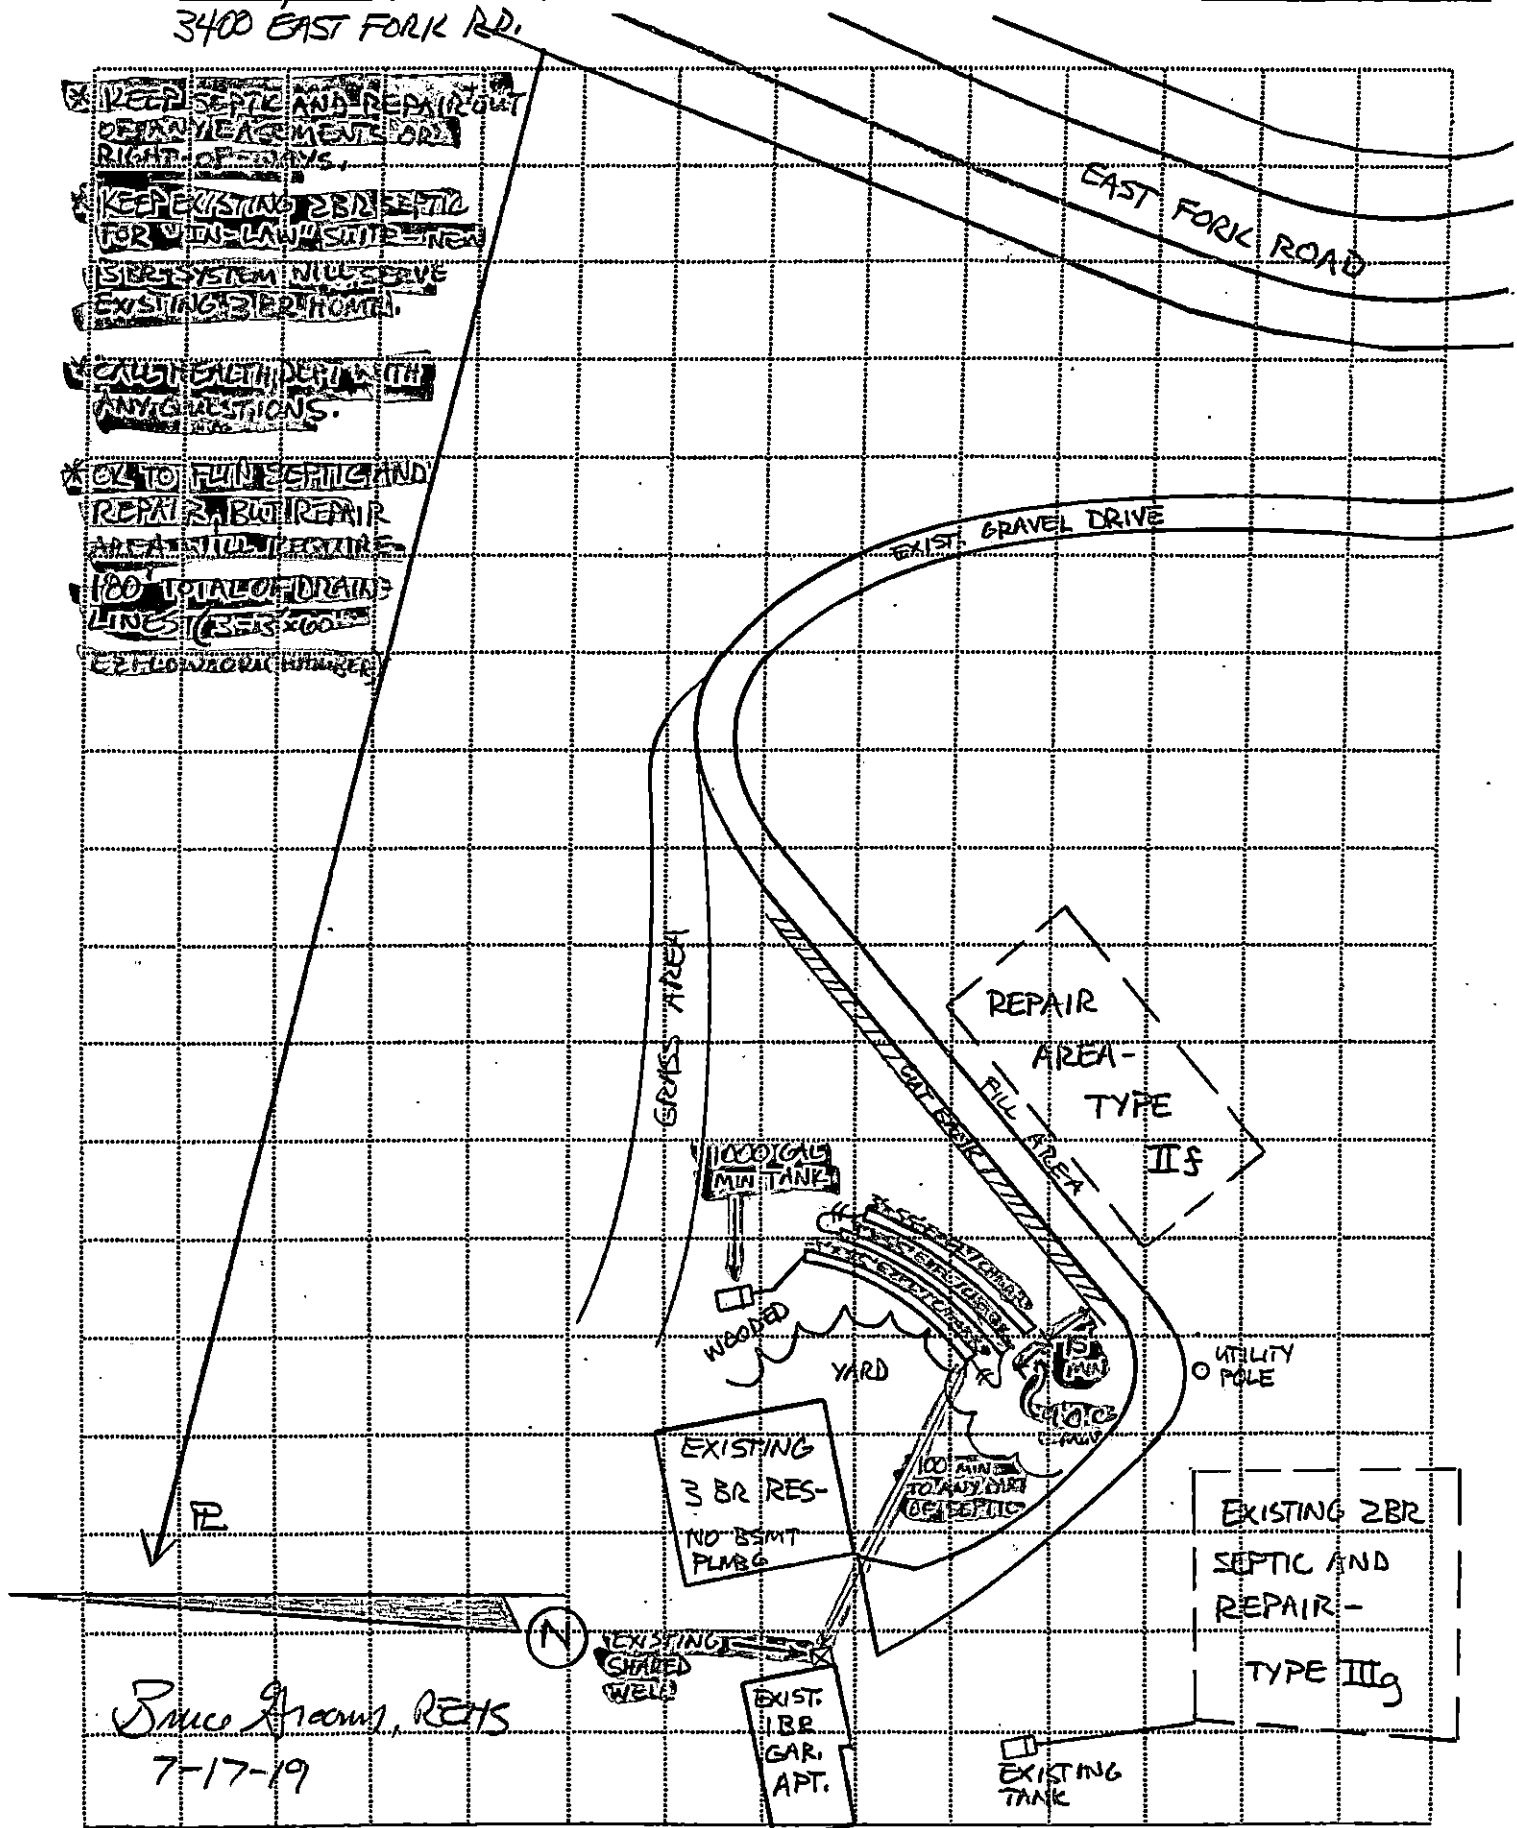

James Adams, REHS
 7-17-19

SCALE: 1" = 60' APPROX.