


TRANSYLVANIA COUNTY HEALTH DEPARTMENT

(Sewage disposal system) Improvements Permit and Certificate of Completion


(Ground Absorption Sewage Disposal System - Section 130 - 160 of Chapter 130 of the General Statutes of North Carolina)

OWNER-OCCUPANT Edwin Ridden BUILDING CONTRACTOR same
 LOCATION top of hill → to left of green well house → new rd to V
 SUBDIVISION Pisgah Forest Farms LOT NO. 1 SECT. OR BLOCK NO. 2
 SEPTIC TANK CONTRACTOR Howard Sloanell ADDRESS Hendersonville

HOUSE MOBILE HOME BUSINESS
 NO. BEDROOMS 3 NO. BATHROOMS 2
 SIZE OF SEPTIC TANK 855 GALS. (Liquid) _____
 MATERIAL: PRE-CAST BLOCK FIBERGLASS
 DISTRIBUTION BOX YES NO
 NO. OF LINES 3 WIDTH 3 FT. LENGTH 70 FT.
 PERCOLATION TEST YES NO 100
 WATER SUPPLY: INDIVIDUAL PUBLIC
 SITE CLASSIFICATION: SUITABLE
 PROV. SUITABLE ?
 UNSUITABLE ?

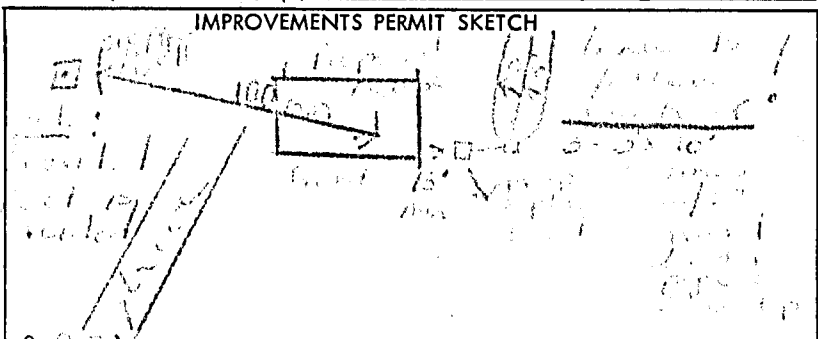

IMPROVEMENTS PERMIT: DATE: 1/11/80
 BY: [Signature]
 CERTIFICATE OF COMPLETION: DATE: 5/27/80
 BY: [Signature]

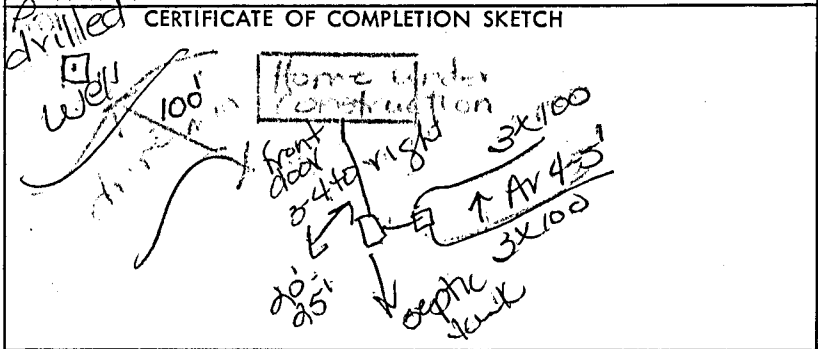

NOTICE: System installed according to Rules and Regulations but not a guarantee that it will function satisfactorily for any given period of time.

COLOR CODE: White - Owner; Pink - Improvements Permit; Blue - Contractor; Yellow - Inspection Dept.; Green - Health Dept.