

Windover Farms

①

Transylvania County Health Department  
IMPROVEMENTS PERMIT / CERTIFICATE OF COMPLETION  
Subsurface Sanitary Sewage Systems

(Article 11 of Chapter 130A of the General Statutes of North Carolina)

IMPROVEMENT PERMIT IS VALID FIVE (5) YEARS FROM DATE OF ISSUANCE

8574-41-8988-000  
JK  
7/20/14

Tax ID. No.: T29-2H-00-010  
Receipt No.: 3008  
Phone No.: 883-9895

Date: 29 June 94  
Owner/Agent: Agent-Lloyd Fisher--Owner Glen Matheny

Address: Fisher Realty 232 S. Caldwell Brevard  
Location of Property: Country Club to Island Ford turn left at stop sign, 1/4 mile to Windover Farms, Next lot after 3rd house on left.

Subdivision: Windover Farms Lot Number: 26 Section: Plat of Property: ✓

Type of Facility: House  Mobile Home  Business  Other  Basement Yes  No  Basement Plumbing Yes  No

Number of Bedrooms: 3 Number of Bathrooms: 2.5 Estimated Sewage Flow: 360

Lot Size: 1.70 Easements, Right-of-Ways, etc.: Date Lot Recorded:

Type of Water Supply: Private: Drilled Well  Spring  Shared Supply  Public/Community

Signature/Authorized Agent: Lloyd M. Fisher Date: 7/18/94

see attached drawings and comments

Improvements Permit Sketch

Certificate of Completion Sketch

Nitrification trenches shall be installed on level grade with contour. Stepdowns permitted only when indicated.

New System  Repair  Addition

Size of Tank: 1000 GA Application Rate: .5

No. of Lines: 3 Width: 36" Linear Ft.: 90' ea

Square Ft.: 720 Maximum Trench Depth: 18" low side

I understand and agree to install the septic tank system as specified on this Improvements Permit. Permit is void if any changes are made without consent of the Health Department Representative and/or if any false information is supplied in making Improvements Permit.

Lloyd M. Fisher 7/18/94  
Signature/Authorized Agent Date

By: [Signature] 7/18/94  
Date

Building Contractor: Mark Willis  
System Installed by: Mark Willis

This is to certify that system is installed according to Rules and Regulations but is not a guarantee that it will function satisfactorily for any given period of time.

By: Jeff McCall, RS 9.30.97  
Date

EXISTING SYSTEM: Addition/Remodeling  Relocation   
Other

System functioning properly at time of inspection and is approved for proposed additions/renovations or other improvements.

By: \_\_\_\_\_ Date

TRANSYLVANIA COUNTY HEALTH DEPARTMENT IMPROVEMENT PERMIT DIAGRAM

Date: 7/18/94

Tax ID No: 729240000

Owner/Agent: Glen Matheny (Lloyd Fisher)

Receipt No: 3008


Address: Fisher Realty 2325 Caldwell Boulevard

Phone No: 883-9895

Location of Property: Country Club @ to Island Ford turn @ go ~ 1/4 mile to Window Farms next lot after 3rd house on @

Subdivision: Window Farms Lot No: 36 Section: - Plat of Property:

All parts of the septic tank system shall be located at least 100', or the maximum feasible distance from any well, but in no case less than 50 feet.

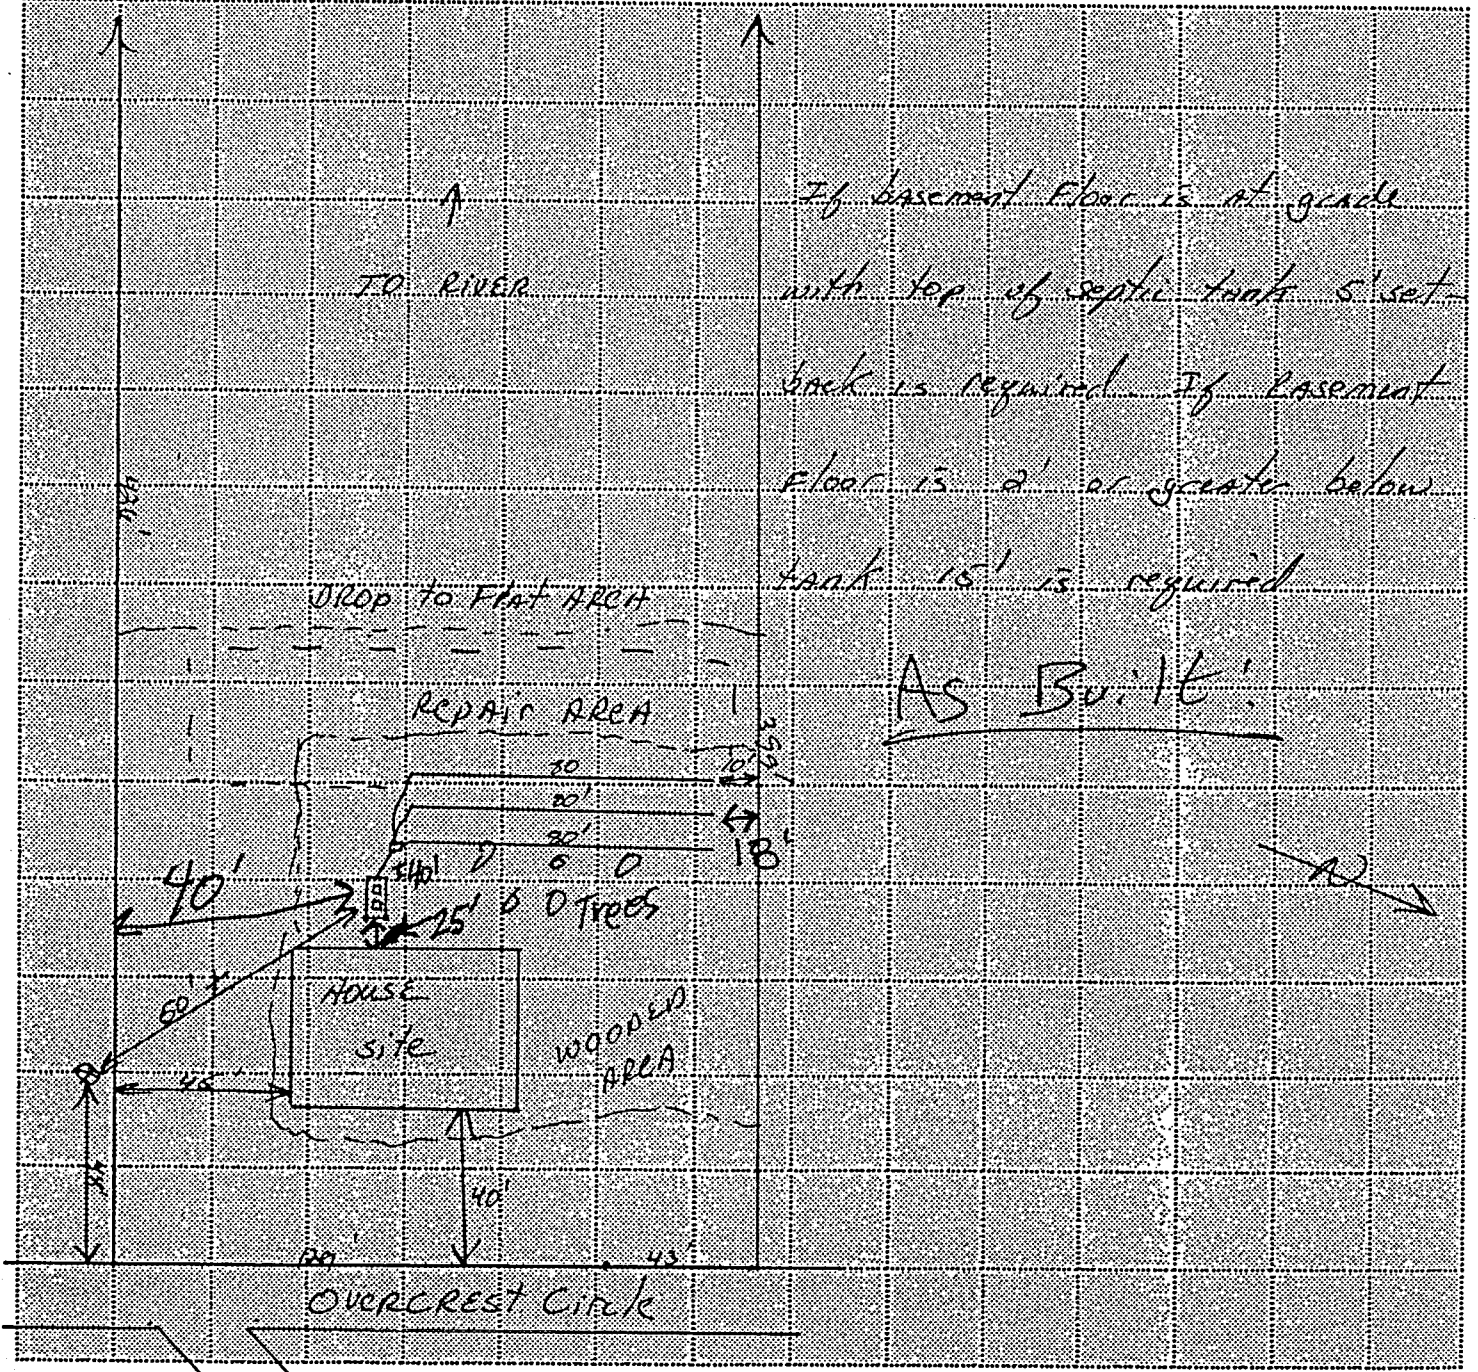

Minimum distance between trenches shall be 9 feet, on center.

Scale 1" : 50 feet

Keep trenches level, on contour, and shallow (maximum depth 18" on the low side of trench). Trench width is 36 inches.