


Henderson County (Environmental) – Existing System Permit

1200 Spartanburg Highway, Suite 100, Hendersonville, N.C. 28792
 Phone:(828)692-4223
 Fax:(828)697-4523

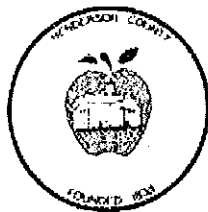

Project No: 15010105098
Permit No: 15090105101 **App. Dt.:** 4/15/2015 **Exp. Dt.:** 8/13/2015
Status: INSPECTION DUE **Status Dt.:** 4/15/2015

Owner Information

Name : Cynthia Schirmer
Address : 1000 Butternut Trl
 Hendersonville NC 28739
Phone(W) : 6922595
Phone(H) :
Phone(M) :

Property Information

PIN # : 9557533112
Address : 1000 Butternut Trl
 Hendersonville NC 28739
Acreage : 0.86
Subdivision : Sugar Hollow
Lot # : 92
Directions : 25S, right on Kanuga Rd, right on Kanuga Lake Rd, right on Sugar Hollow Rd 1st house on right Butternut Trl

Watershed district :

Site Details

System Type :
System Description :
Line Length :
Line Depth :
Nitrification Sq. Ft. :
Tank #1 :
Tank #2 :
Tank #3 :

Applicant Information

Name : Cynthia Schirmer
Address : 1000 Butternut Trl
 Hendersonville NC 28739
Phone(W) : 6922595
Phone(H) :
Phone(M) :

Occupant Information

Name : Cynthia Schirmer

Water Details

System : New
Source : PUBHEND

Property Characteristics

Type of establishment : Residential dwelling units
Number of establishment : 3 Bedrooms
Septic GPD : 360
Basement : No
Basement Bath : No
Garbage Disposal : No
Multiple Dwelling Units : No
Property Notes : 16X32 IN GROUND POOL WITH CONCRETE DECK...LS

Notes : 16X32 IN GROUND POOL WITH CONCRETE DECK...LS

Inspections Conducted

Inspections	Signed Off/User ID	Date	Status	Reason
Existing System Inspection				

Payment Information


Permit	Receipt No.	Fee	Ref#1	Amount	Status	Ref#2	Amount	Status	Ref#3	Amount	Status

MAINPERMIT	15090102875	60.00	SCHIRMER CREDIT-CARD	60.00	PAID									
Total			60.00											

Signature: 
(Department)

Signature: 
(Owner / Applicant)

Date: 4/15/15

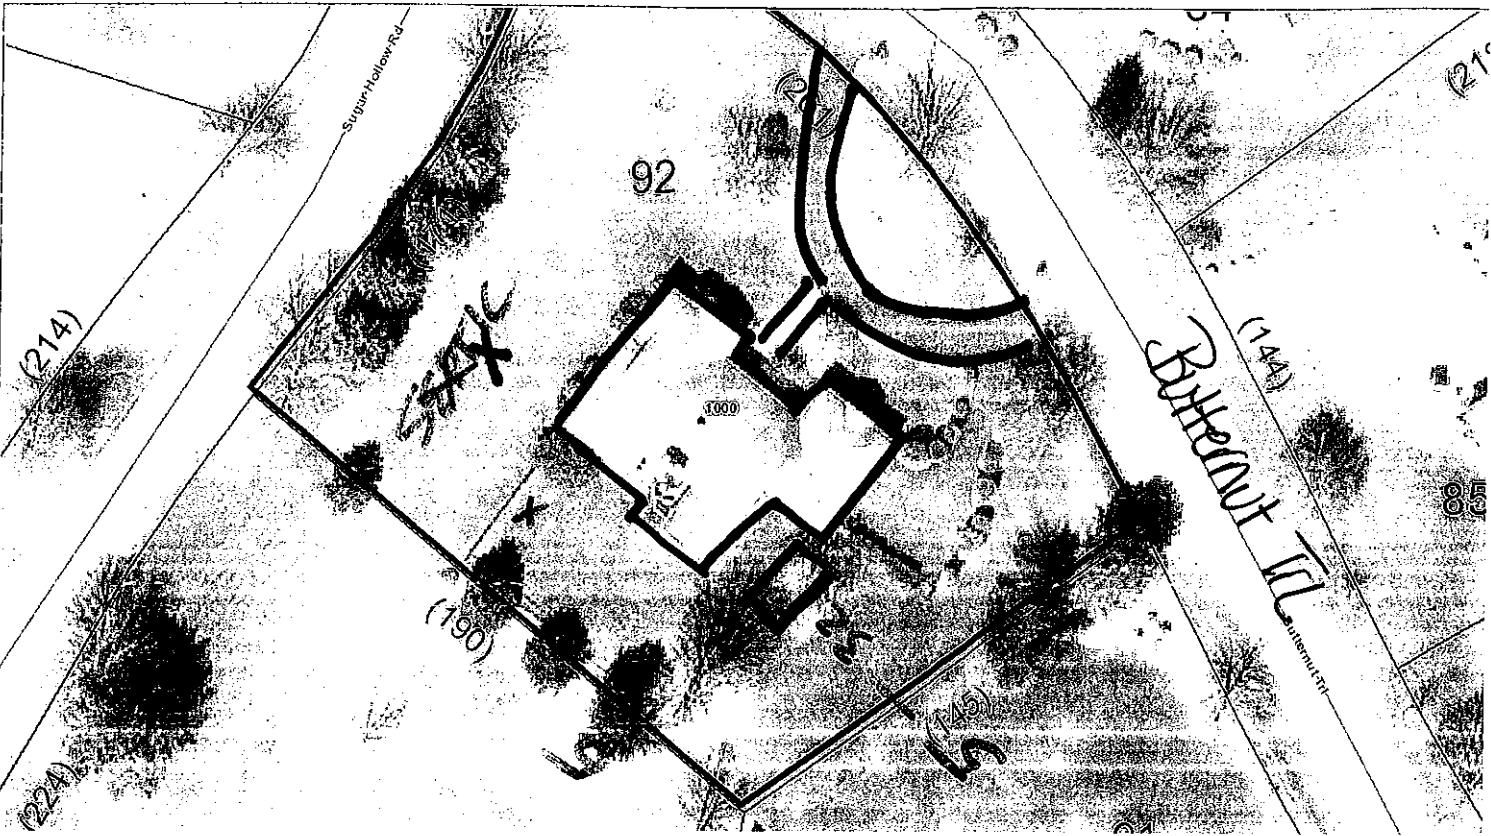

WARNING: THIS IS NOT A SURVEY.
 All information or data provided (whether subscribed, purchased or otherwise distributed) is provided as is, without any warranties, including the warranties of merchantability or of fitness for a particular purpose. A Henderson County and its employees make no warranties or guarantees, either express or implied. A Use of the information or data subscribed, purchased or otherwise distributed, whether in hard copy or digital media, shall be at the user's own risk.



Henderson County
 Government
 Geographic
 Information Systems
 (GIS)
 200 North Grove Street
 Hendersonville, NC
 28792
 P - 828-698-5124 | F -
 828-698-5122



Parcel Information

Registered To:	SCHIRMER, CYNTHIA L	Jurisdiction:	UNINCORPORATED
Mailing Address:	1000 BUTTERNUT TRL	Tax District:	02 Valley Hill Fire
Mailing City, State, Zip Code:	HENDERSONVILLE, NC 28739	County Zoning:	R-40
Physical Address:	1000 BUTTERNUT TRL	Flood Zone:	Property is outside of the floodplain
Physical Address Zip:		Watershed:	
Parcel Number:	9938653	Protected Ridges Buffer:	
APN:	9557533112	Perennial Streams:	
Neighborhood:	SUGAR HOLLOW	Soils:	Hayesville loam, 7 to 15 percent slopes
Assessed Acreage:	0.8600	Agricultural District:	
Deed:	1538/103	Future Land Use:	Urban Service Area
Date Recorded:	06/27/2013		