

21-227, 2-1-22



TRANSYLVANIA COUNTY DEPARTMENT OF PUBLIC HEALTH
WELL PERMIT OR WELL REPAIR PERMIT.
CERTIFICATE OF COMPLETION

New Well Repair To Existing Well []

WP21-108 8591-18-7839-000 Graham, Biff
Permit No. Parcel I.D. Issued To
21 Bucks crossing Big Hill, S6, Lot 107
Property Street Address Subdivision /Sec/Lot#

Well Grouting Inspection

Casing Type PVC Casing Thickness/Weight SDR 21 Casing Depth 86'
Diameter 6 1/4" Grout Type Bentonite / Grout Depth 20'
Grout Method Pump/pour Hole plug

Inspected By: James a Bayer, REHS Date: 2/22/22

Well Head Inspection

Inches Above Grade 12" ✓ Air Vent ✓ Threadless Sample Tap ✓
Sanitary Seal ✓ (if hose bib) Anti-Siphon Present n/a Well Plate ✓
Pump Plate ✓ Well Depth 305' Static Water Level 60' Yield 15 gpm

Contractor McCrary
Certification # 3156
Date 3/8/22 Depth 280'
Horsepower 1 HP FWH

Inspected By: Jaylen Sloop REHS Date: 7/28/22

Well Report Received (GW-1a)

Well Contractor McCrary / Matt Parker Certification # 3156


Issued By Jaylen Sloop REHS Date 7/28/22

TRANSYLVANIA COUNTY WELL PERMIT DIAGRAM

File Name: Big Hill, S6, Lot 107
 Graham, Biff
 TBD Green Hollow Lane

Well Permit # WP21-108

PIN: 8591-18-7839-000

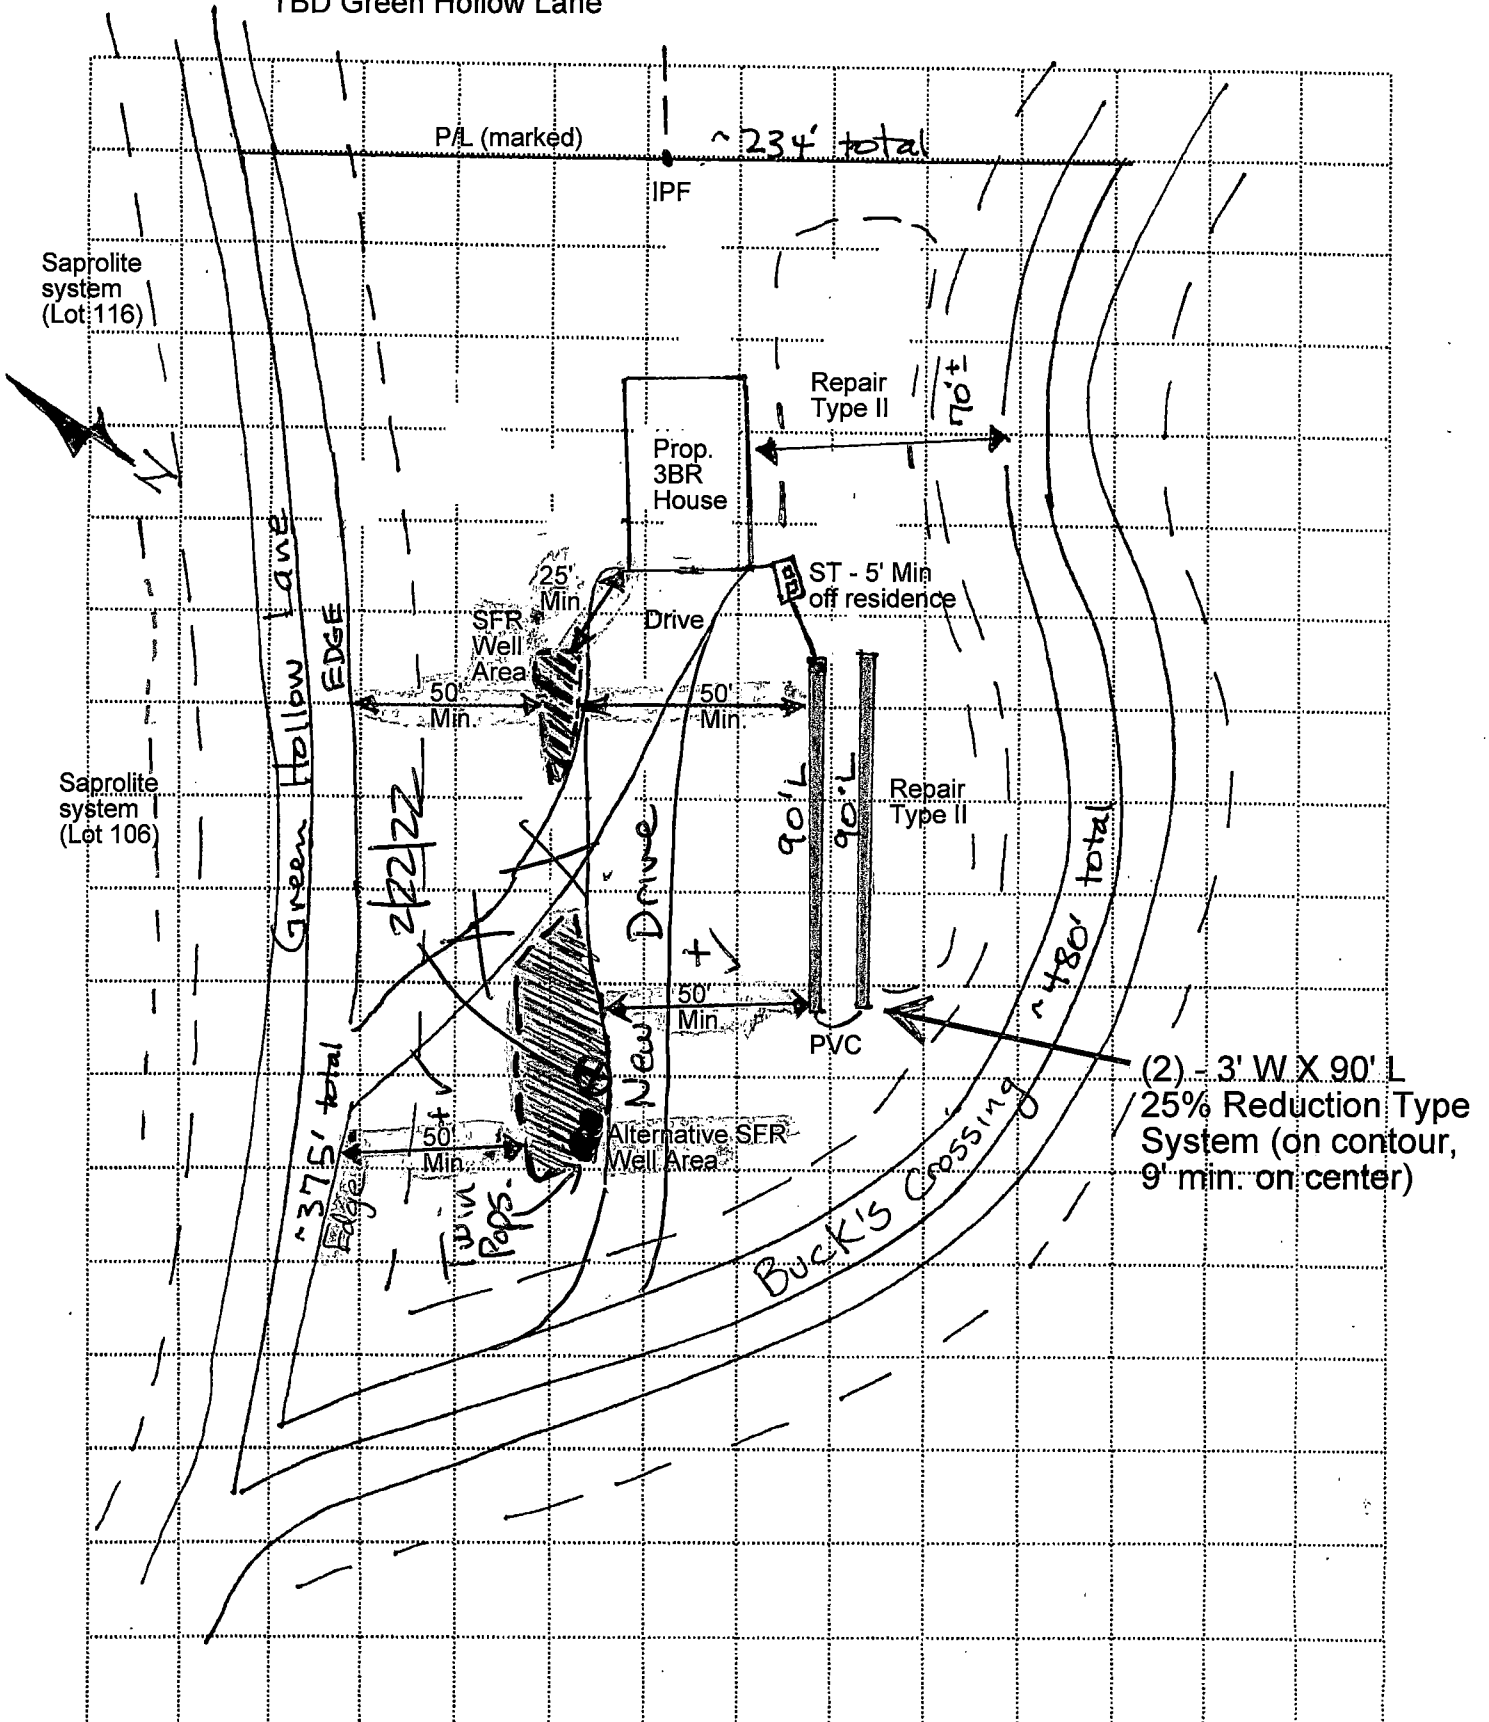

(2) - 3' W X 90' L
 25% Reduction Type
 System (on contour,
 9' min. on center)

SCALE: 1" = 50'
 (approx.)