

File Name: PISGAH FOREST ESTATES

TRANSYLVANIA COUNTY HEALTH DEPARTMENT ON-SITE WASTEWATER DISPOSAL APPLICATION

9505-75-5155-000
Pin #/Tax ID -6017
393 \$150
Receipt No _____

JK
5-73

Permit #: 07-112

Agent/Owner: Linerunner

Mailing Address: _____

Home Phone #: () _____

Work Phone #: () _____

Proposed Buyer: ADLER, HARVEY

Mailing Address: c/o Greg Mills 884-4488 or 280-9036
Evergreen Realty

Home Phone #: () _____

Work Phone #: () _____

Property Location: 2292 Pisgah Forest, Drive
Road/Street

Subdivision: Pisgah Forest Estates Phase/Sec.: _____ Lot #: 3-A

Directions to property: Everette Road to Hart Road to right into Pisgah Forest Estates - stay on Pisgah Forest Drive - bear rt to last lot on right

Flood Zone	
Is the property in a flood zone? -	
<input type="checkbox"/> Yes	<input type="checkbox"/> No <input type="checkbox"/> Unknown
Inspections	
Flood Zone	
<input type="checkbox"/> Yes	<input type="checkbox"/> No
<input type="checkbox"/> Approved	<input type="checkbox"/> Disapproved
Initials _____	Date _____

Installation for: Mobile Home Single Double House No. Bedrooms: 3 Basement: Yes No With Plumbing: Yes No Ind./Commercial Other

If Indust./Commercial/Other: Number of employees: _____ Operation: (Describe) _____ Property contains designated wet lands: Yes No

Lot size: 2.35 Date lot recorded: _____ Right of ways, easements, etc. no Water Supply: Private: Spring Well Shared Supply Public/Community

I certify the above to be correct to the best of my knowledge. Permission is hereby granted to perform a site/soil evaluation on the property described above. If the information submitted in this application is falsified or changed, the permit shall become void. I understand that it is my responsibility as the applicant/agent/owner to comply with all applicable ordinances, laws, and rules from other agencies that may affect the development of this property.

Applicant/Agent Signature: Greg Mills

Date: 8-10-03

ON-SITE WASTEWATER DISPOSAL SYSTEM OPERATIONS PERMIT

The issuance of this operations permit certifies that the system described on the improvement permit and the construction authorization is properly installed or repaired and that the system is capable of being operated in accordance with the conditions of the improvement permit, Article 11 of Chapter 130A of the General Statutes of North Carolina and the rules adopted pursuant to this Article. This operation permit shall remain in effect as long as the system is operated and maintained as required by the Laws and Rules for Sewage Treatment and Disposal Systems as issued by the North Carolina Department of Environment and Natural Resources, Division of Environmental Health.

System Classification Type: IIIg Management Entity: Owner Certified Operator Minimum inspection/maintenance review frequency _____ years.

Comments: EZ Flow installed (see faxed copy where the builder OK'd using EZ Flow)


Installed by: Theron McCall

Final Inspection by: Jim R. Adolph RS

Date: 5.9.03

FN

5.9.03
EZ Flow
serial fed

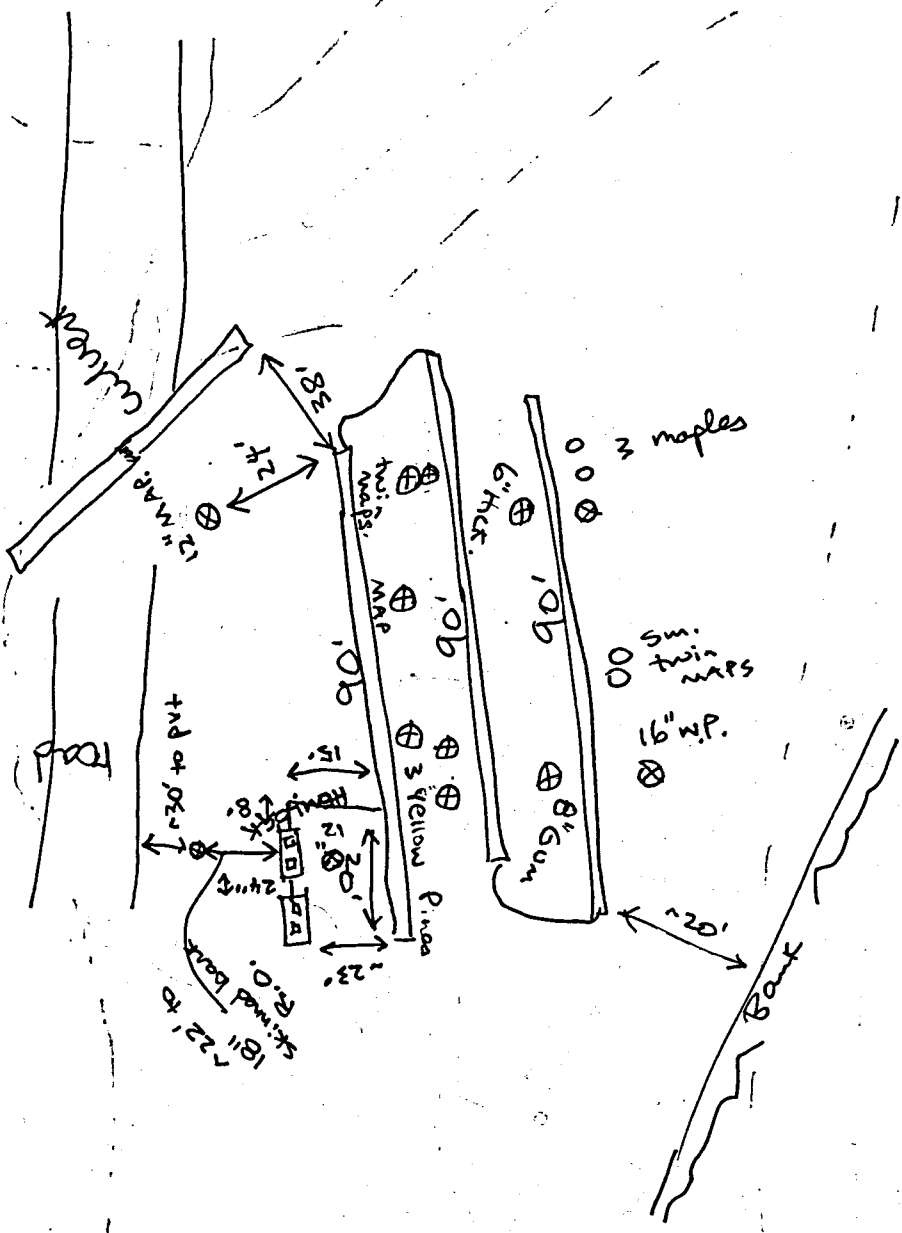

File Name: PISGAH FOREST ESTATES

**TRANSYLVANIA COUNTY HEALTH DEPARTMENT
ON-SITE WASTEWATER DISPOSAL APPLICATION**

9505-75-5169-000
Pin #/Tax ID

Permit #: 03-132

393 \$150

Receipt No _____

Agent/Owner: Linerunner

Mailing Address: _____

Home Phone #: () _____

Work Phone #: () _____

Proposed Buyer: ADLER, HARVEY

Mailing Address: c/o Greg Mills 884-4488 or 280-9036
Evergreen Realty

Home Phone #: () _____

Work Phone #: () _____

Property Location: Pisgah Forest, Drive Road/Street
Subdivision: Pisgah Forest Estates Phase/Sec.: _____ Lot #: 3-A

Directions to property: Everette Road to Hart Road to right into Pisgah Forest Estates - stay on Pisgah Forest Drive - bear rt to last lot on right

Flood Zone		
Is the property in a flood zone?		
<input type="checkbox"/> Yes	<input type="checkbox"/> No	<input type="checkbox"/> Unknown
Inspections		
Flood Zone		
<input type="checkbox"/> Yes	<input type="checkbox"/> No	
<input type="checkbox"/> Approved	<input type="checkbox"/> Disapproved	
Initials _____	Date _____	

Installation for: Mobile Home Single Double House No. Bedrooms: 3 Basement: Yes No With Plumbing: Yes No Ind./Commercial Other

If Indust./Commercial/Other: Number of employees: _____ Operation: (Describe) _____ Property contains designated wet lands: Yes No

Lot size: 2.37 after 1983

Date lot recorded: _____ Right of ways, easements, etc. NO Water Supply: Private: Spring Well Shared Supply Public/Community

I certify the above to be correct to the best of my knowledge. Permission is hereby granted to perform a site/soil evaluation on the property described above. If the information submitted in this application is falsified or changed, the permit shall become void. I understand that it is my responsibility as the applicant/agent/owner to comply with all applicable ordinances, laws, and rules from other agencies that may affect the development of this property.

Applicant/Agent Signature: *Gregory A. Mills*

Date: 2-10-03

**AUTHORIZATION FOR WASTEWATER SYSTEM CONSTRUCTION
(Diagram and Conditions Attached)**

New Installation: Repair/Addition: Original Permittee: _____ Dated: _____

Design waste flow: 360 GPD LTAR: 45 Septic Tank Capacity: (2) 1000 gal./min. Pump Tank Capacity: _____ gal./min. Proposed Wastewater System: pump to conventional

Drainfield: Total Trench Length: 270 ft. Square Footage: 810 Trench spacing: 9 ft. on ctr. Individual Trench Length: 90 ft. Maximum Trench Depth(Low Side): 24 in. Trench Width: 36 in.

Distribution Method: D-box or serial Min. distance between system and nearest: Well: 100 ft. Water line: 10 ft. Foundation: 15 ft. Property line: 10 ft. Vertical Cut: 15 ft.

Comments & Special Conditions: owner requests using grinder pump - pump to (2) 1000 gallon septic tanks, in series, above gravel drainfield; all plumbing from house to septic tanks to meet Nc Plumbing Code

Construction of the wastewater system for the permit indicated is hereby authorized. The wastewater system described in the Improvement permit has been designed and can be installed and operated in compliance with Article 11 of Chapter 130A of the General Statutes of North Carolina and Rules adopted pursuant to this Article. This Construction Authorization is valid for a period of 5 years from the original date of issue. The Construction Authorization must be renewed upon expiration prior to the installation/repair of the wastewater system, or prior to the issuance of any required building permits. A pre-construction conference with the owner or developer, or an agent of the owner or developer, and the health department will be required for re-issuance of the Construction Authorization.

I agree to install the wastewater disposal system in accordance with the improvement permit, construction authorization and any conditions specified therein.

Signed: *G. Mills*

Date: 4-8-03

Construction Authorization prepared by: *Allea Smith MS, RS*


Date: 4-7-03

PERMIT AND CONSTRUCTION AUTHORIZATION MUST BE ON SITE DURING ALL PHASES OF CONSTRUCTION/INSTALLATION AND INSPECTION

File Name: Harvey Adler/Pisgah Forest Estates

PIN: 9505-75-5169-000

Scale: 1" = 50' Permit No.: 03-138

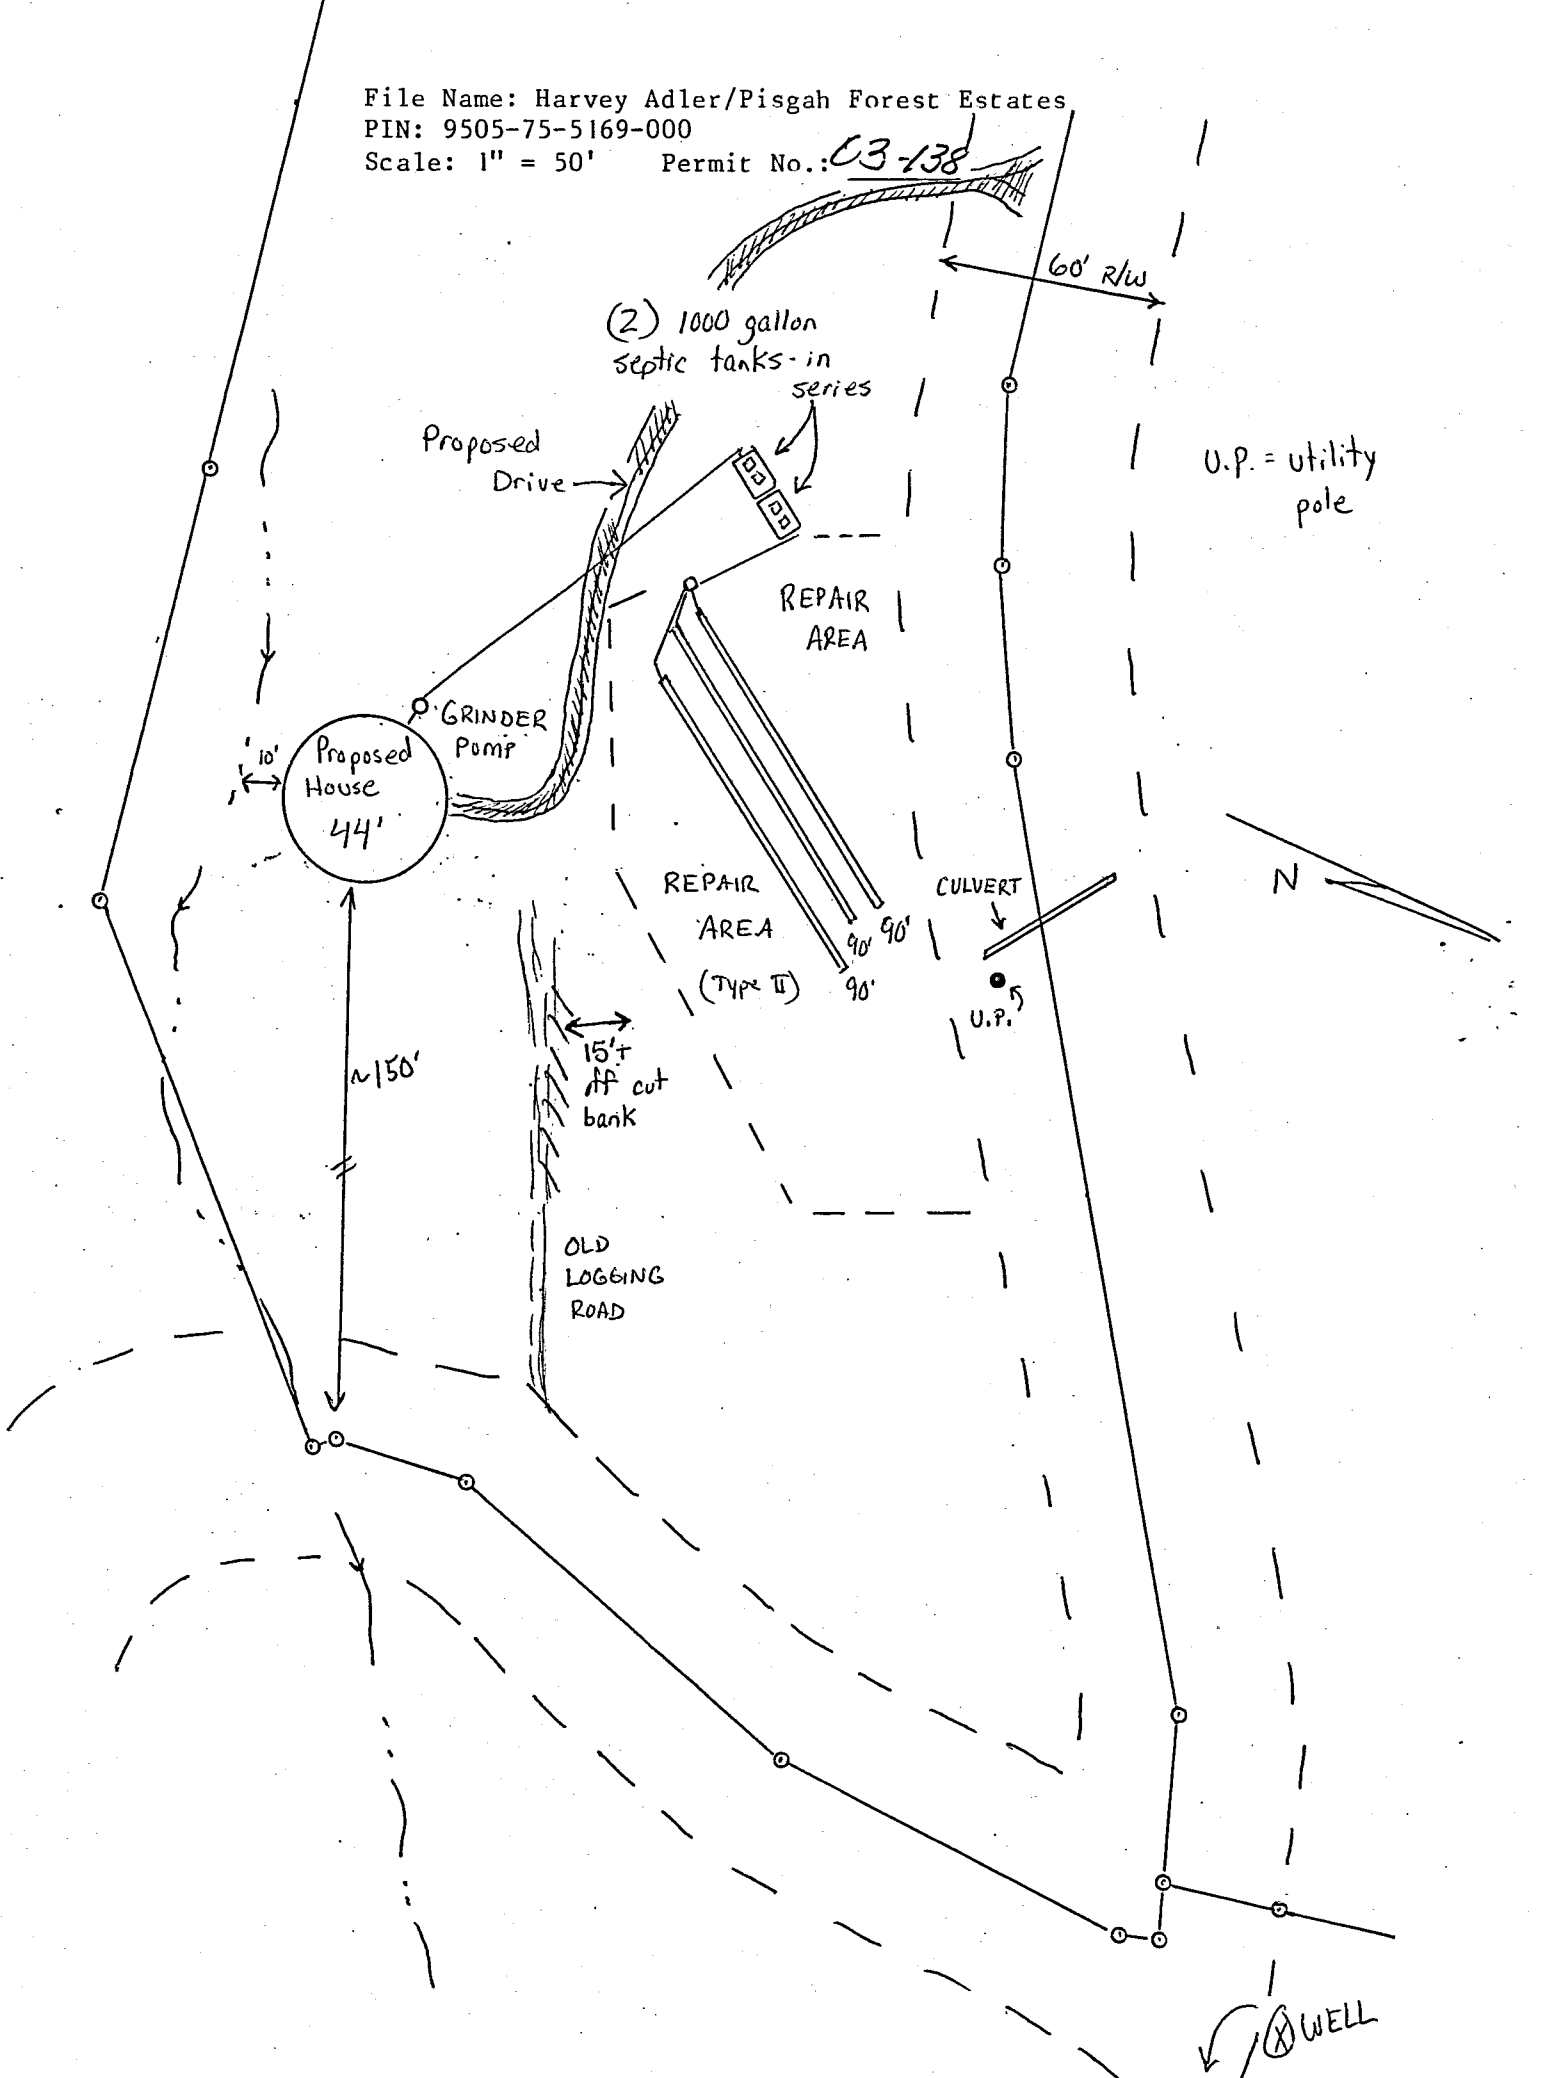

U.P. = utility pole

N

WELL