



TRANSYLVANIA PUBLIC HEALTH
WELL PERMIT/WELL REPAIR PERMIT

106 E Morgan St. Suite 105
Brevard, NC 28712
828-884-3139

WP 21-068

8575-22-6038-000

Galloway, Ernest

Permit No.

PIN


Issued To

Associated Permits: COC 8/1/1983; McCall, Vernon

Address/Location 156 Wood Road (off Bryson Road)

Scale 1" = NTS

Comments: SFR WELL - 50' MINIMUM SEPARATION REQUIRED BETWEEN WELL AND ANY PART OF ANY SEPTIC TANK SYSTEM.
25' MINIMUM SEPARATION REQUIRED BETWEEN WELL AND ANY PART OF ANY BUILDING FOUNDATION, DECK, PORCH, GARAGE, CARPORT, ETC.
SEE WELL PERMIT DIAGRAM FOR ALLOWABLE WELL LOCATION(S)
CONTACT TCDPH WITH ANY QUESTIONS!

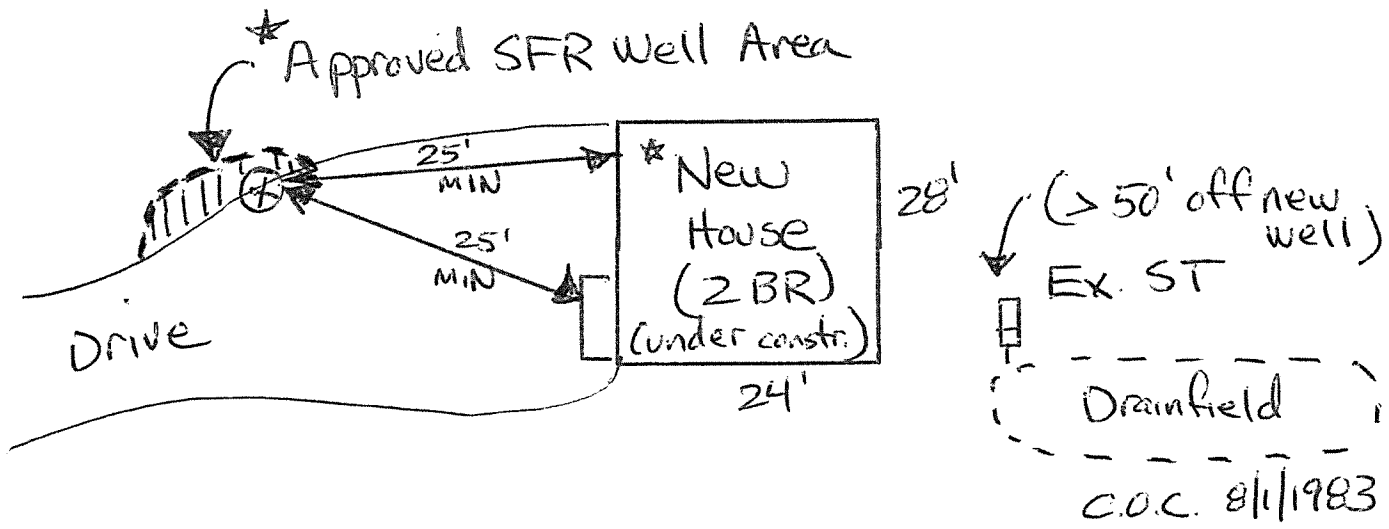

SIGN HERE

Permit valid for 5 years provided site conditions do not change. The well (well area) located by the Health Department is to provide protection from known possible sources of contamination. No quantity or quality of water is guaranteed at any site by the Health Department.

Issued by: James A. Bayer, RETHS
Issued to: Matthew Park

Date: 5/23/2021

Date: 5-11-22

Permit Expires: 5/23/2026


TRANSYLVANIA COUNTY HEALTH DEPARTMENT

(Sewage disposal system) Improvements Permit and Certificate of Completion


(Ground Absorption Sewage Disposal System - Section 130 - 160 of Chapter 130 of the General Statutes of North Carolina)

OWNER-OCCUPANT Vernon McCall BUILDING CONTRACTOR _____
 LOCATION Dryson Creek Rd. (off Rosman Hwy) → main → left →
 SUBDIVISION _____ LOT NO. _____ SECT. OR BLOCK NO. top of hill on left
 SEPTIC TANK CONTRACTOR Allison Ditching ADDRESS Etowah

HOUSE MOBILE HOME BUSINESS
 NO. BEDROOMS 2 NO. BATHROOMS 2
 SIZE OF SEPTIC TANK 855 GALS. (Liquid) _____
 MATERIAL: PRE-CAST BLOCK FIBERGLASS
 DISTRIBUTION BOX YES NO
 NO. OF LINES 3 WIDTH 10 FT. LENGTH 60 FT.
 PERCOLATION TEST YES NO 40
 WATER SUPPLY: INDIVIDUAL PUBLIC
 SITE CLASSIFICATION: SUITABLE ?
 PROV. SUITABLE ?
 UNSUITABLE

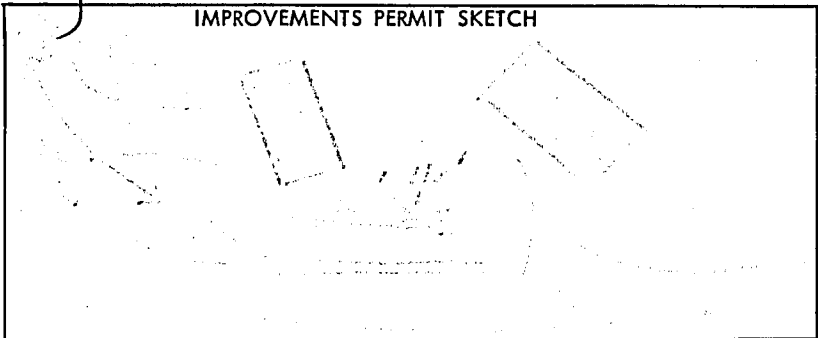

IMPROVEMENTS PERMIT: DATE: _____
 BY: _____
 CERTIFICATE OF COMPLETION: DATE: 8/1/03
 BY: _____

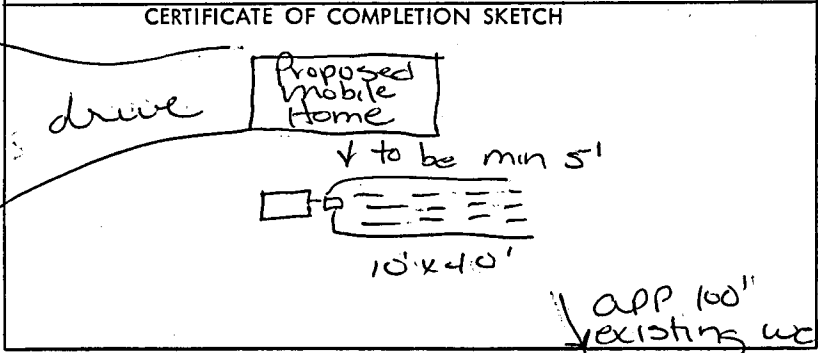

NOTICE: System installed according to Rules and Regulations but not a guarantee that it will function satisfactorily for any given period of time.

COLOR CODE: White - Owner; Pink - Improvements Permit; Blue - Contractor; Yellow - Inspection Dept.; Green - Health Dept.