

Henderson County (Environmental) – Existing System Permit

1200 Spartanburg Highway, Suite 100, Hendersonville, N.C. 28792
 Phone:(828)692-4223
 Fax:(828)697-4523



Project No: 20010108522
Permit No: 20090108566
Status: APPLIED FOR
Appl. Dt.: 6/4/2020
Exp. Dt.: 10/2/2020
Status Dt.: 6/4/2020

Owner Information

Name : Thomas James
Address : 292 Shady Summit rd
 Hendersonville NC 28792
Phone(W) :
Phone(H) :
Phone(M) : 828 5519760

Property Information

PIN # : 9670747447
Address : 292 Shady Summit Rd
 Hendersonville NC 28792
Acreage : 1.03
Subdivision : Sr1584 Off Holbert Rd
Lot # :
Directions : 292 SHADY SUMMIT RD: 64E L
 HOWARD GAP R OLD HOLBERT RD
 R SHADY SUMMIT STAY L ONTO
 DIRT RD THRU THE WOODS

Watershed district :

Site Details

System Type :
System Description :
Line Length :
Line Depth :
Nitrification Sq. Ft. :
Tank #1 :
Tank #2 :
Tank #3 :

Notes :

Applicant Information

Name : Thomas James
Address : 292 Shady Summit rd
 Hendersonville NC 28792
Phone(W) :
Phone(H) :
Phone(M) : 828 5519760

Occupant Information

Name : Thomas James

Water Details

System : New
Source : PRIVATE

Property Characteristics

Type of establishment : Residential dwelling units
Number of establishment : 2 Bedrooms
Septic GPD : 240
Basement : No
Basement Bath : No
Garbage Disposal : No
Multiple Dwelling Units : No
Property Notes : 24' X 24' DETACHED GARAGE...JP REFER TO I-06245A

Inspections Conducted

Inspections	Signed Off/User ID	Date	Status	Reason
Existing System Inspection				

Payment Information


Permit	Receipt No.	Fee	Ref#1	Amount	Status	Ref#2	Amount	Status	Ref#3	Amount	Status
MAINPERMIT	20090105221	100.00	JAMES CREDIT-CARD	100.00	PAID						
Total			100.00								

Signature: *Jennifer Pickens*

(Department)

Signature: see site plan COVID-19
(Owner/Applicant)

Date: 6/4/2020

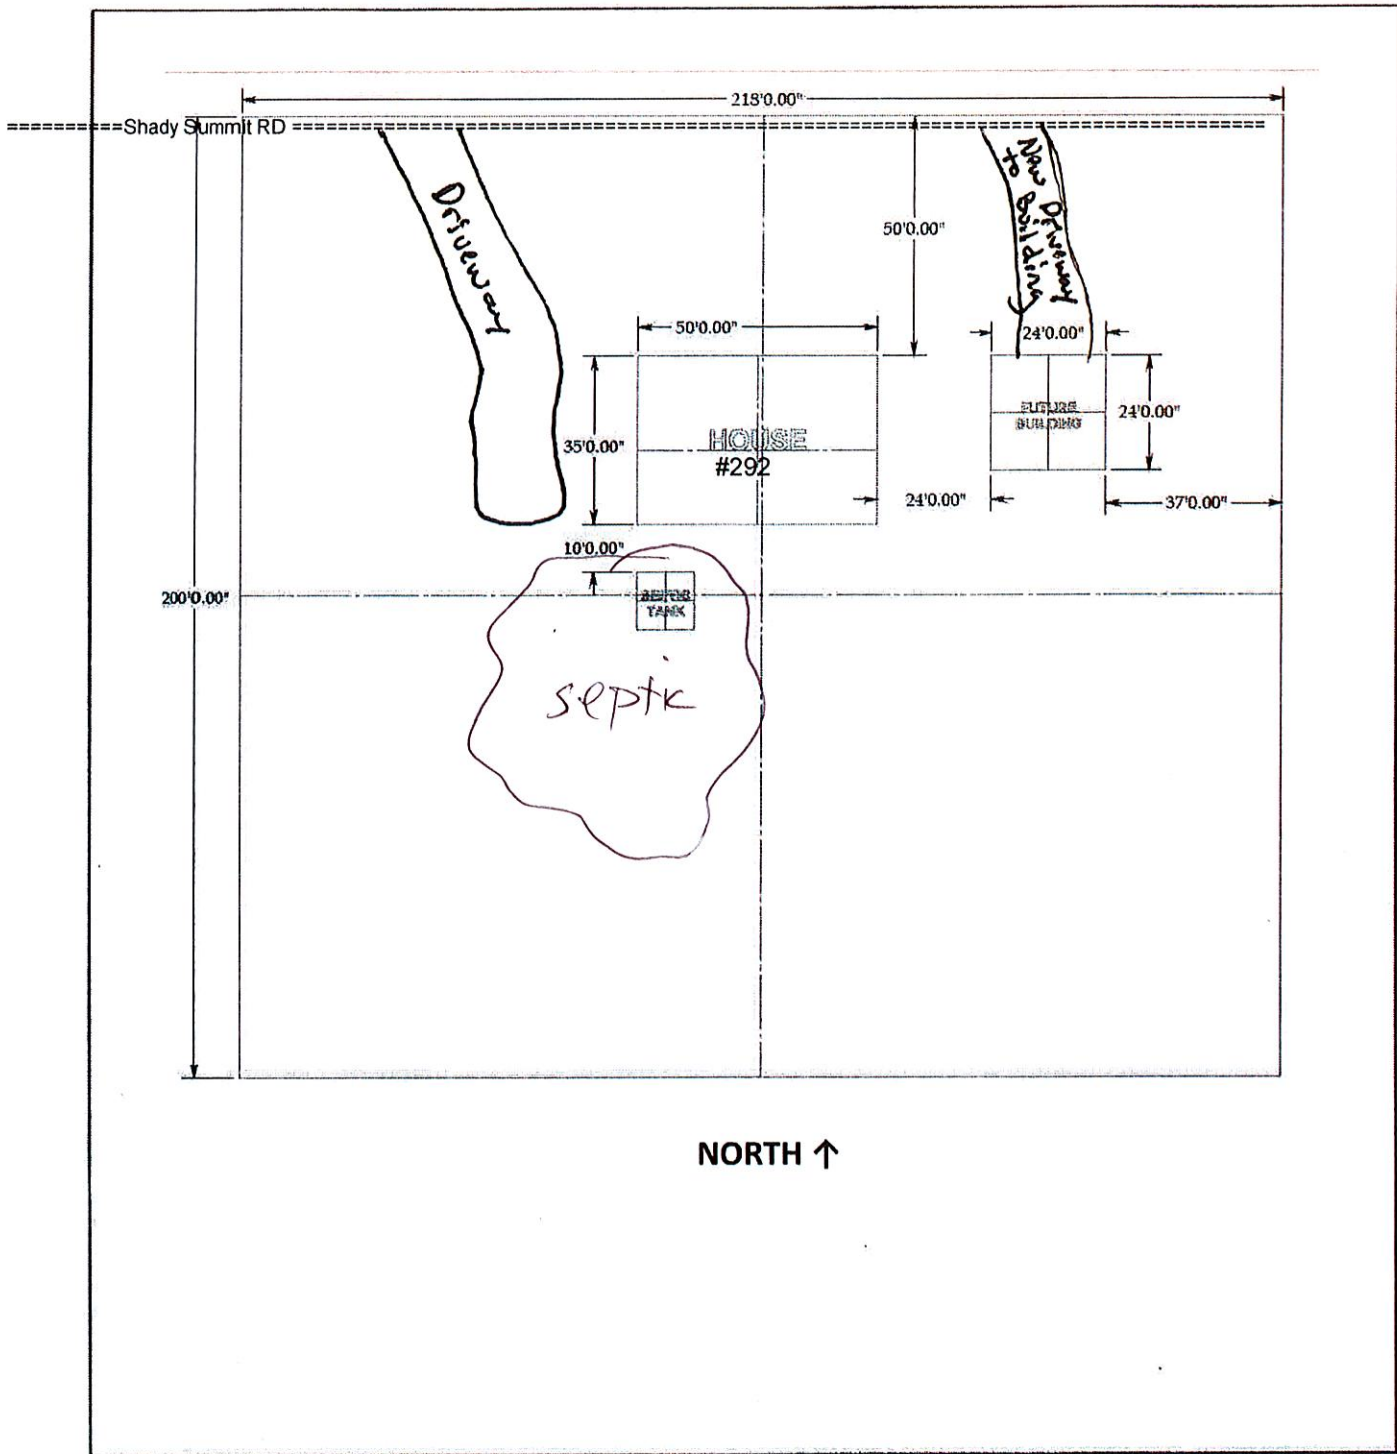

I hereby agree that the information shown is correct to the best of my knowledge. I understand that any changes to the property lines, building orientation, or location of driveways may void this site plan and require a new site evaluation by environmental health or result in a change to the property address.


Signature of Authorized Agent/Owner

6/2/2020
Date