

HENDERSON COUNTY DEPARTMENT OF PUBLIC HEALTH
OPERATIONS PERMIT

2008011379

Permit Number

Owner MARGARET BUKKY Date 4-21-2023
 Property Address 203 MOODY ST
 Septic Tank Installer TONY CONARD Cert # 7239
 Lot No. E Development SPOT FARM
 House Mobile Home
 Other _____
 No. Bedrooms P.E. (3) Design Flow P.E.
 No. Employees - Lot Size 0.3

Associated Permits


WI- CITY H2O
 System Classification IIIg
 System Type Q4 CHAMBERS
 Quantity/Linear Footage 50'x15' BED
 Tank Size P.E.
 Drainfield 750 Sq.Ft.
 Min. System Review Frequency -

Installer's Signature NAES
 Installation: _____ Date: 4-21-23
 Final Issued By: Manli Re

Saprolite yes no

VALID ONLY FOR USE AS DESCRIBED ABOVE
DRAWING NOT TO SCALE

ALT. VALVE
 1: NEW D.F.
 2: OLD D.F.

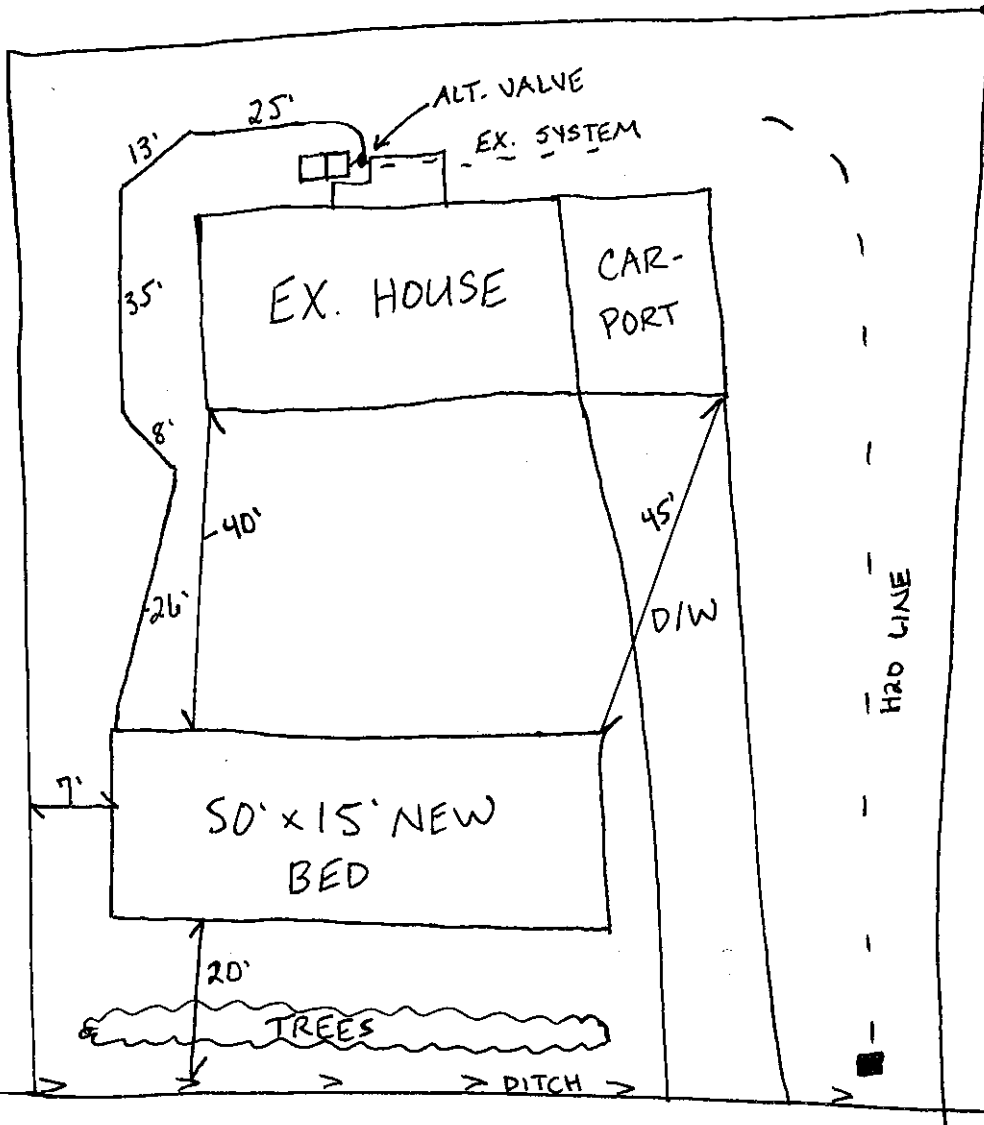

MOODY ST