


SKETCH/AREA TABLE ADDENDUM

File No 220224

SUBJECT

Property Address	85 Waggoners Way		
City	Saluda	County	Polk
		State	NC
Zip	28773		
Borrower			
Lender/Client	Amy Wood	L/C Address	
Appraiser Name			

IMPROVEMENTS SKETCH

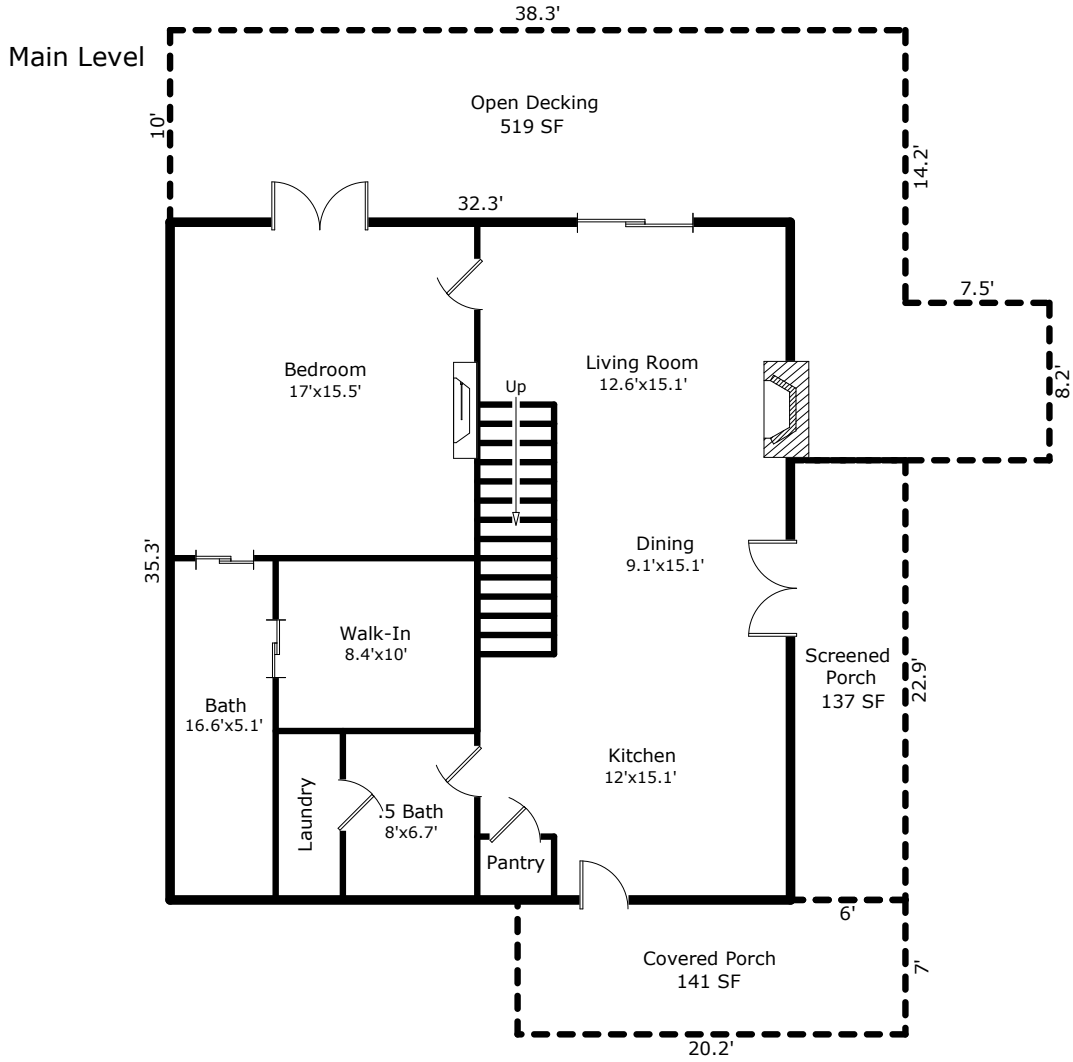

Main Level Finished Living Area = 1,141 SF
 Second Level Finished Living Area = 822 SF
 TOTAL FINISHED LIVING AREA = 1,963 SF

Not Pictured: Outbuilding
 8.2' x 12.3' = 101 SF

SKETCH/AREA TABLE ADDENDUM

File No 220224

SUBJECT

Property Address 85 Waggoners Way

City Saluda

County Polk

State NC


Zip 28773

Borrower

Lender/Client Amy Wood

L/C Address

Appraiser Name

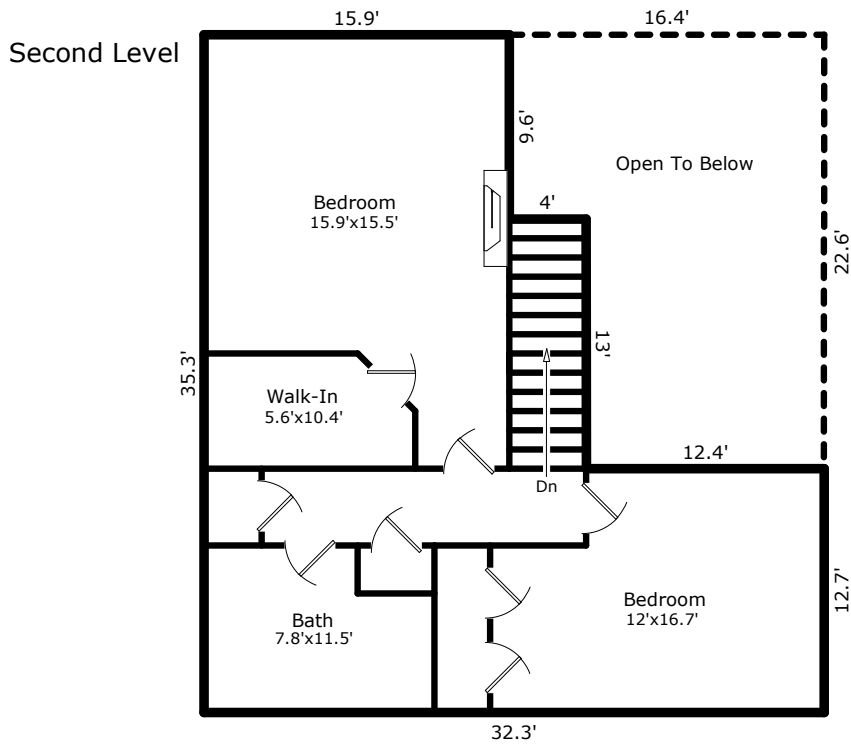

Second Level Finished Living Area = 822 SF

IMPROVEMENTS SKETCH

Scale: 1 = 10