

TRANSYLVANIA COUNTY HEALTH DEPARTMENT

Existing System Inspection Report

(For Building Inspection Department)

Date: 2-16-99

Tax ID No.: 8583-21-2509-000

Receipt No.: 10305
#50

Owner/Agent: WALTERS, MIKE & SHERRY

Address: c/o 1720 Old Haywood Road
Asheville, NC 28806

Phone Number: 828 854-8558 Mountain Horizon, Inc.
Archdeck of Asheville

Date System Installed: house built in 1979

Original Cert. of Completion	
Name:	_____
Date:	_____

Name(s) of Original Permittee: John Craven cheulah

Directions to property: Hwy. 276 - main gate of Connestee Falls - Connestee Trail to Shulah Rd
on left approx 2 miles - 3rd house on right (gray house)

Subdivision: Connestee Falls Section: Unit 1 Lot No.: 14 87

- Inspection requested for:
- Mobile home setup
 - Addition
 - Business
 - Remodeling
 - Connection to unused system
 - Other

No. of bedrooms upon connection/completion: _____ Current no. of Bedrooms: _____

Remarks: building deck and screened porch

Owner/Agent Signature: *Deanna J. Parsons* Date: 2-16-99

At the time of the inspection there was no visible evidence of a malfunction in the system. The system is approved for proposed connections/additions/renovations or other improvements.

Signed: *Alla Smith* Date: 2/23/99

THIS REPORT IS VALID THROUGH 5/23/99

Yellow and Pink flags used to mark the septic system should remain in place and no vehicular traffic allowed over septic field


New Decking must be 5'+ off any part of the septic system

cheulah Rd.

TRANSYLVANIA Co. Health Dept.
 Allan Smith M.S., R.S.
 884-3139

DRAWING NOT TO SCALE


No part of an addition can be within 5' of any part of the septic system.

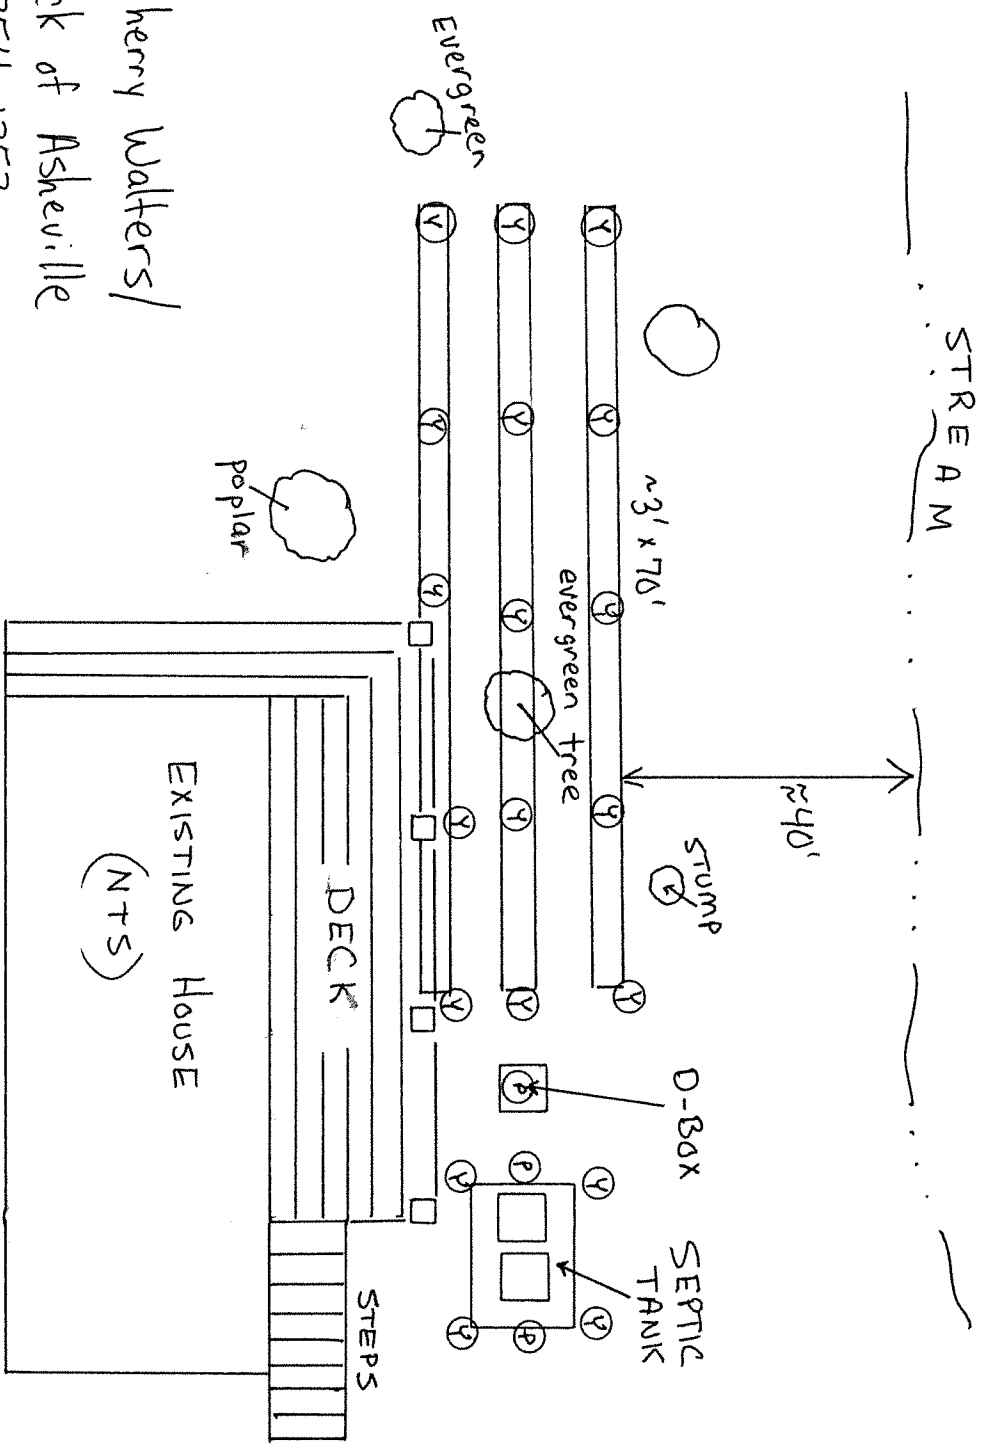

Mike & Sherry Walters/
 Archideck of Asheville

FAX-254-1252

- (3) nitrification lines approximately 3' x 70' marked with Yellow Flags (Y)
- Distribution (D)-box marked with one Pink Flag (P)
- Septic Tank marked with (4) Yellow Flags at corners, (2) Pink Flags in middle ends (P)

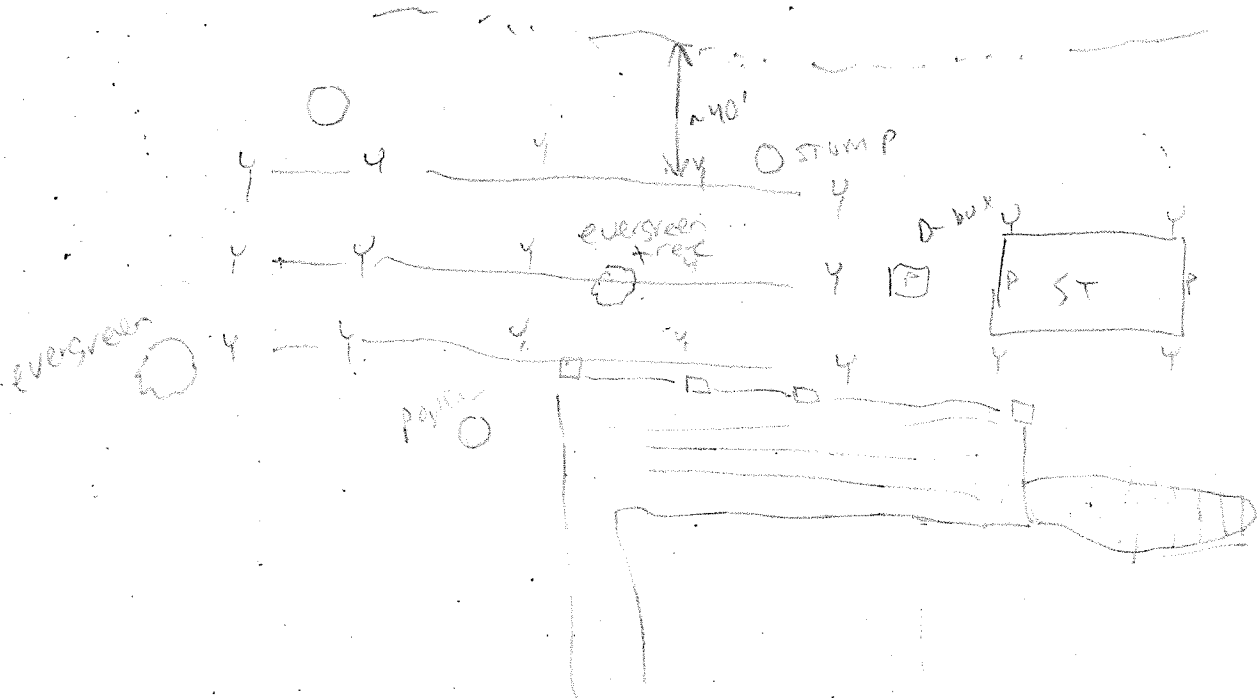


Bawerman - buyer - made copy 9/26/86

TRANSYLVANIA COUNTY HEALTH DEPARTMENT
(Sewage disposal system) Improvements Permit and Certificate of Completion


(Ground Absorption Sewage Disposal System - Section 130 - 160 of Chapter 130 of the General Statutes of North Carolina)

OWNER-OCCUPANT JOHN M. CRAVEN BUILDING CONTRACTOR SELF
 LOCATION CONNESTEE FALLS - CHEVY W - 1113 and CR MAIN 641
 SUBDIVISION CONNESTEE FALLS LOT NO. 87 SECT. OR BLOCK NO. 11
 SEPTIC TANK CONTRACTOR HORRER ADDRESS TRAIL

HOUSE MOBILE HOME BUSINESS
 NO. BEDROOMS 3 NO. BATHROOMS 2
 SIZE OF SEPTIC TANK 860 GALS. (Liquid)
 MATERIAL: PRE-CAST BLOCK FIBERGLASS
 DISTRIBUTION BOX YES NO
 NO. OF LINES 3 WIDTH 3 FT. LENGTH 67 FT.
 PERCOLATION TEST YES NO
 WATER SUPPLY: INDIVIDUAL PUBLIC
 SITE CLASSIFICATION: SUITABLE
 PROV. SUITABLE
 UNSUITABLE

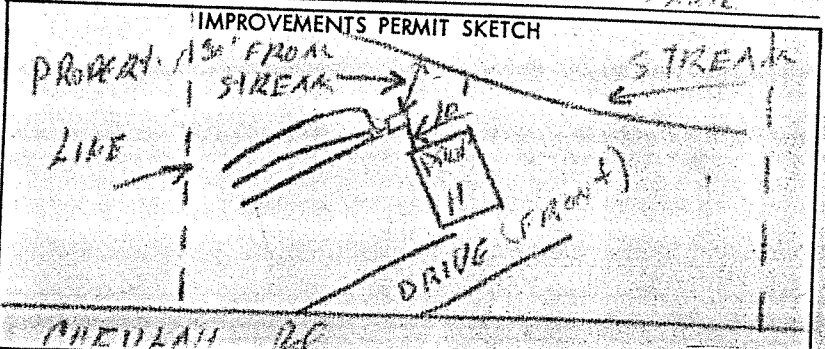

IMPROVEMENTS PERMIT: DATE 5/29/79
 BY W. A. [unclear]
 CERTIFICATE OF COMPLETION: DATE 6/10/79
 BY Ruth Jones

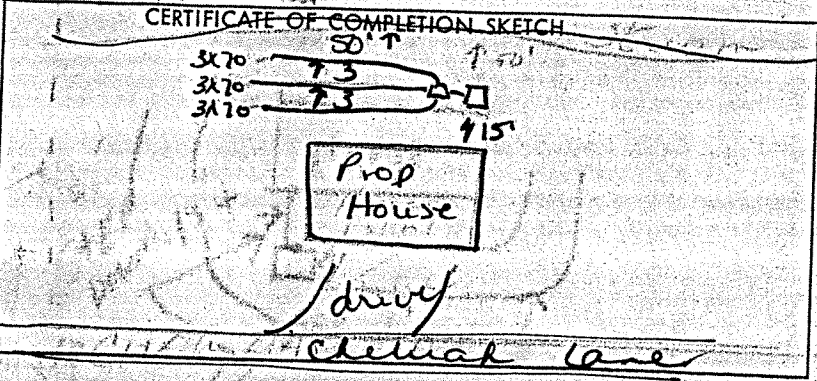

NOTICE: System installed according to Rules and Regulations but not a guarantee that it will function satisfactorily for any given period of time.
 COLOR CODE: White - Owner; Pink - Improvements Permit; Blue - Contractor; Yellow - Inspection Dept.; Green - Health Dept.