

EXISTING SYSTEM INSPECTION REPORT
(For Building Inspection Department)

Date: 6.15.23 PIN: 8573-21-5338-000 Receipt #: 728249 / \$75⁰⁰

Owner: Charlie Galloway Agent/Contractor: Charlie Galloway

Phone: SAME Phone: 828553-2210

Mailing Address: 653 Pole Millee Rd

Date System Installed: _____

Name (s) of Original Permittee: _____

Directions to property: 64 to Islandford turn right Walnut Hollow
go uphill to right on Raxter Rd. - left on Cotton top
go to bottom

Property Address: 260 Cotton top Dr Brevard N.C.

Subdivision: _____ Section/Phase: _____ Lot: _____

Inspection requested for: 2 br. BNH

- Mobile Home Setup
- Addition
- Business
- Remodeling
- Connection to Unused System
- Other

No. of bedrooms upon connection/completion: 2 Current No. of Occupants: _____

Remarks: Had trailer for years on it, just removed trailer and to begin
construction


Owner/Agent Signature: Charlie Galloway Date: 6.15.23

I understand that Transylvania Public Health has the right of entry onto the property to perform requested services.

At the time of the inspection there was no visible evidence of a malfunction in the system. The system is approved for proposed connections/additions/renovations or other improvements.

Signed: Wendy O. Cash REHS Date: 7/12/2023

THIS REPORT IS VALID THROUGH 10/12/2023

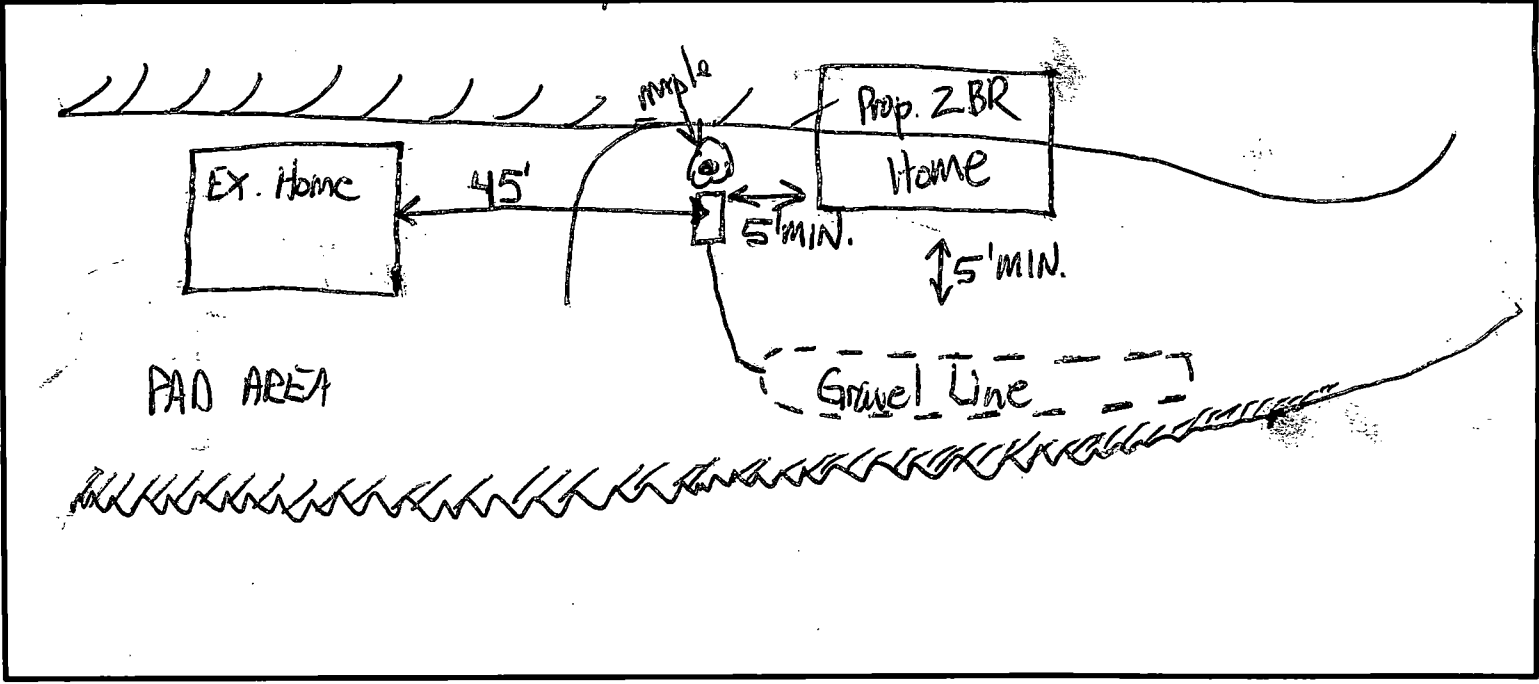

284 Cotton Top Brevard, NC 28712

PIN: 8573-21-5338-000 File Name: Galloway, Charles Permit No.: 22-139

TRANSYLVANIA COUNTY DEPARTMENT OF PUBLIC HEALTH

New Repair **Operation Permit** Addition/Expansion

No. of Bdrms: 2 System Type: III Proprietary Name: 10" id LDP

Charlie Galloway Owner's Name Charles Galloway System Installer and # GC#73852 Certification Number
Neill O. Cagle Authorized State Agent 07/05/2022 Date of Operation Permit Issuance

This system has been installed in compliance with applicable NC General Statutes, Rules for Sewage Treatment and Disposal and all conditions of the Improvement Permit and Construction Authorization

Septic Tank Manufacturer: Infiltrator IM-1060 STB- n/a Date of Manufacture:
Filter Brand: PolyLok PL-68

Conditions/Comments: SEE AS BUILT DIAGRAM


Subsurface system operator required? No Yes If yes, see attached sheet for additional operation conditions, maintenance and reporting.

The septic tank should have all compartments pumped out every 3-5 years, on average, or when the solids are more than 1/3 of the liquid depth in any compartment. Depending upon trench depth, maximum fill over the drainfield cannot exceed two feet. Establish cover over drainfield and divert surface waters to prevent erosion or degradation of the system. No part of the septic system should be subjected to: traffic or any other compaction; vegetation with aggressive and/or hydrophilic (water loving) root systems such as maples or willows; excessive fill or heavy landscaping materials such as rocks/boulders; or any other activities or circumstances that may alter site conditions and may cause problems with the initial system or the repair area as permitted.

TRANSYLVANIA CO. ENVIRONMENTAL HEALTH SEPTIC/WELL PERMIT DIAGRAM

FILE NAME Charlie Galloway PERMIT NO. 22-139 PIN 8578-21-5338-000

SCALE 1" NTS DATE _____

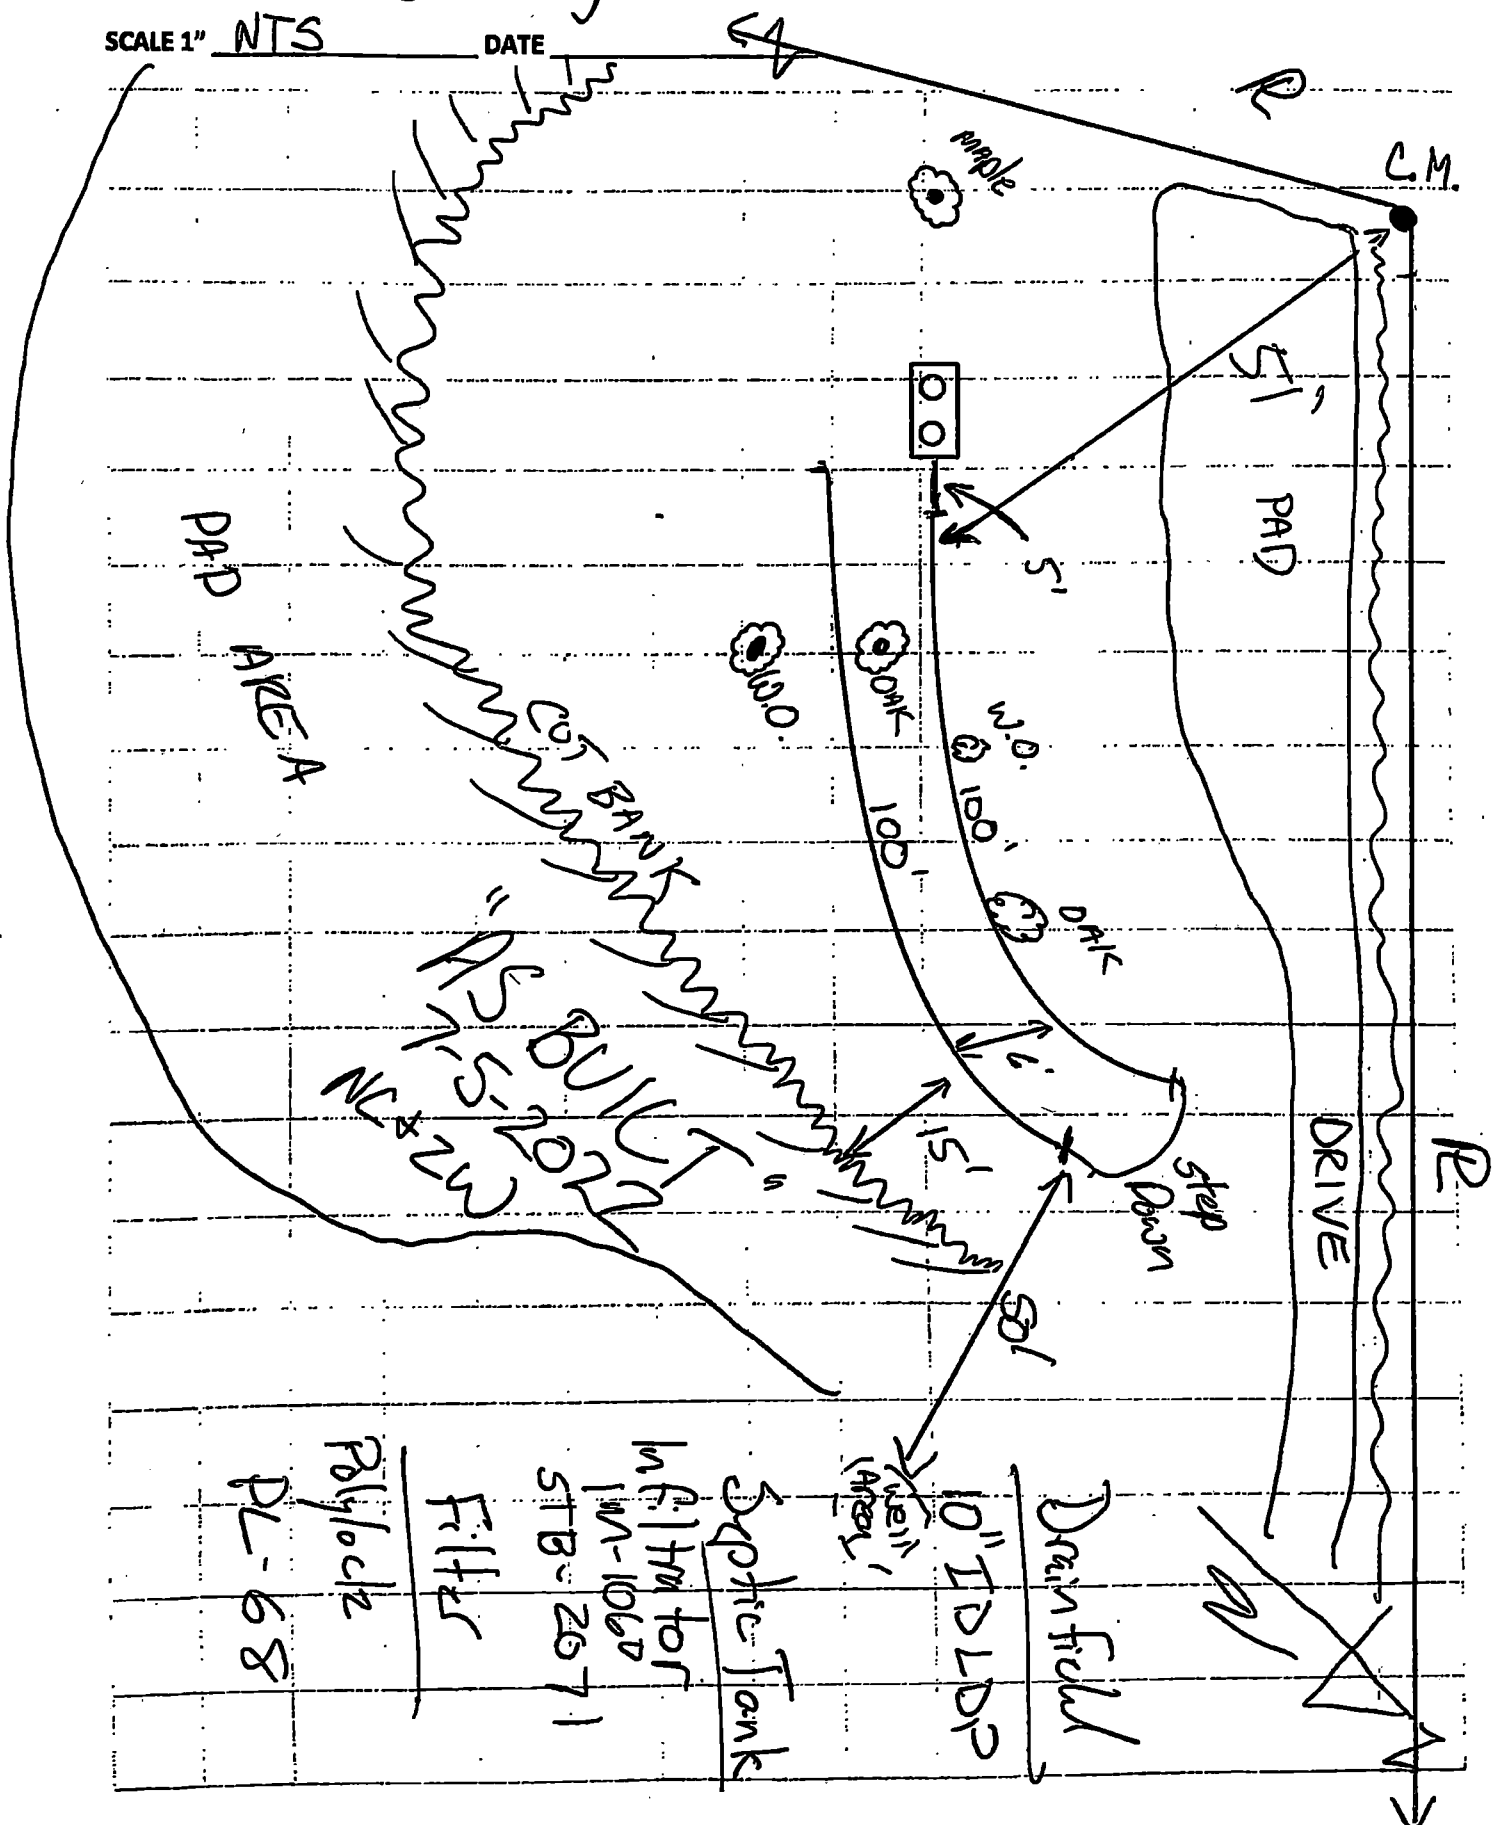

10" ID LDP
Drain Field
Septic Tank
M.F. 17M for
1M-1060
STB-2071
Filters
Polylock
DL-68