

PIN: 8585-96-5148-000 File Name: 216 River Ridge Road Permit No.: 00-135

TRANSYLVANIA COUNTY DEPARTMENT OF PUBLIC HEALTH

Operation Permit

New \_\_\_\_\_ Repair  Addition/Expansion \_\_\_\_\_

No. of Bdrms: 4 System Type: II Proprietary Name: Infiltrator IQ4HC High Cap. Chambers

Stewart, David and Jennifer Ros Kell Bond # 5501
Owner's Name System Installer and Certification Number
James A Bayer, R.E.H.S. 7/31/2019
Authorized State Agent Date of Operation Permit Issuance

This system has been installed in compliance with applicable NC General Statutes, Rules for Sewage Treatment and Disposal and all conditions of the Improvement Permit and Construction Authorization

Septic Tank Manufacturer: Existing STB- Date of Manufacture:
Filter Brand:
See "as built" drawing for system location and measurements.

Conditions/Comments: Clean and replace septic tank effluent filter as required.

Subsurface system operator required? No X Yes If yes, see attached sheet for additional operation conditions, maintenance and reporting.
The septic tank should have all compartments pumped out every 3-5 years, on average, or when the solids are more than 1/3 of the liquid depth in any compartment...

216 River Ridge Rd.

TRANSYLVANIA COUNTY HEALTH DEPARTMENT IMPROVEMENT PERMIT DIAGRAM


00-135

File Name

Stewart, David &  
Jennifer

Permit No.:

Pin No.: 8585965148000

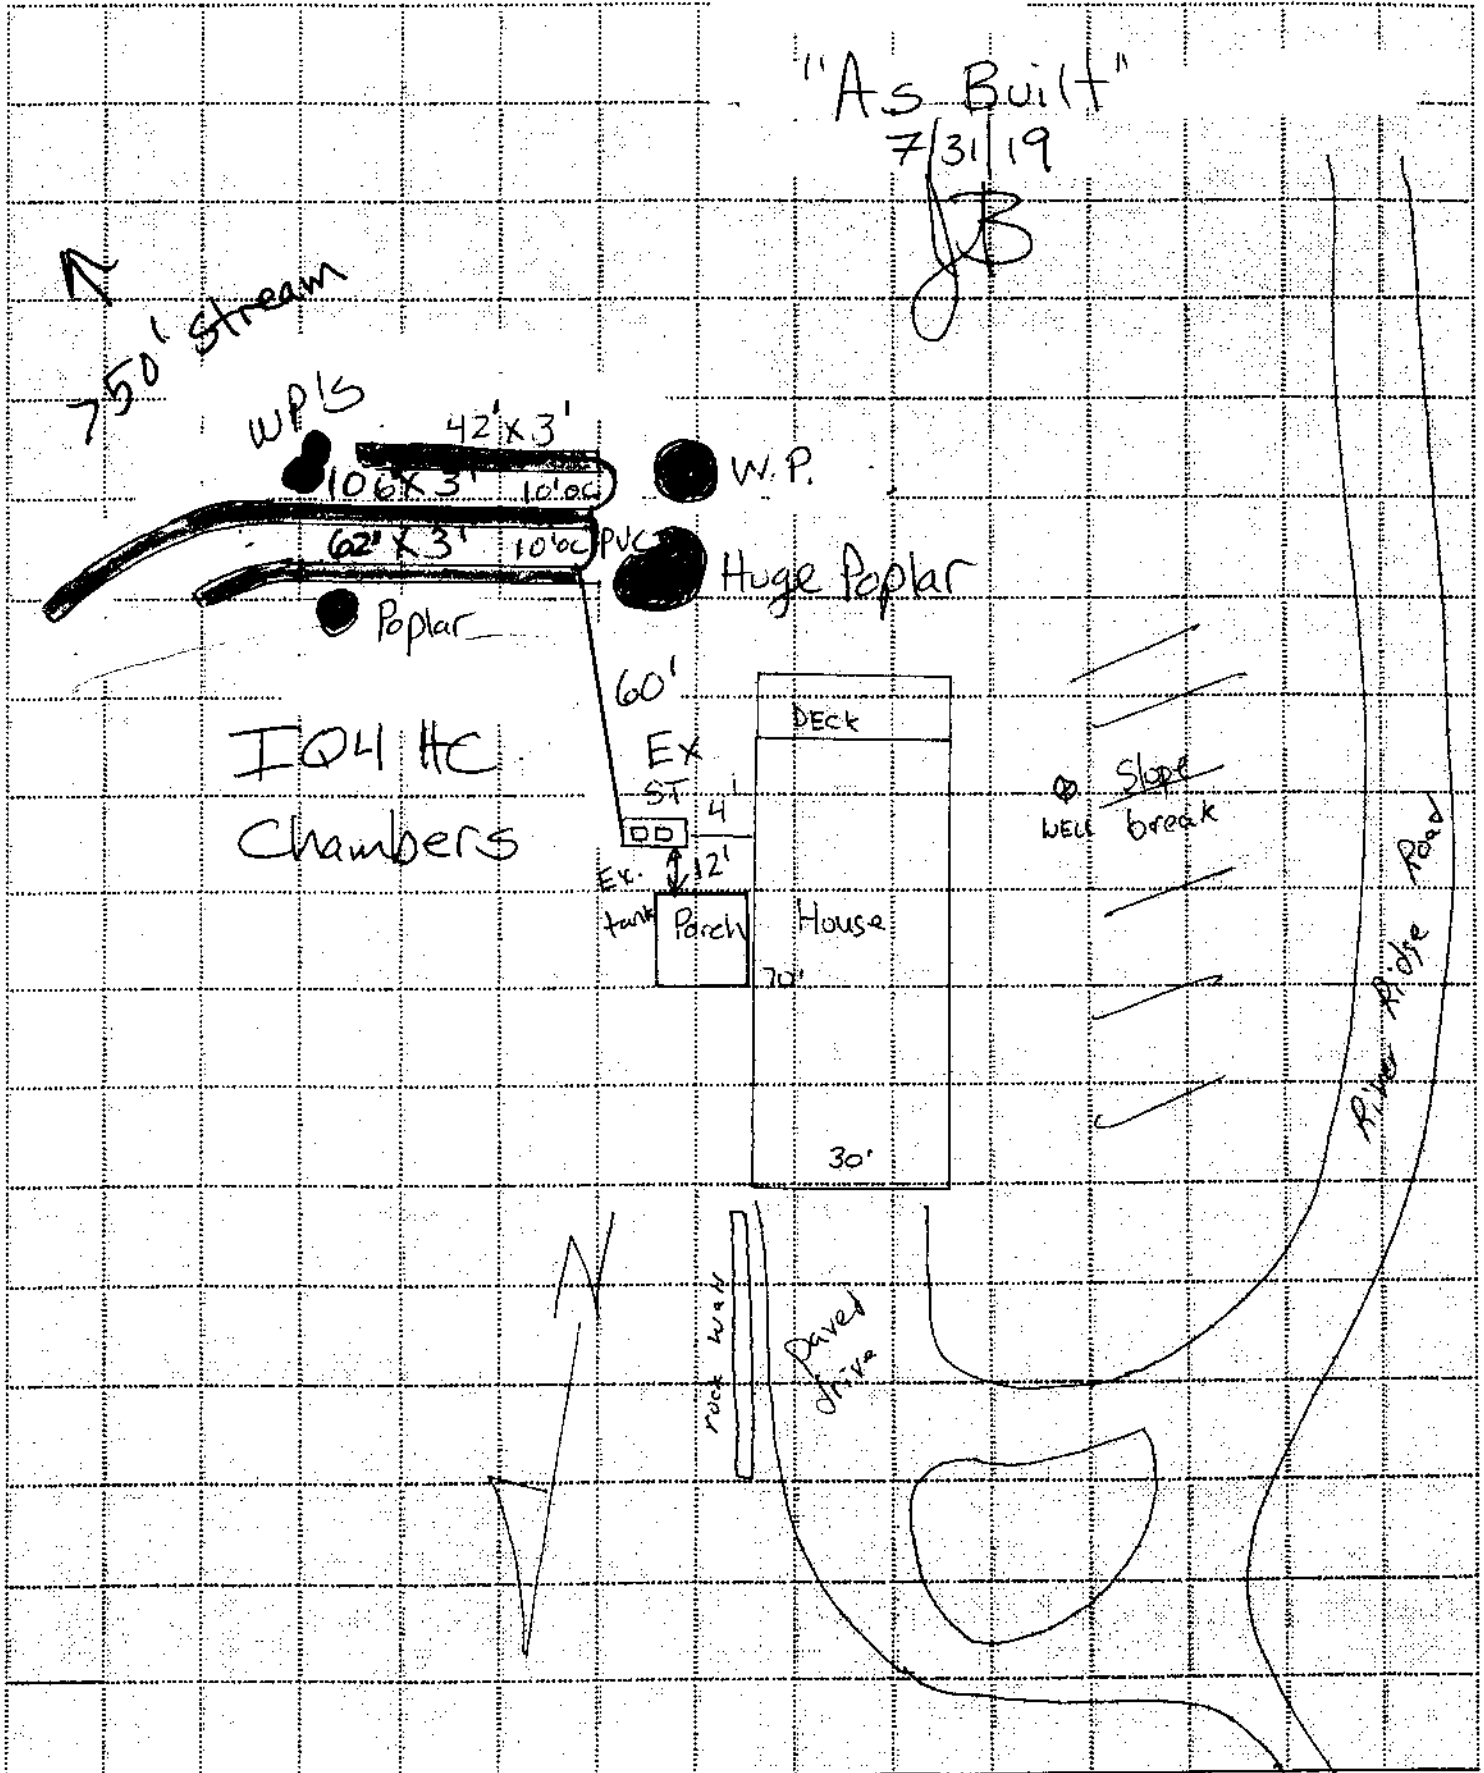

SCALE: 1" = 30ft.