

TRANSLYVANIA COUNTY HEALTH DEPARTMENT

(Sewage Disposal System) Improvements Permit and Certificate of Completion Sewage Treatment and Disposal Rules (ARTICLE 11 OF CHAPTER 130A OF THE GENERAL STATUTES OF NORTH CAROLINA)



APPLICATION FOR AN IMPROVEMENTS PERMIT:

Owner: Dwight Perkins Address: 121 POLE MILL RD
 Location of Property: L. RIVER SEC. - CANTON Mt. T. TSLALA Church
 Plat of Property: YES NO Crab Creek FIRST R - TOWN FIRST
 Type of Facility: House Mobile Home Business LIFE T. TOP - 1st in R
 Estimated Sewage Flow: 360 Gallons per day
 Type of Water Supply: Drilled Well Spring Other
 Signature of Owner or Authorized Agent: Dwight Perkins Date: 4-1-85

IMPROVEMENTS PERMIT AND CERTIFICATE OF COMPLETION

OWNER-OCCUPANT: SALE
 LOCATION: "
 SUBDIVISION: _____
 LOT NO. _____ SECT. OR BLOCK NO. _____
 BUILDING CONTRACTOR: SELF
 ADDRESS: SALE
 SEPTIC TANK CONTRACTOR: JERRY WHITFIELD
 ADDRESS: _____
 HOUSE MOBILE HOME BUSINESS
 NO. BEDROOMS: 3 NO. BATHROOMS: 2
 SIZE OF SEPTIC TANK: 1000 GALS. (Liquid)
 MATERIAL: PRE-CAST BLOCK FIBERGLASS
 DISTRIBUTION BOX YES NO
 NO. OF LINES: 3 WIDTH: 3 FT. LENGTH: 17 FT.
 PERCOLATION TEST YES NO
 WATER SUPPLY: INDIVIDUAL PUBLIC

SITE CLASSIFICATION: SUITABLE
 PROV. SUITABLE
 UNSUITABLE
 IMPROVEMENTS PERMIT: DATE: 4-1-85
 BY: [Signature]
 CERTIFICATE OF COMPLETION: DATE: 4-21-85
 BY: [Signature]

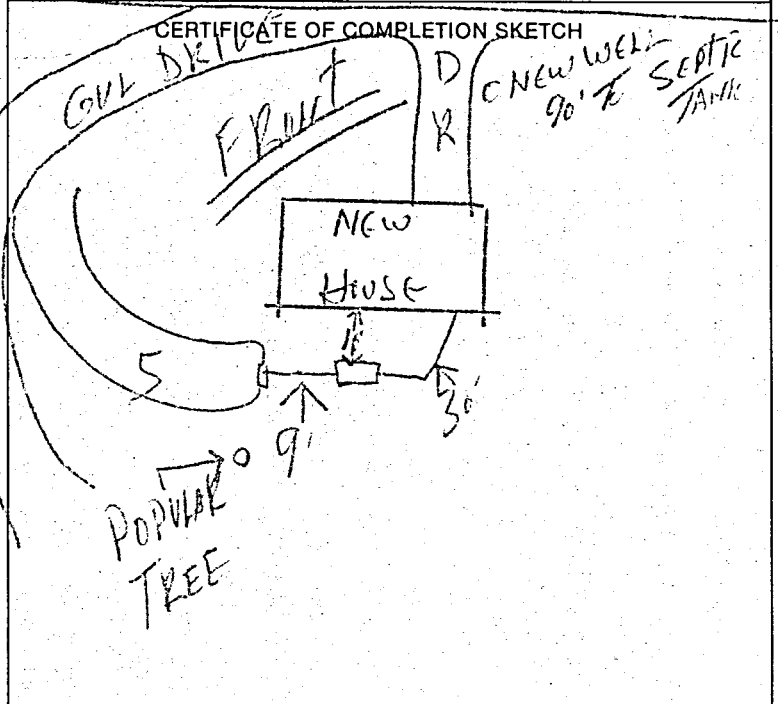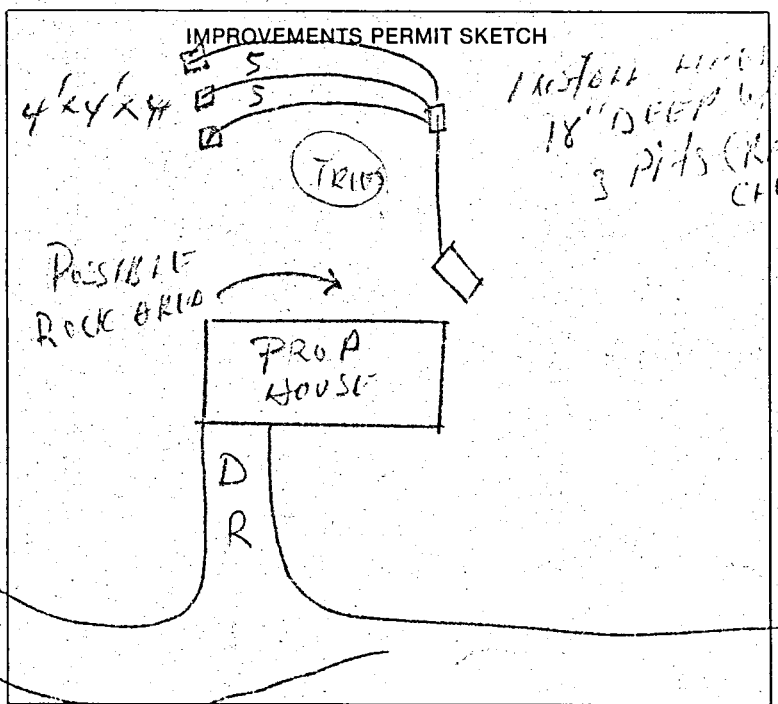

NOTICE: System installed according to Rules and Regulations but not a guarantee that it will function satisfactorily for any given period of time.
 COLOR CODE: White - Owner; Pink - Improvements Permit; Blue - Contractor; Yellow - Inspection Dept.; Green - Health Dept.