

File Name: Indian Camp Mtr.

**TRANSYLVANIA COUNTY HEALTH DEPARTMENT  
ON-SITE WASTEWATER DISPOSAL APPLICATION/PERMIT**

8560-19-9849-000  
Tax ID 8560-19-88  
Receipt No 5640 \$75.00

System Code: 1  
Agent/Owner: BRIEL, ERNEST M.

Mailing Address: 3275 Suntree Boulevard Melbourne, Fl

Home Phone #: ( )

Work Phone #: ( ) Robert Chappell 877-3953

Proposed Buyer:

Mailing Address:

Home Phone #: ( )

Work Phone #: ( )

Property Location: Pickens Hwy. Subdivision: Indian Camp Phase/Sect.: \_\_\_\_\_ Lot #: 4  
Road/Street

Directions to property: Pickens Hwy. Indian Camp on left past Red Lion Inn - turn to right after gate  
1st street to right @ Laurel Ridge - corner lot

Flood Zone	
Is the property in a flood zone?	
<input type="checkbox"/> Yes	<input checked="" type="checkbox"/> No
<input type="checkbox"/> Unknown	
Inspections	
Flood Zone	
<input type="checkbox"/> Yes	<input type="checkbox"/> No
<input type="checkbox"/> Approved	<input type="checkbox"/> Disapproved
Initials _____	Date _____

Installation for: Mobile Home  Single  Double  House  No. Bedrooms: 3 Basement: Yes  No  With Plumbing: Yes  No  Ind./Commercial  Other

If Indust./Commercial/Other: Number of employees: \_\_\_\_\_ Operation: (Describe) \_\_\_\_\_

Lot size: 5 or 6 ac Date lot recorded: 10/95 Right of ways, easements, etc. no Water Supply: Private:  Spring  Well  Shared Supply  Public/Community

I certify the above to be correct to the best of my knowledge. Permission is hereby granted to perform a soil evaluation on the property described above. If the information submitted in this application is falsified or changed, the permit shall become void.

Applicant/Agent Signature: Robert B Chappell Date: 4-19-96

Construction Authorization Issue Date: 4.23.96 Construction Authorization Renewed Date: \_\_\_\_\_

**IMPROVEMENTS PERMIT  
(Diagram and Conditions Attached)**

New Installation:  Repair/Addition:  Original Permittee: \_\_\_\_\_ Dated: \_\_\_\_\_

Design waste flow: 360 GPD LTAR: .5 Septic Tank Capacity: 1000 gal./min. Pump Tank Capacity: - gal./min. Proposed Wastewater System: conventional

Drainfield: Total Trench Length: 240' Square Footage: 720' (Equivalency? ) Individual Trench Length: 80' Maximum Trench Depth (Low Side): 12" Trench Width: 36"

Distribution Method: D-box System distance to nearest well: 50'+ Water line: 10' Foundation: 5' Property line: 10' Vertical Cut: -

Comments & Special Conditions: Keep trenches ultra-shallow at depth shown below  
Bring in 6" of soil cover to backfill over drainfield

This improvements permit is issued by the Transylvania County Health Department and is issued without expiration. This permit must be accompanied by an "Authorization for Wastewater System Construction" prior to the installation or repair of the wastewater system or before any required building permits can be issued. Any alterations or modifications (man made or natural) to the site, system design, or conditions in which the permit was issued will cause the permit to be void.

I agree to install the wastewater disposal system in accordance with the improvement permit and any conditions specified therein.

Signed: Margaret Chappell Date: 4-29-96 Final Inspection by: Jeff McCall, RS Date: 5.6.96  
Permit Prepared by: Jeff McCall, RS Date: 4.23.96 Installed by: Terry Whitmire Date: 5.6.96

**PERMIT AND CONSTRUCTION AUTHORIZATION MUST BE ON SITE DURING ALL PHASES OF CONSTRUCTION/INSTALLATION AND INSPECTION**

TRANSYLVANIA COUNTY HEALTH DEPARTMENT IMPROVEMENT PERMIT DIAGRAM

Date: 4.23.96

Tax ID No: 85601998490001

Owner/ Agent: Ernest Briel

Receipt No: 5640

Address: See Permit


Phone No: 877-3953  
Robert Chappell

Location of Property: See Permit

Subdivision: Indian Camp Mtn. Lot No: 4 Section: - Plat of Property: ✓

All parts of the septic tank system shall be located at least 100', or the maximum feasible distance from any well, but in no case less than 50 feet.

Comments! \* Keep trenches ultra-shallow  
\* Bring in 6" of soil cover to backfill over system.

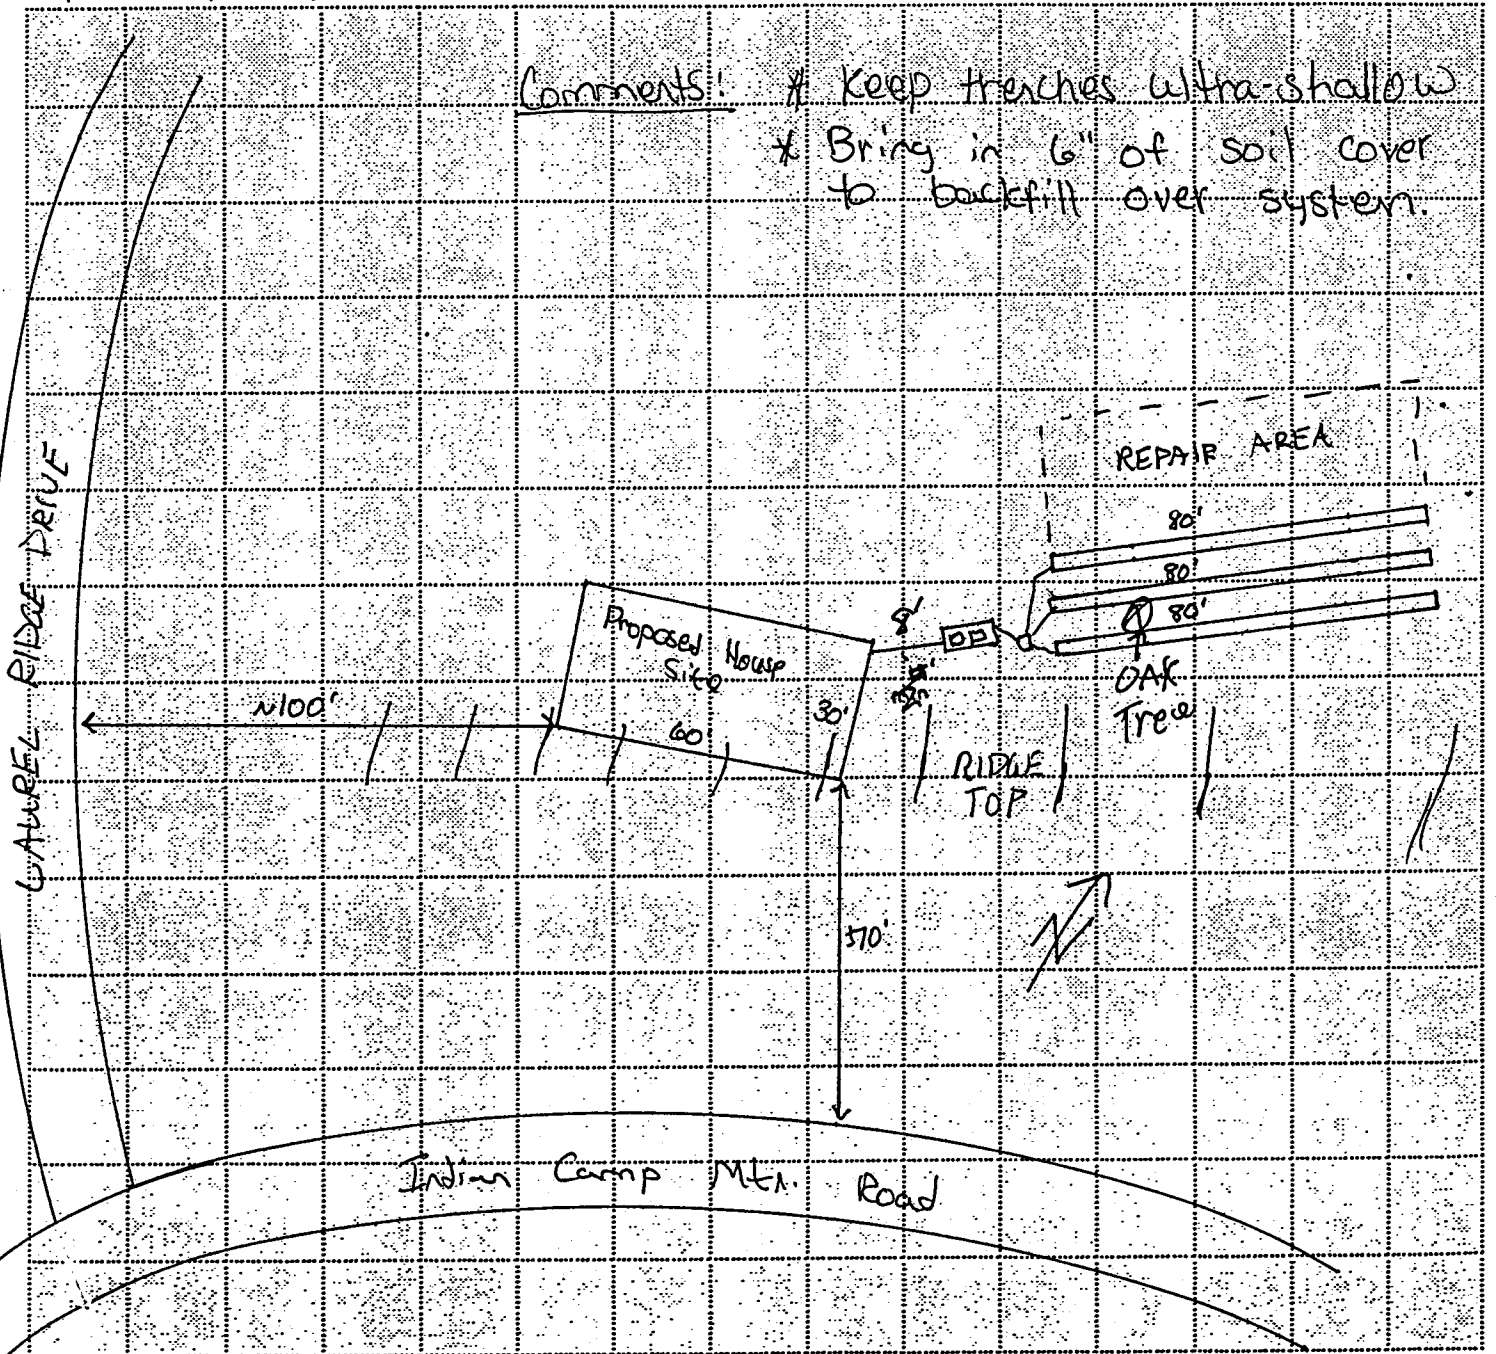

Minimum distance between trenches shall be 9 feet, on center.

Scale 1" : 40 feet

Keep trenches level, on contour, and shallow (maximum depth 12 " on the low side of trench). Trench width is 36 inches.