

Septic 17-230 1-22-17



Public Health
Prevent. Promote. Protect.

Transylvania County
Department of Public Health

**TRANSYLVANIA COUNTY DEPARTMENT OF PUBLIC HEALTH
WELL PERMIT OR WELL REPAIR PERMIT
CERTIFICATE OF COMPLETION**

New Well Repair To Existing Well

WP17-115 8592-20-8681-000 HANCOCK, DAVID
Permit No. Parcel I.D. Issued To
810 Green Hollow Ln

Well Grouting Inspection

Casing Type PVC Casing Thickness/Weight SDR21 Casing Depth 120'
Diameter 6 1/4" Grout Type Concrete Grout Depth 20'
Grout Method POUR

Inspected By: James A Bayer, REHS Date: 4/25/18

Well Head Inspection

Inches Above Grade 12" Air Vent Threadless Sample Tap ONLY
Sanitary Seal (if hose bib) Anti-Siphon Present N/A Well Plate
Pump Plate _____ Well Depth 185' Static Water Level 30' Yield 75 GPM

Contractor Glenn Sentelle / Dustin Merrill
Certification # 2011 / 3004 7 Grundfos
Date 8/15/18 Depth 100'
Horsepower 1/2 HP

Inspected By: James A Bayer, REHS Date: 2/19/19


Well Report Received (GW-1a)

Well Contractor Merrill Well & Pump Glenn Sentelle
Certification # 2011

Issued By James A Bayer, REHS Date 2/19/19

WELL
 TRANSYLVANIA COUNTY DEPARTMENT OF PUBLIC HEALTH IMPROVEMENT PERMIT DIAGRAM

File Name: HANCOCK, DAVID Permit No.: WP17-115 PIN: 8592-20-2681-000
GREEN HOLLOW LANE
BIG HILL, LOT 133

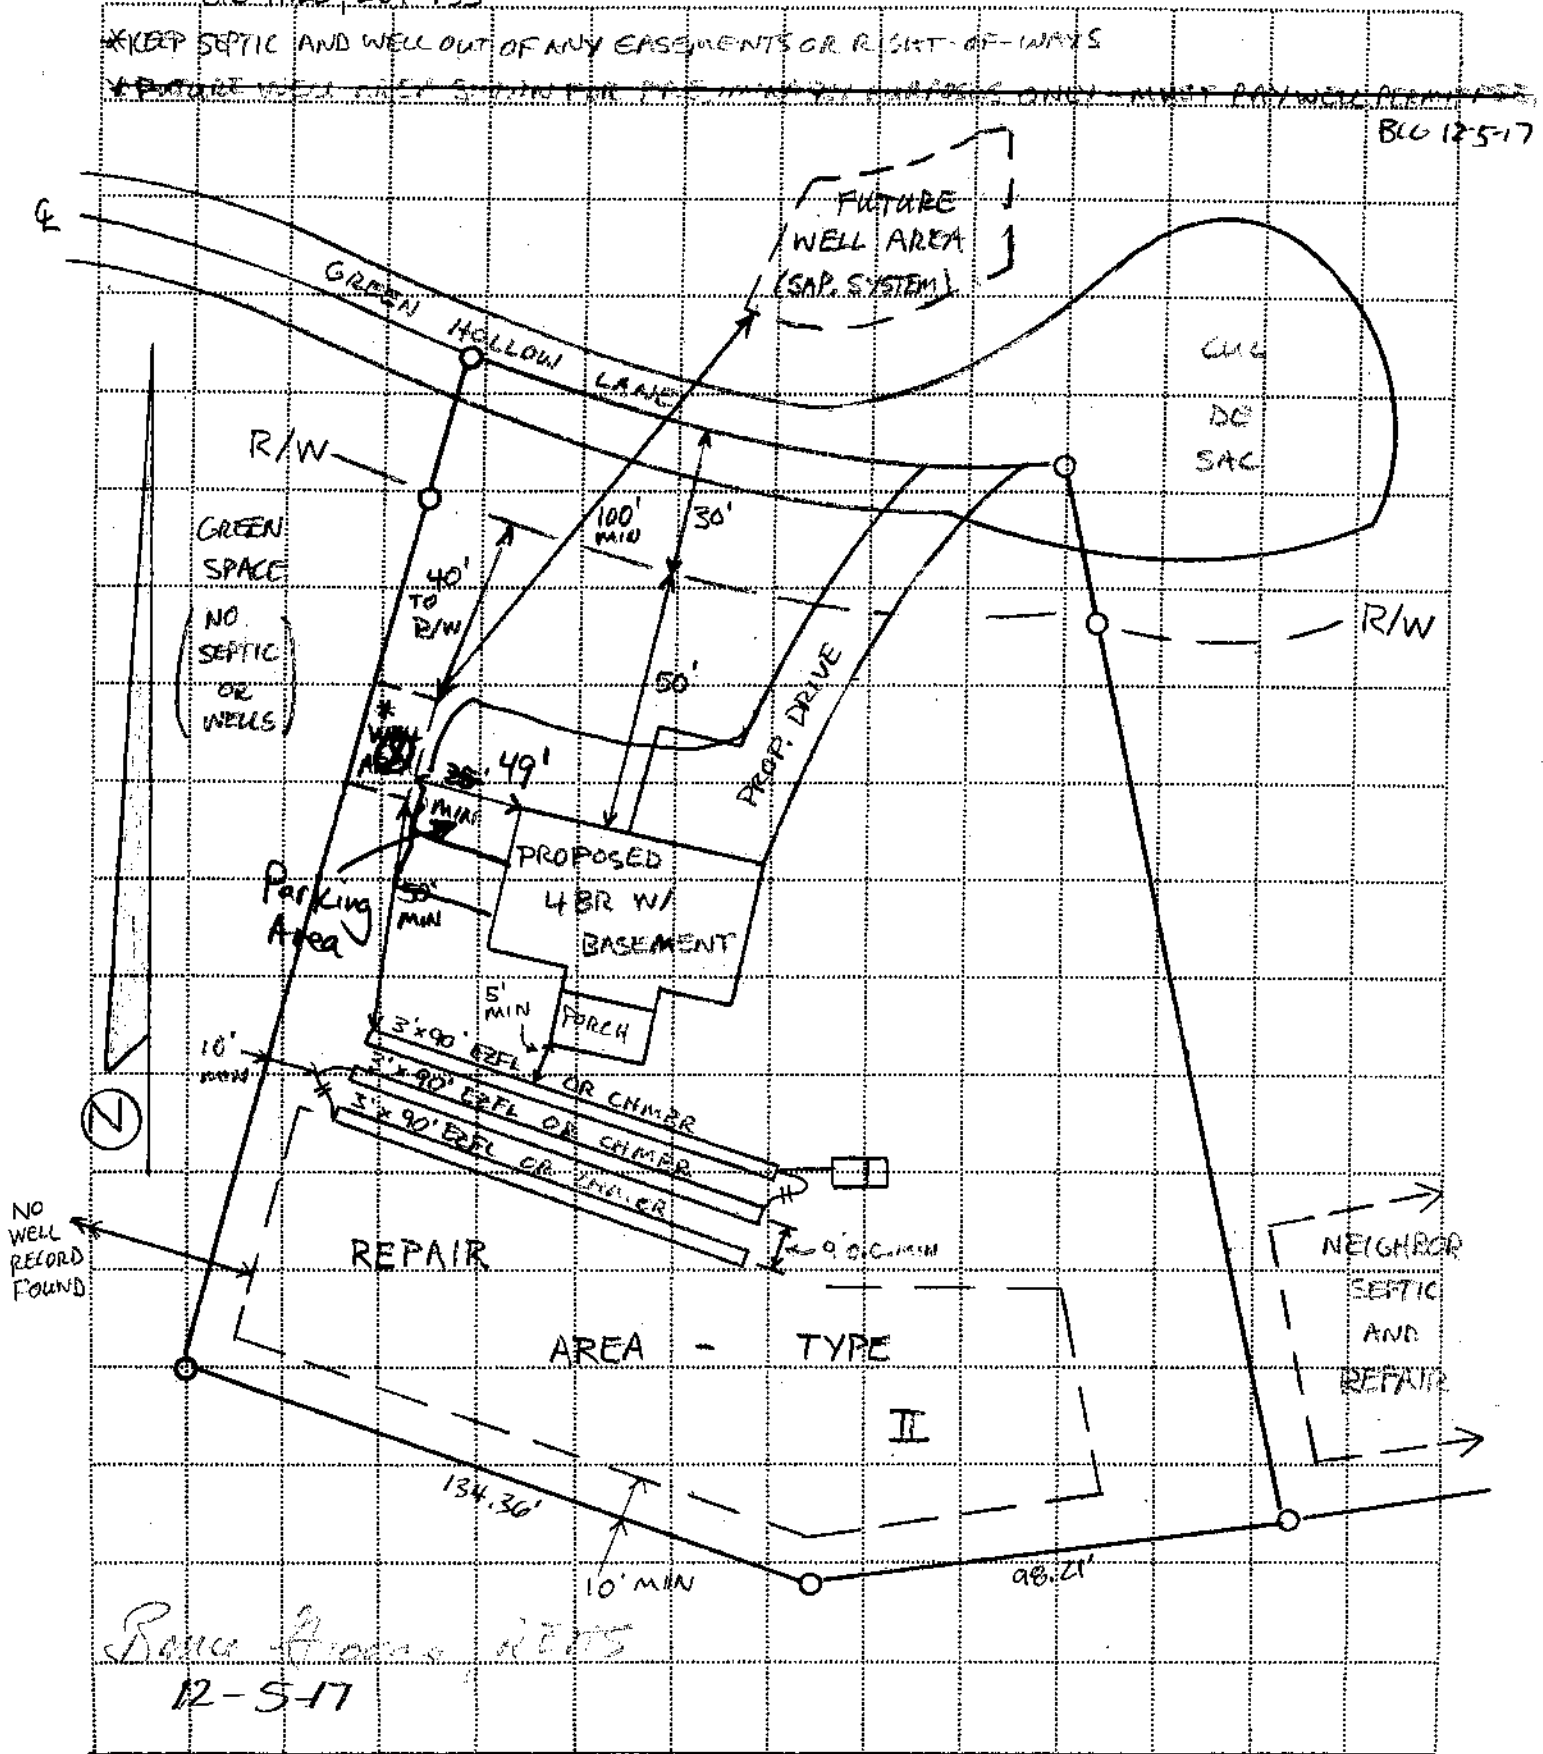

SCALE: 1" = 40' APPROX