

HENDERSON COUNTY HEALTH DEPARTMENT

Completion Permit

New Construction   
Repair   
Pre-Existing Tank

Permit Number

C No. 7107  
I No. 8868

Owner William Greene Date 6-26-88  
Building Contractor SAME  
Septic Tank Installer Merrill Grading  
Location DAVIS Mtn Rd  
Lot No. 2 Development \_\_\_\_\_

House  Mobile Home  Other   
No. Bedrooms 3 Garbage Disposal Yes  No   
Basement Plumbing Yes  No   
Water Supply — Community  Individual  well  
Lot Size 20,000 ft<sup>2</sup>+  
Site Evaluation — Suitable  Provisional   
Tank Size 1000 Drain Field 720 Sq. Ft. 3 trenches  
Stone Depth 12 Inches 3' x 8'

Valid only for use as described above

Zoning regulations may be in effect in your area, before proceeding with construction, check with the Henderson County Zoning Officer or Inspection Department.


Received by

William Greene

Approved for Material  
& Workmanship Only

Issued by

John Probst  
Sanitarian

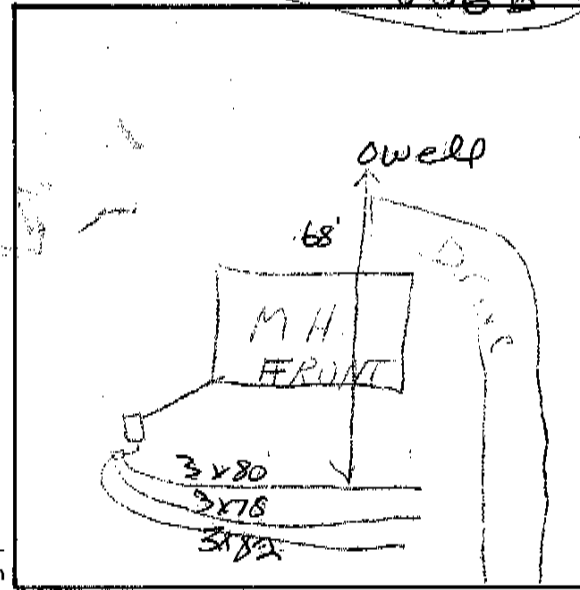

**HENDERSON COUNTY HEALTH DEPARTMENT**  
**SEPTIC TANK SYSTEM IMPROVEMENTS PERMIT**

Call 692-4223 between 9-12 and 1-4:30 p.m.

Owner William Givens Date 4-12-85

Building Contractor SAME

Location DAVIS MA. RD. 200ft. 00 RT

Lot # (1) Development

House  Mobile Home  Other

No. Bedrooms 2

Basement Plumbing Yes  No

Water Supply - Community  Individual

Lot Size 15,200 sq. ft.

Site Evaluation - Suitable  Provisional  Unsuitable

Tank Size 750 Drain Field 780 Sq. Ft.

Stone Depth 12 inches

Valid only for use as prescribed above

Notify department in advance for any changes needed.

Zoning regulations may be in effect in your area, before proceeding with construction, check with the Henderson County Zoning Department or Inspection Department

Permit valid for 3 years from date of issuance.

William Greene


Approved for Material & Workmanship Only

Approved   
 Disapproved   
 New Construction   
 Repairs   
 Pre-Existing Tank

I N<sup>o</sup> 8868

For Conventional System

Max. Trench Bottom Depth 2ft. App. 0.5

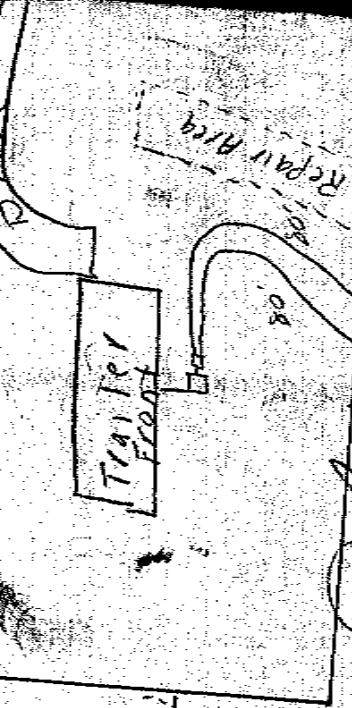

Issued by [Signature] Sanitarian