

File Name: Big Hill

**TRANSYLVANIA COUNTY HEALTH DEPARTMENT
ON-SITE WASTEWATER DISPOSAL APPLICATION**

Pin #/Tax ID 8581-88-4031-000

3066\$150

Permit #: 03-063

Receipt No _____

Agent/Owner: RobianHodd Inc.

Mailing Address: _____

Home Phone #: () _____

Work Phone #: () _____

Proposed Buyer: Pastorino, Robert

Mailing Address: 15050 W. Clover Ln., Libertyville, IL 60088

847 362-2403

c/o Pat Brennan 88442934

Home Phone #: () _____

Work Phone #: () _____

Property Location: Shady Lane
Road/Street

Subdivision: Big Hill Phase/Sec.: _____ Lot #: 62

Directions to property: Buy .276 to East Fork Rd. to left on Big Hill - right on Sandy Lane -- drive on left

Flood Zone		
Is the property in a flood zone?		
<input type="checkbox"/> Yes	<input type="checkbox"/> No	<input type="checkbox"/> Unknown
Inspections		
Flood Zone		
<input type="checkbox"/> Yes	<input type="checkbox"/> No	
<input type="checkbox"/> Approved	<input type="checkbox"/> Disapproved	
Initials _____	Date _____	

Installation for: Mobile Home Single Double House No. Bedrooms: 4 ^{NB} Basement: Yes No With Plumbing: Yes No Ind./Commercial Other

If Indust./Commercial/Other: Number of employees: _____ Operation: (Describe) _____ Property contains designated wet lands: Yes No

Lot size: 4.33 Date lot recorded: not recorded Right of ways, easements, etc. no Water Supply: Private: Spring Well Shared Supply Public/Community

I certify the above to be correct to the best of my knowledge. Permission is hereby granted to perform a site/soil evaluation on the property described above. If the information submitted in this application is falsified or changed, the permit shall become void. I understand that it is my responsibility as the applicant/agent/owner to comply with all applicable ordinances, laws, and rules from other agencies that may affect the development of this property.

Applicant/Agent Signature: _____ Date: 1-24-03


**ON-SITE WASTEWATER DISPOSAL SYSTEM
OPERATIONS PERMIT**

The issuance of this operations permit certifies that the system described on the improvement permit and the construction authorization is properly installed or repaired and that the system is capable of being operated in accordance with the conditions of the improvement permit, Article 11 of Chapter 130A of the General Statutes of North Carolina and the rules adopted pursuant to this Article. This operation permit shall remain in effect as long as the system is operated and maintained as required by the Laws and Rules for Sewage Treatment and Disposal Systems as issued by the North Carolina Department of Environment and Natural Resources, Division of Environmental Health.

System Classification Type: IIIg Management Entity: Owner Certified Operator Minimum inspection/maintenance review frequency N/A years.

Comments: Clean / replace septic tank effluent filter as needed

Installed by: Ronnie McGuire Final Inspection by: James A Boyer, RS Date: 1/15/04

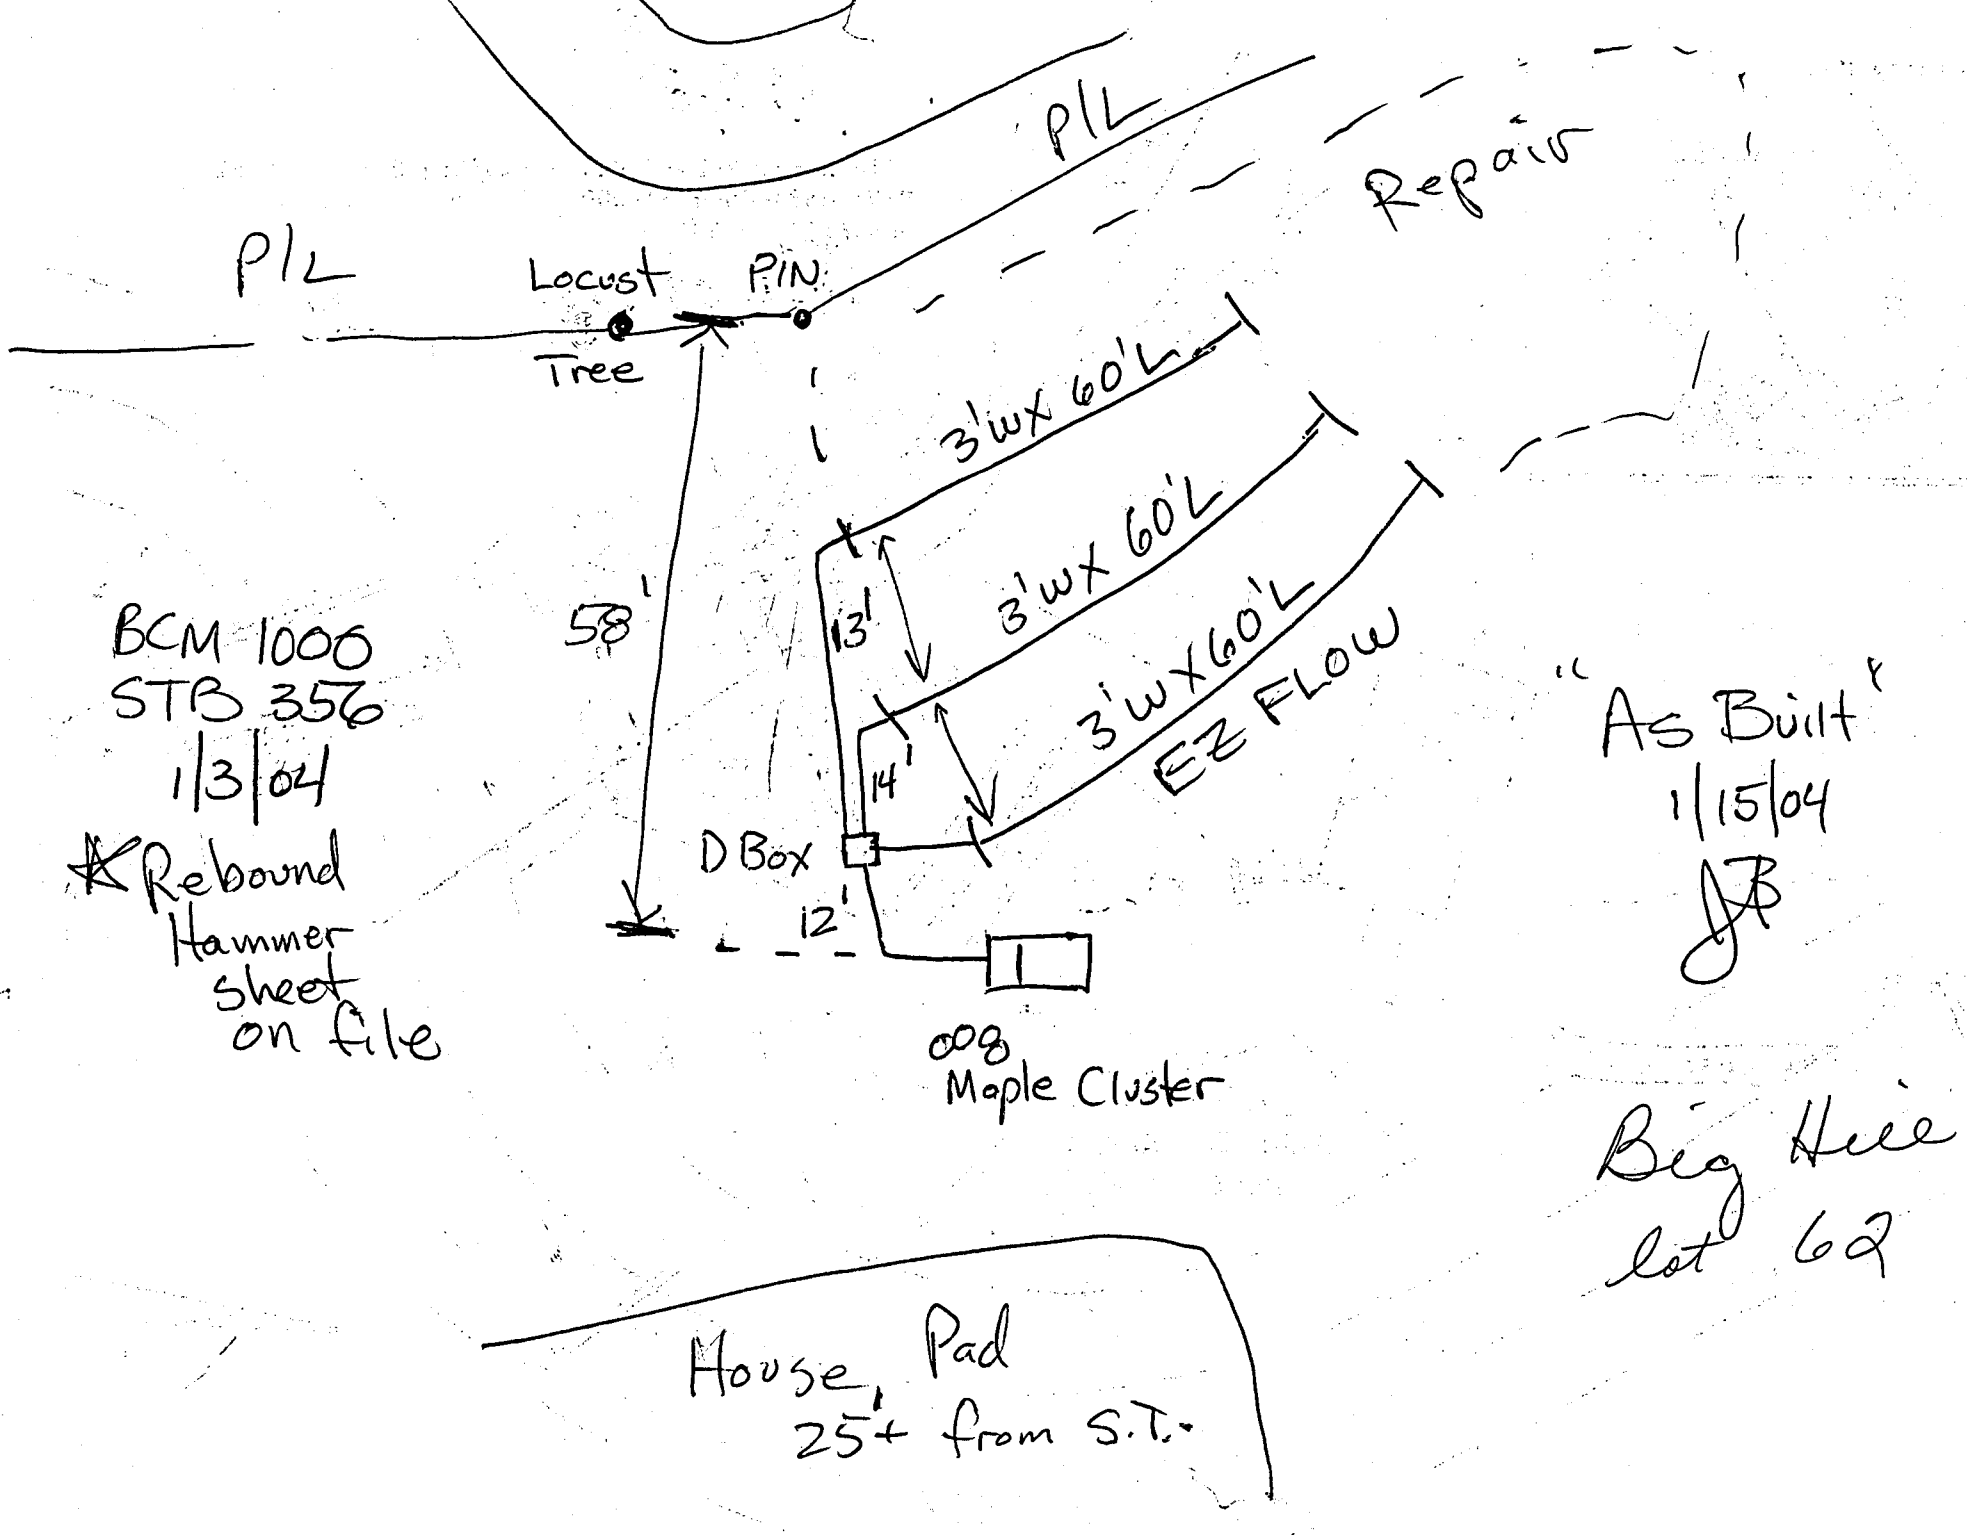

BCM 1000
STB 3576

1/3/04

* Rebound
Hammer
sheet
on file

Repair

"As Built"
1/15/04
JB

Big Hill
lot 62

House Pad
25'+ from S.T.

EZ FLOW

008
Maple Cluster

DB Box

Locust Tree
PIN

P/L

P/L

File Name: Big Hill

**TRANSYLVANIA COUNTY HEALTH DEPARTMENT
ON-SITE WASTEWATER DISPOSAL APPLICATION**

Pin #/Tax ID 8581-88-4031-000
3066\$150

Permit #: 03-063

Receipt No _____

Agent/Owner: RobinHodd Inc.

Mailing Address: _____

Home Phone #: () _____

Work Phone #: () _____

Proposed Buyer: Pastorino, Robert

Mailing Address: 15050 W. Clover Ln., Libertyville, IL 60048

Home Phone #: 847 362-2403

c/o Pat Brennan 88442934
Work Phone #: () _____

Property Location: Shady Lane
Road/Street

Subdivision: Big Hill Phase/Sec.: _____ Lot #: 62

Directions to property: Hwy.276 to East Fork Rd. left on Big Hill - right on Sandy Lane -- drive on left

Flood Zone		
Is the property in a flood zone?		
<input type="checkbox"/> Yes	<input type="checkbox"/> No	<input type="checkbox"/> Unknown
Inspections		
Flood Zone		
<input type="checkbox"/> Yes	<input type="checkbox"/> No	
<input type="checkbox"/> Approved	<input type="checkbox"/> Disapproved	
Initials _____	Date _____	

Installation for: Mobile Home Single Double House No. Bedrooms: 4 Basement: Yes No With Plumbing: Yes No Ind./Commercial Other

If Indust./Commercial/Other: Number of employees: _____ Operation: (Describe) _____ Property contains designated wet lands: Yes No

Lot size: 4.33 Date lot recorded: not recorded Right of ways, easements, etc. no Water Supply: Private: Spring Well Shared Supply Public/Community

I certify the above to be correct to the best of my knowledge. Permission is hereby granted to perform a site/soil evaluation on the property described above. If the information submitted in this application is falsified or changed, the permit shall become void. I understand that it is my responsibility as the applicant/agent/owner to comply with all applicable ordinances, laws, and rules from other agencies that may affect the development of this property.

Applicant/Agent Signature: [Signature] Date: 1-24-03

**AUTHORIZATION FOR WASTEWATER SYSTEM CONSTRUCTION
(Diagram and Conditions Attached)**

New Installation: Repair/Addition: Original Permittee: _____ Dated: _____

Design waste flow: 360 GPD LTAR: 5 Septic Tank Capacity: 1000 gal./min. Pump Tank Capacity: _____ gal./min. Proposed Wastewater System: _____

Drainfield: Total Trench Length: 180 ft. Square Footage: 720 Trench spacing: 9 ft. on ctr. Individual Trench Length: 60 ft. Maximum Trench Depth(Low Side): 18 in. Trench Width: 36 in.

Distribution Method: D-box or serial Min. distance between system and nearest: Well: 100 ft. Water line: 10 ft. Foundation: 15 ft. Property line: 10 ft. Vertical Cut: 15 ft.

Comments & Special Conditions: trench length may be changed as needed w/ no trench less than 40' or longer than 80' keeping off the "nose slope"; try to install as shown on permit; serial feed if trench lengths

Construction of the wastewater system for the permit indicated is hereby authorized. The wastewater system described in the Improvement permit has been designed and can be installed and operated in compliance with Article 11 of Chapter 130A of the General Statutes of North Carolina and Rules adopted pursuant to this Article. This Construction Authorization is valid for a period of 5 years from the original date of issue. The Construction Authorization must be renewed upon expiration prior to the installation/repair of the wastewater system, or prior to the issuance of any required building permits. A pre-construction conference with the owner or developer, or an agent of the owner or developer, and the health department will be required for re-issuance of the Construction Authorization.

I agree to install the wastewater disposal system in accordance with the improvement permit, construction authorization and any conditions specified therein.

Signed: [Signature] Date: 1/8/04 Construction Authorization prepared by: Alisa Smith ms, es Date: 2-20-03

PERMIT AND CONSTRUCTION AUTHORIZATION MUST BE ON SITE DURING ALL PHASES OF CONSTRUCTION/INSTALLATION AND INSPECTION

are unequal or if use of D-box is impractical

Vicinity Map

HOUSE SITE

DRAIN-FIELD AREA

File Name: Robert Pastorino/Big Hill Lot 62
PIN: 8581-88-4031-000
Scale: 1" = 50'

Permit No.: 03-063

