

**PIN: 8734-33-4771**

**Permit Type: Septic Record**




# HAYWOOD COUNTY ENVIRONMENTAL HEALTH DEPARTMENT

157 Paragon Parkway Suite 200  
Office: (828) 452-6682 Fax: (828) 452-679

## OPERATIONS PERMIT

Permit Number AKI-707 P.I.N Map#: 8734 Block#: 33 Lot#: 4771 Permit Date 3/18/18  
Owner: FIGUEROA, DANIEL ALEXIS Associated Permits AKI-304W  
Subdivision \_\_\_\_\_ Section No.: \_\_\_\_\_ Lot No.: \_\_\_\_\_  
Property Location HWY 209N, continue onto Max Patch Rd, continue onto gravel to 4823 Max Patch Rd on left

System Designed For:  New  Repair  Addition Establishment  Residence  Mobile Home  Other  
Design Flow 480 G.P.D. No. of Bedrooms: 4 Other Establishment Type \_\_\_\_\_  
Basement:  Yes  No Sewer Outlet Location \_\_\_\_\_ Source of Water Supply Individual well  
The following items are on file and are part of this permit:  GPS/GIS  Application  IP/CA  Soil Sheet  Ma  Plat Map  Engineer's Drawing

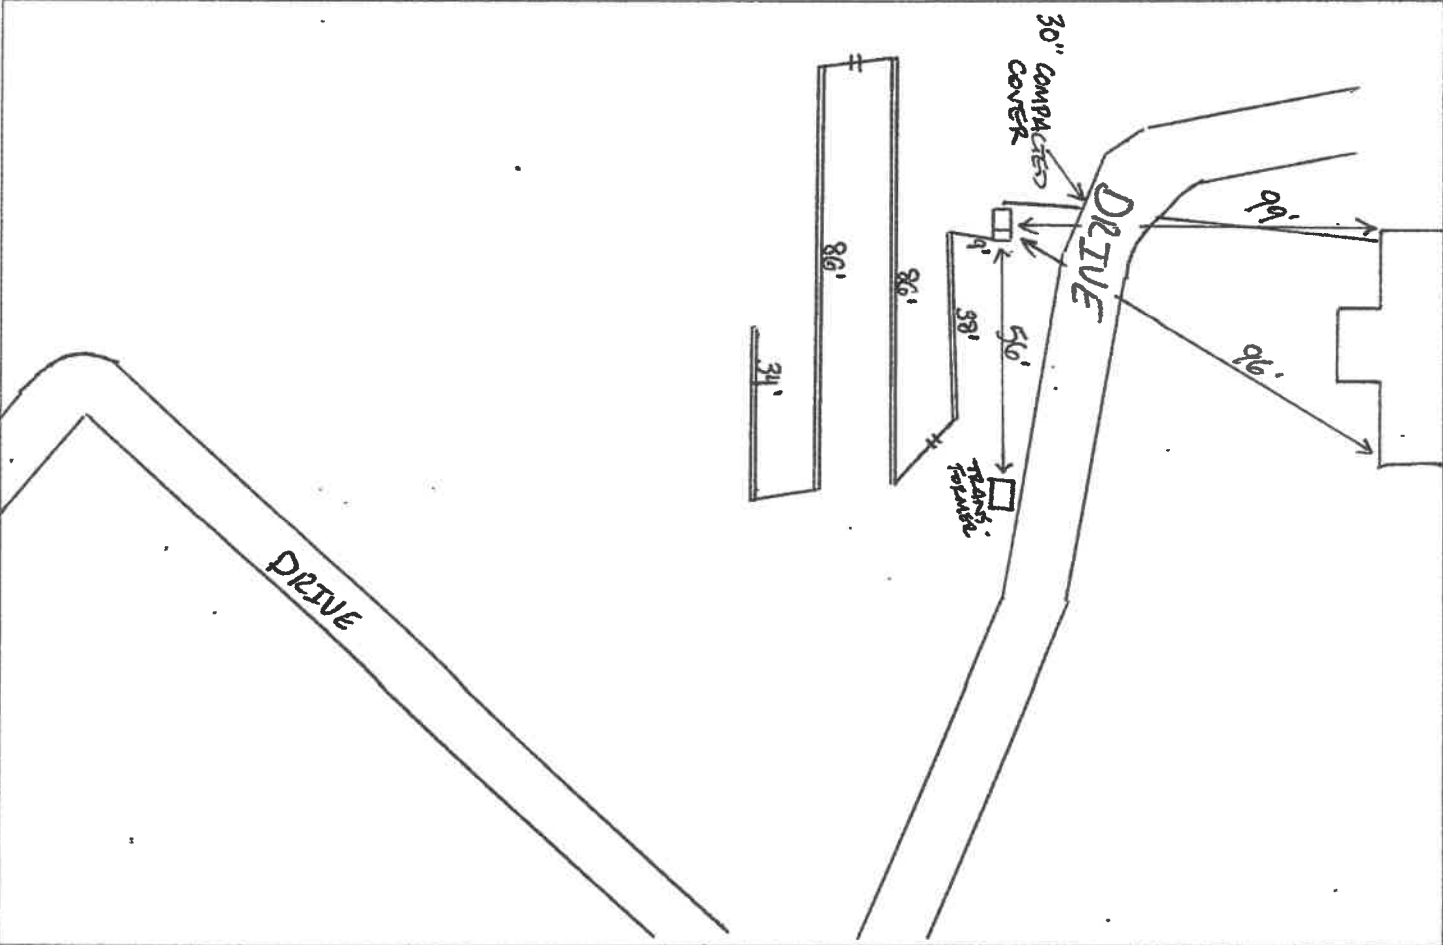

Septic Tank  New  Existing; Material: Plastic Manufacturer Infiltrator Capacity: 1060  
 New Nitrification Field SQ. Footage: 960 Type: Quick 4 Chambers No. Lines: 4 Length: 244  
No. Units: 59  Gravity System  Pump System Distribution  Serial  Distribution Box  Manifold  
Pump Tank Manufacturer \_\_\_\_\_ Material: \_\_\_\_\_ Capacity: \_\_\_\_\_  
Pump Manufacturer \_\_\_\_\_ Size: \_\_\_\_\_ Model No.: \_\_\_\_\_ Dosing: \_\_\_\_\_  
Proposed Repair Type 2' chambers Area: 960 LTAR .5 Sapolite  Yes  No  
For Repair or Addition Existing SQ. Footage \_\_\_\_\_ Type: \_\_\_\_\_ No. Lines: \_\_\_\_\_ Length: \_\_\_\_\_  
Nearest Distance to Water Supply \_\_\_\_\_ Stream \_\_\_\_\_ Foundation \_\_\_\_\_ Property Lines \_\_\_\_\_  
Installed By: David Thomas Cert. #: \_\_\_\_\_ Inspection Date 11/1/2017 REHS Adam Jones, REHS  
Remarks \_\_\_\_\_  
Approved  Yes  No REHS Adam Jones

Notice: Do not park, drive, or build over any part of septic system. Check tank for pumping and effluent filter at least every 3 years.  
This approval is issued subject to all provisions of Article II, G.S. 130A 333-343 of the General Statutes of North Carolina and Laws and Rules for Sanitary Sewage Collection, Treatment and Disposal, 15A NCAC 18A, 1900.  
No person is permitted to make alterations in the design or use of this system other than its designated use without approval of an authorized REHS. This approval indicates that this system has been installed in compliance with the standards set forth in the above regulation, but shall in no way be taken as a guarantee that the system will function satisfactorily for any given period of time.

