

PIN: 8734-33-4771

Permit Type: Well Record

HAYWOOD COUNTY ENVIRONMENTAL HEALTH DEPARTMENT

OFFICE (828) 452-6682 FAX (828) 452-6798

WELL CERTIFICATE OF COMPLETION

Permit Number Associated Permits


Permit issue date Parcel ID Receipt Number

Owner Phone

Address

Directions

Subdivision Section Lot Number

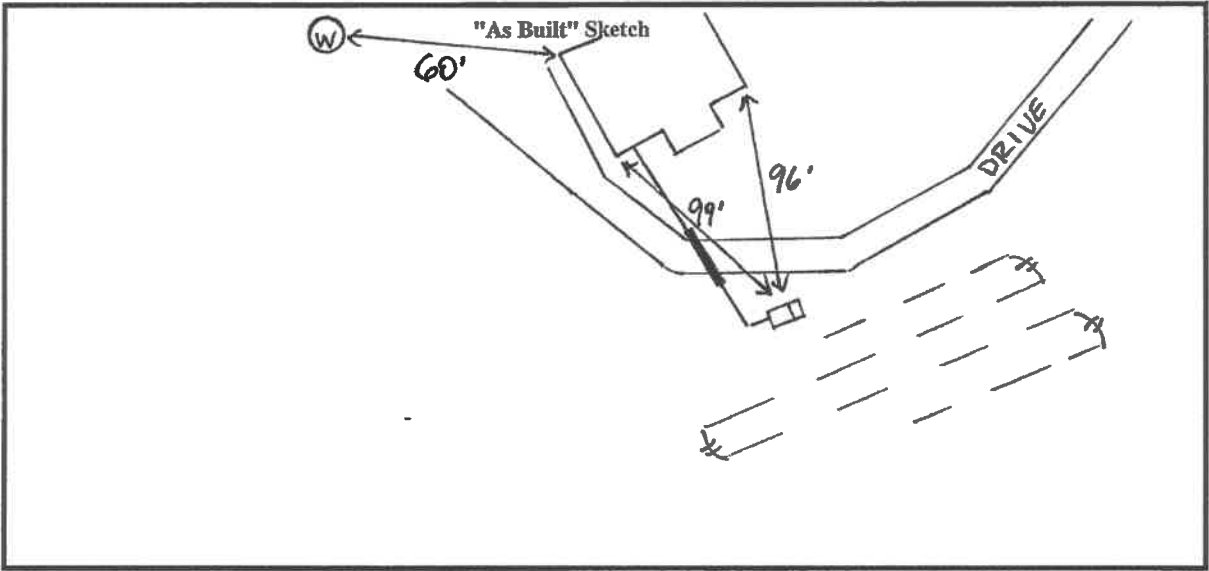

Grout Date Well Grout Inspection

Depth at Grout ft Casing Type Casing Diameter in Casing Weight

Casing Depth ft Grout Method Grout Depth ft

Grout Type(s)

Grout Material(s)

Well Company Driller and Reg#

Well Constructed in correct location Well Grout Inspected By:

Well Head Date Well Head Inspection

12" Above Grade Air Vent Seal Hose Bib Well Tag Pump Tag

Total Depth ft Yield gpm Static Water Level ft Pump Installer Reg #

Well Head Inspected By:

GW-1A Received

COC Issued By: *Nathan Heath* Date Issued:

|