

21-150 9-15-21



TRANSYLVANIA COUNTY DEPARTMENT OF PUBLIC HEALTH
WELL PERMIT OR WELL REPAIR PERMIT.
CERTIFICATE OF COMPLETION

New Well Repair To Existing Well

94-6433

WP 21-122

8596-84-6636-000

Bryson, Joe

Permit No.

Parcel I.D.

Issued To

TBD Poplar Crest Drive

Poplar Crest/ Lot 34

Property Street Address

Subdivision /Sec/Lot#

Well Grouting Inspection

Casing Type PVC

Casing Thickness/Weight SDR-21

Casing Depth 55'

Diameter 6.25"

Grout Type Bentonite / Holeplug

Grout Depth 20'

Grout Method Pump/Screened

Inspected By: Jaylon Sloop REHSI Date: 12/2/2021

Well Head Inspection

Inches Above Grade 12" ✓

Air Vent ✓

Threadless Sample Tap ✓

Sanitary Seal ✓

(if hose bib) Anti-Siphon Present n/a

Well Plate ✓

Pump Plate ✓

Well Depth 305'

Static Water Level 60'

Yield 6 gpm

Contractor McCrory
Certification # 3156
Date 12/20/21 Depth 280'
Horsepower F:W 3/4

* 5/9/22; Well head denied, threadless tap was taken off & replaced w/ threaded (JS)
* 5/10/22; Well head approved. Matt sent a picture of threadless tap being re-installed (JS)

Inspected By: Jaylon Sloop REHSI Date: 5/10/22


Well Report Received (GW-1a)

Well Contractor McCrory / Matt Parker

Certification # 3156

Issued By: Jaylon Sloop REHSI

Date 5/10/22

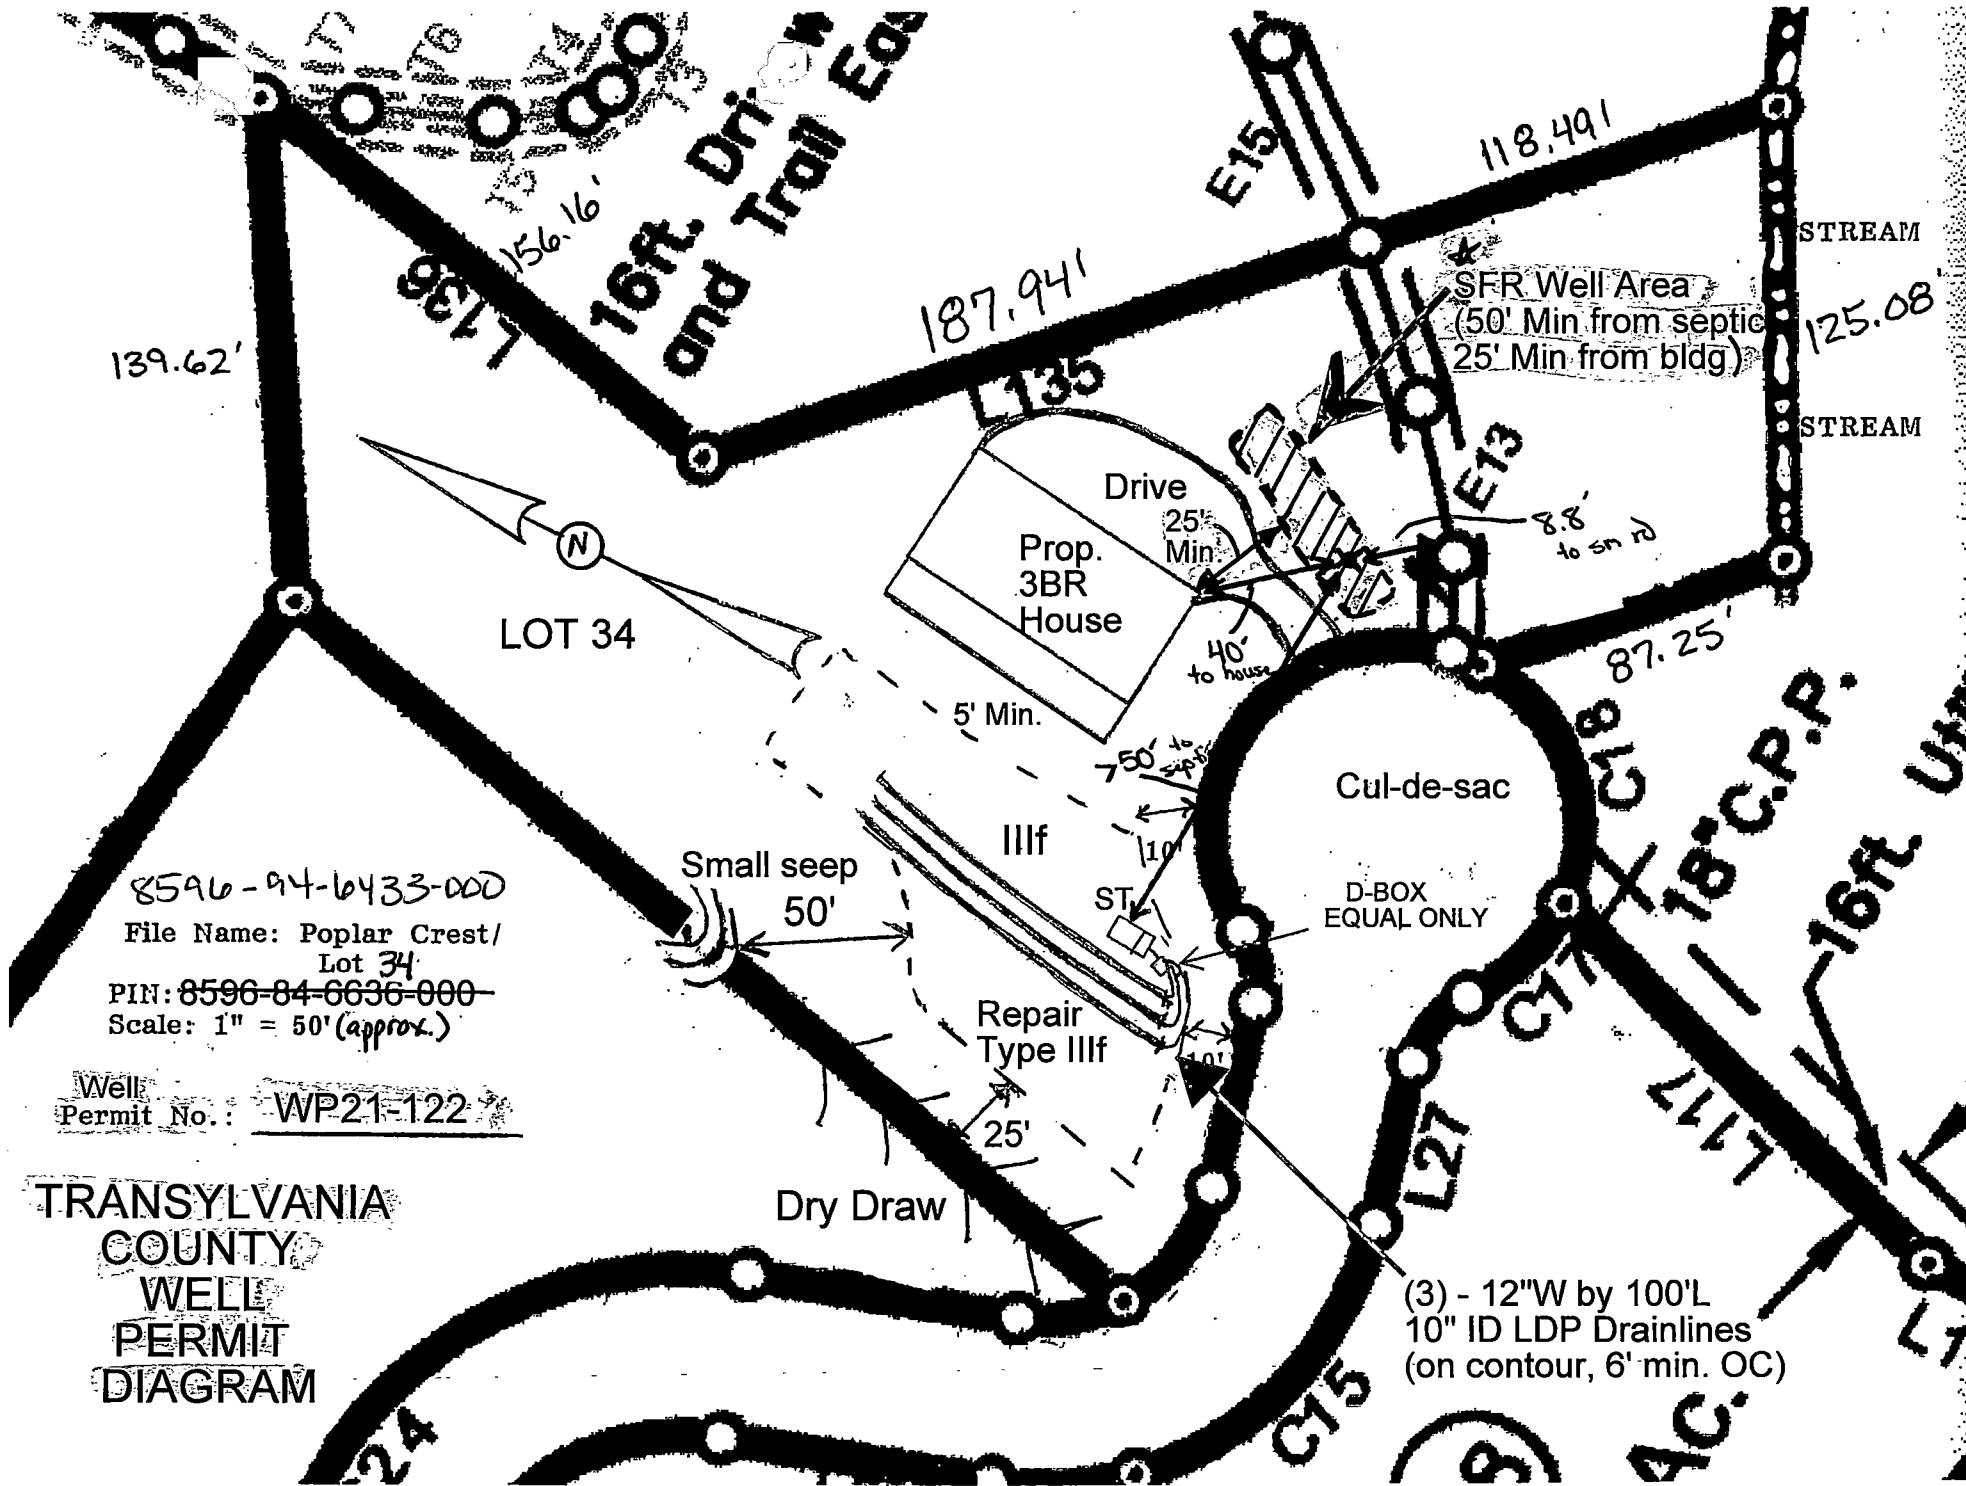

8596-94-6433-000
 File Name: Poplar Crest/
 Lot 34
 PIN: 8596-84-6636-000
 Scale: 1" = 50' (approx.)

Well Permit No.: WP21-122

TRANSYLVANIA
 COUNTY
 WELL
 PERMIT
 DIAGRAM

(3) - 12"W by 100'L
 10" ID LDP Drainlines
 (on contour, 6' min. OC)