

TRANSYLVANIA COUNTY HEALTH DEPARTMENT

(Sewage Disposal System) Improvements Permit and Certificate of Completion Sewage Treatment and Disposal Rules (ARTICLE 11 of CHAPTER 130A OF THE GENERAL STATUTES OF NORTH CAROLINA)

APPLICATION FOR:

Improvements Permit
 Lot Evaluation _____
 Sub-Division Evaluation _____
 Mobile Home Park Evaluation _____

2pm
12/1/86

FEES:

Paid \$ 25 Date 12/4/86 Initials Y

9506-10-4953-000

Owner-Occupant Spec Address Route 3 North Fork Fire Rd
 Location of Property 2nd entrance Campbell St 1st gravel pit entrance to left next entrance to Aberdeen

Plat/Of Property: Yes No _____ Phone No. 3-8245
 Type of Facility: House ; Mobile Home _____; Business _____; No. Bedrooms 3; No. Baths 2
 Estimated Sewage Flow: 300 Gals. Per Day: Has Any Grading Been Done On Property? Yes No _____
 Type of Water Supply: Drilled Well ; Spring _____; Individual ; Community _____; Public _____
 Are There Any Easements Or Right-of-Ways On This Property? Yes _____; No Road R/W
 SIGNATURE OF OWNER OR AUTHORIZED AGENT: Charles Morgan DATE: 12-1-86

IMPROVEMENTS PERMIT AND CERTIFICATE OF COMPLETION

Owner-Occupant same
 Location same
 Subdivision Allen Cannon
 Lot No. 3620 Sect. of Block No. _____
 Building Contractor Charles Morgan
 Address _____
 Septic Tank Contractor Ron Hubbard
 Address _____
 Sewage Disposal System For:
 New Existing/Repair _____
 Addition/Renovation _____
 Mobile Home Relocation _____
 Size of Septic Tank 1000 Gals. (Liquid)
 Material: Pre-Cast Block _____ Fiberglass _____
 Distribution Box: Yes No _____
 No. of Lines: 2; Width 3 Ft.; Length 100 Ft.
 (Maximum Depth of Trench) 24" (inches) 70'
 Site Classification:
 Suitable _____ Provisionally Suitable
 Unsuitable _____
 Do You Anticipate Any Additions To Proposed Building? Yes _____ No

NOTE: There Are To Be No Changes In Above Lay-Out Without Permission Of Health Department Representative.


IMPROVEMENTS PERMIT: DATE 12/1/86
 By Keith Norton

CERTIFICATE OF COMPLETION: DATE 2-9-87
 By Keith Norton

NOTICE: System installed according to Rules and Regulations but not a guarantee that it will function satisfactorily for any given period of time.

COLOR CODE: White-Owner; Pink-Improvements Permit; Blue-Contractor; Yellow-Inspection Dept.; Green-Health Dept.

IMPROVEMENTS PERMIT SKETCH

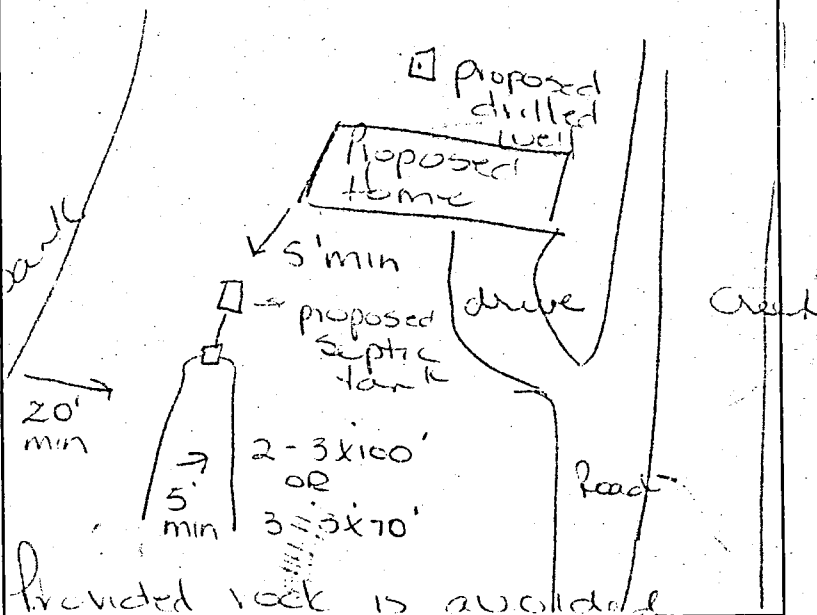

CERTIFICATE OF COMPLETION SKETCH

