


**Main Level**

**3/16" = 1'-0"**

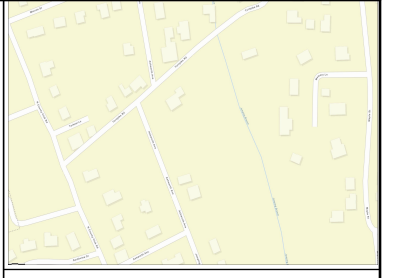

**PROJECT LOCATION MAP**


GENERAL NOTES:  
 1. DO NOT USE AS A BLUEPRINTS WITHOUT MR LLC PERMISSION.  
 2. PLEASE NOTE INTERIOR DIMENSIONS WERE NOT USED IN CALCULATING SQUARE FOOTAGE  
 3. SIZE OF HEATED AND NOT HEATED AREA AND OTHER INFORMATION WERE OBTAINED PER THE NC REAL ESTATE COMMISSION GUIDELINES ( 6" FOR EXTERNAL WALLS EXCEPT CONDOMINIUMS)  
 4. FOR REMODELING QUESTIONS OR MORE DETAILED CAD DRAWINGS (INC.SITE PLAN, SECTIONS, ELEVATIONS) ALSO 3D MODEL PLEASE CONTACT ALFRED ZALYS  
 MOB. 828 231 7305 E-MAIL: A.ZALYS@HOTMAIL.COM

Client:  
 #Client E-mail  
 #Client Phone Number

LEGEND MAP:  
 HEATED FINISHED/RESIDENTIAL  
 HEATED FINISHED/COMMERCIAL  
 NOT HEATED/NOT FINISHED  
 COVERED PORCH  
 OPEN DECK

Revision History

RevID	ChID	Change Name	Date

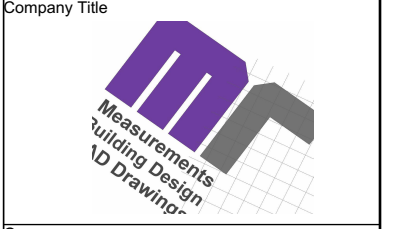

Company  
**Measure Rite LLC**  
 103 Poplar Spring Trl. Hendersonville  
 Henderson County 28739


Site Address  
**208 Ashworth Ave, Brevard, NC 28712**

Drawing Name  
**Main Level, Building Area Schedule**

Drawing Status  
**AS Built**


Contact Name: **Alfred ZALYS**  
 Job Nr: **MR 1103**  
 Date: **5/13/2024**  
 Drawing Scale: 3/16" = 1'-0", 1:1.63  
 Layouts Total: **#NumOfLayoutsInSubset**  
 Paper Size: **ANSI B**  
 Layout ID: **AS Built**      Revision:

Building Area Schedule			
Home Story	Floor Area	Type	Area
Lower Level			
	1. HEATED/LOWER	Internal Heated Zone	807.53
Main Level			
	1. HEATED/MAIN	Internal Heated Zone	1,500.91
	2. PORCH	External Zone/Covered	78.00
	3. FRONT PORCH	External Zone/Covered	87.00
			<b>2,473.44 ft<sup>2</sup></b>

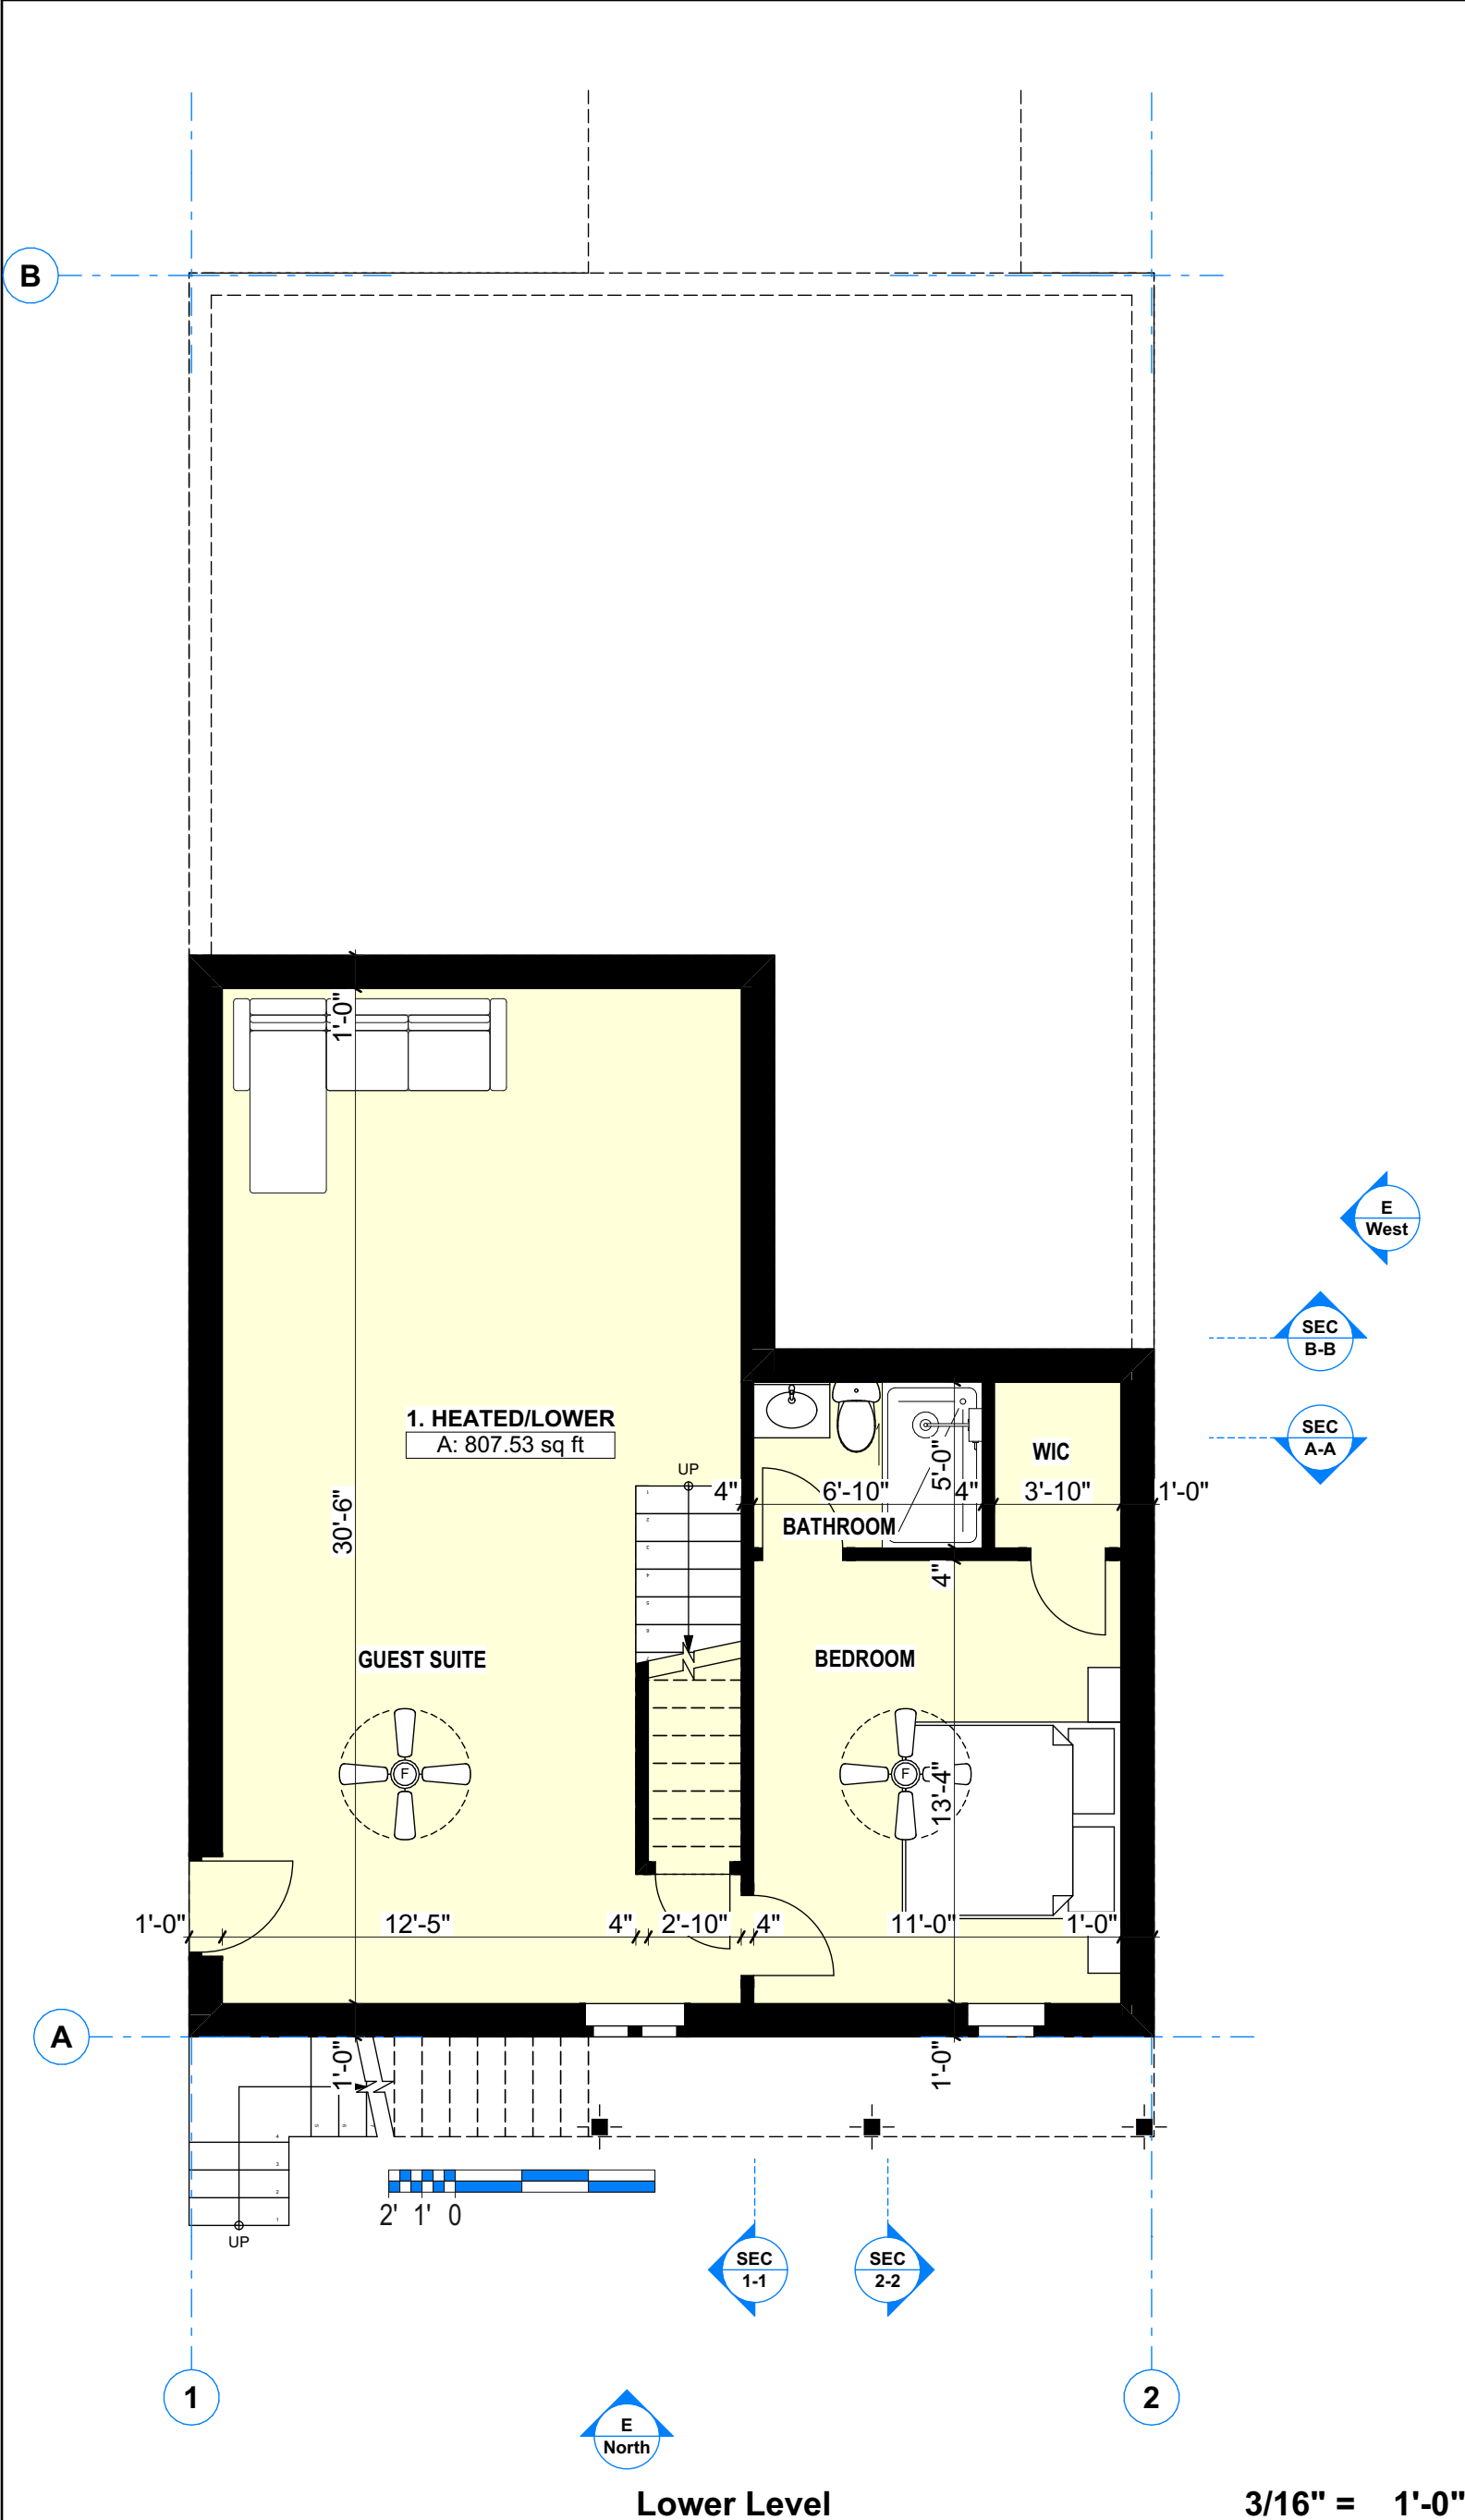

**Lower Level**

**3/16" = 1'-0"**

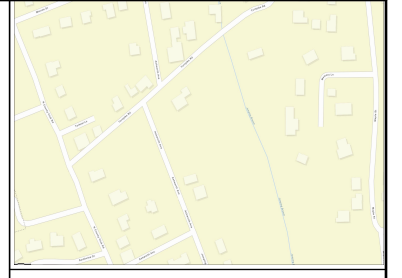

**PROJECT LOCATION MAP**

GENERAL NOTES:  
 1. DO NOT USE AS A BLUEPRINTS WITHOUT MR LLC PERMISSION.  
 2. PLEASE NOTE INTERIOR DIMENSIONS WERE NOT USED IN CALCULATING SQUARE FOOTAGE  
 3. SIZE OF HEATED AND NOT HEATED AREA AND OTHER INFORMATION WERE OBTAINED PER THE NC REAL ESTATE COMMISSION GUIDELINES ( 6" FOR EXTERNAL WALLS EXCEPT CONDOMINIUMS)  
 4. FOR REMODELING QUESTIONS OR MORE DETAILED CAD DRAWINGS (INC.SITE PLAN, SECTIONS, ELEVATIONS) ALSO 3D MODEL PLEASE CONTACT ALFRED ZALYS  
 MOB. 828 231 7305 E-MAIL: A.ZALYS@HOTMAIL.COM


Client:  
**#Client E-mail**  
**#Client Phone Number**

LEGEND MAP:

- HEATED FINISHED/RESIDENTIAL
- HEATED FINISHED/COMMERCIAL
- NOT HEATED/NOT FINISHED
- COVERED PORCH
- OPEN DECK

Revision History

RevID	ChID	Change Name	Date

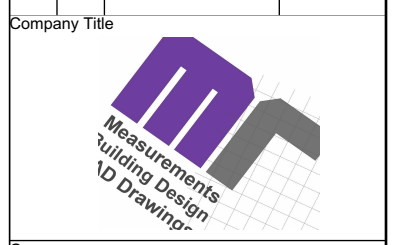

Company  
**Measure Rite LLC**  
 103 Poplar Spring Trl. Hendersonville  
 Henderson County 28739


Site Address  
**208 Ashworth Ave, Brevard, NC  
 28712**

Drawing Name  
**Lower Level, Building Area  
 Schedule**

Drawing Status


Contact Name <b>Alfred ZALYS</b> mob. 828 231 7305	Job Nr. <b>MR 1103</b> Date <b>5/13/2024</b>
Drawing Scale 3/16" = 1'-0", 1:1.63	Layouts Total <b>#NumOfLayoutsInSubset</b> Paper Size <b>ANSI B</b>
Layout ID <b>AS Built</b>	Revision

Building Area Schedule			
Home Story	Floor Area	Type	Area
Lower Level			
	1. HEATED/LOWER	Internal Heated Zone	807.53
Main Level			
	1. HEATED/MAIN	Internal Heated Zone	1,500.91
	2. PORCH	External Zone/Covered	78.00
	3. FRONT PORCH	External Zone/Covered	87.00
			<b>2,473.44 ft<sup>2</sup></b>

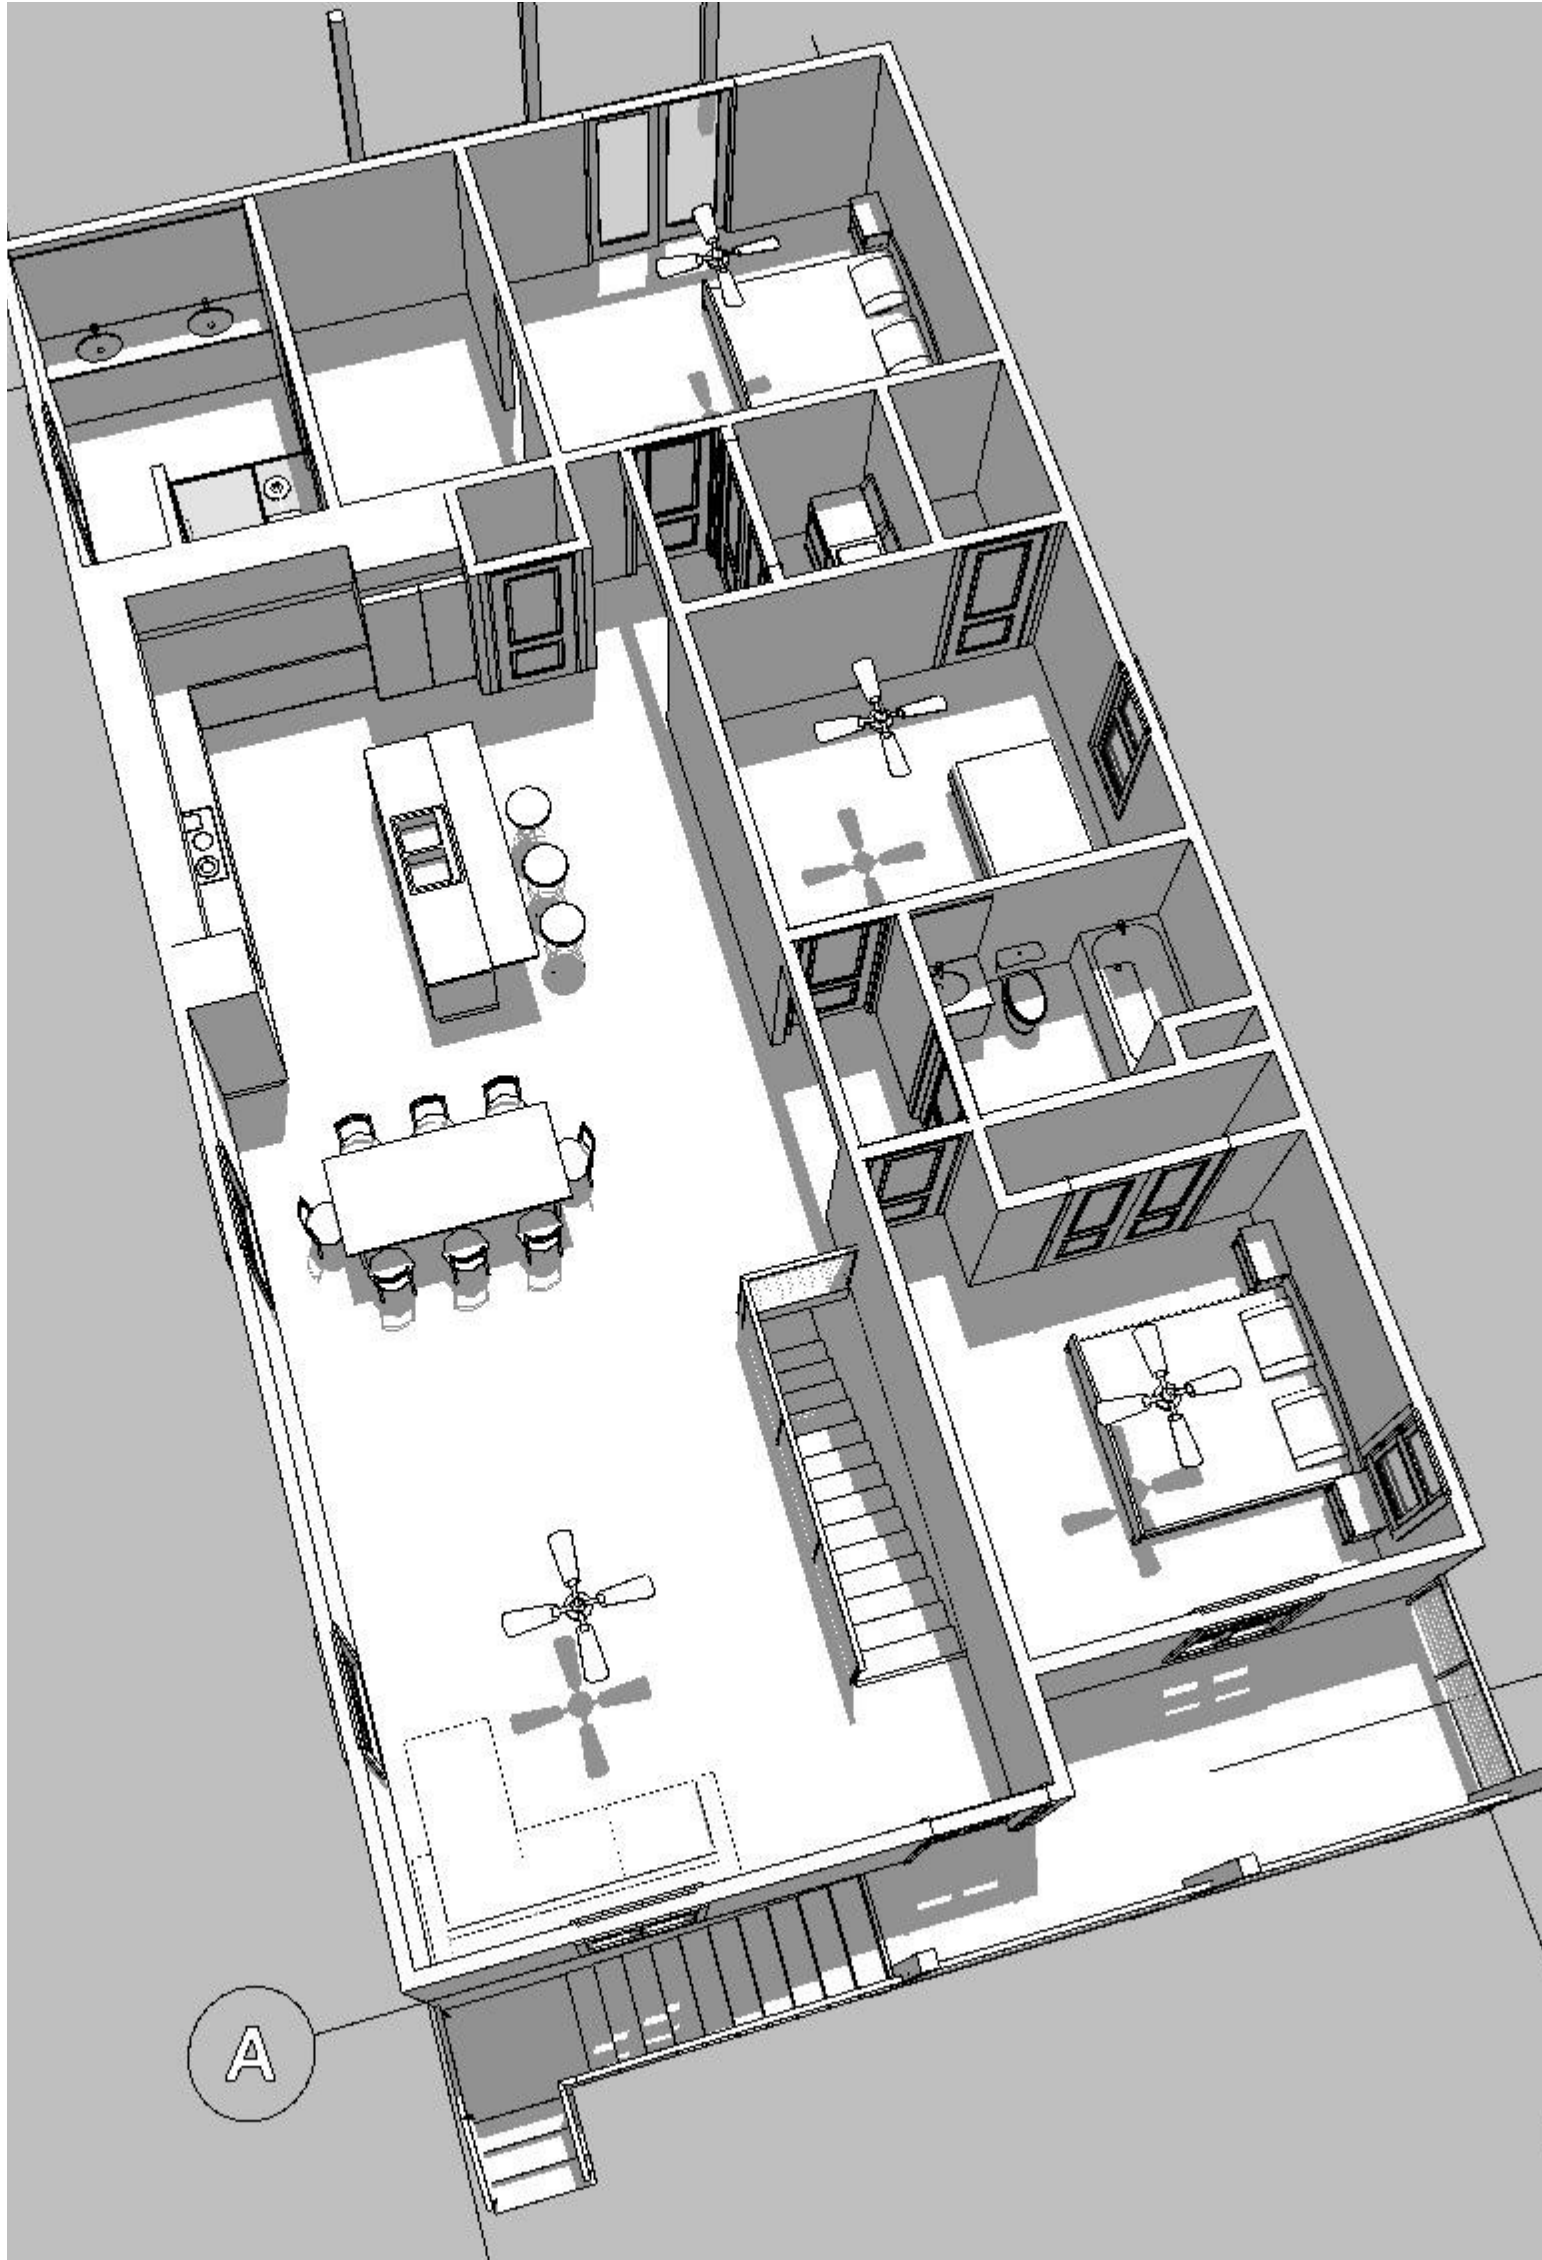

**Generic Perspective / MAIN**

**3/32" = 1'-0"**

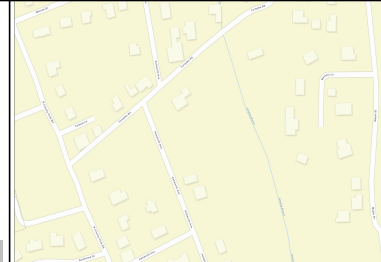

**PROJECT LOCATION MAP**


**GENERAL NOTES:**  
 1. DO NOT USE AS A BLUEPRINTS WITHOUT MR LLC PERMISSION.  
 2. PLEASE NOTE INTERIOR DIMENSIONS WERE NOT USED IN CALCULATING SQUARE FOOTAGE  
 3. SIZE OF HEATED AND NOT HEATED AREA AND OTHER INFORMATION WERE OBTAINED PER THE NC REAL ESTATE COMMISSION GUIDELINES ( 6" FOR EXTERNAL WALLS EXCEPT CONDOMINIUMS)  
 4. FOR REMODELING QUESTIONS OR MORE DETAILED CAD DRAWINGS (INC.SITE PLAN, SECTIONS, ELEVATIONS) ALSO 3D MODEL PLEASE CONTACT ALFRED ZALYS MOB. 828 231 7305 E-MAIL: A.ZALYS@HOTMAIL.COM

Client:  
**#Client E-mail**  
**#Client Phone Number**

**LEGEND MAP:**  
 HEATED FINISHED/RESIDENTIAL  
 HEATED FINISHED/COMMERCIAL  
 NOT HEATED/NOT FINISHED  
 COVERED PORCH  
 OPEN DECK

**Revision History**

RevID	ChID	Change Name	Date

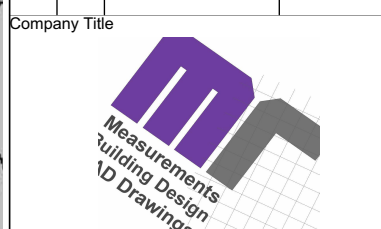

Company  
**Measure Rite LLC**  
 103 Poplar Spring Trl. Hendersonville  
 Henderson County 28739


Site Address  
**208 Ashworth Ave, Brevard, NC 28712**

Drawing Name  
**Generic Perspective / MAIN**

Drawing Status


Contact Name <b>Alfred ZALYS</b> mob. 828 231 7305	Job Nr. <b>MR 1103</b>
Drawing Scale 3/32" = 1'-0"	Date <b>5/13/2024</b>
Layouts Total	#NumOfLayoutsInSubset
Layout ID	Paper Size <b>ANSI B</b>

Revision  
**AS Built**

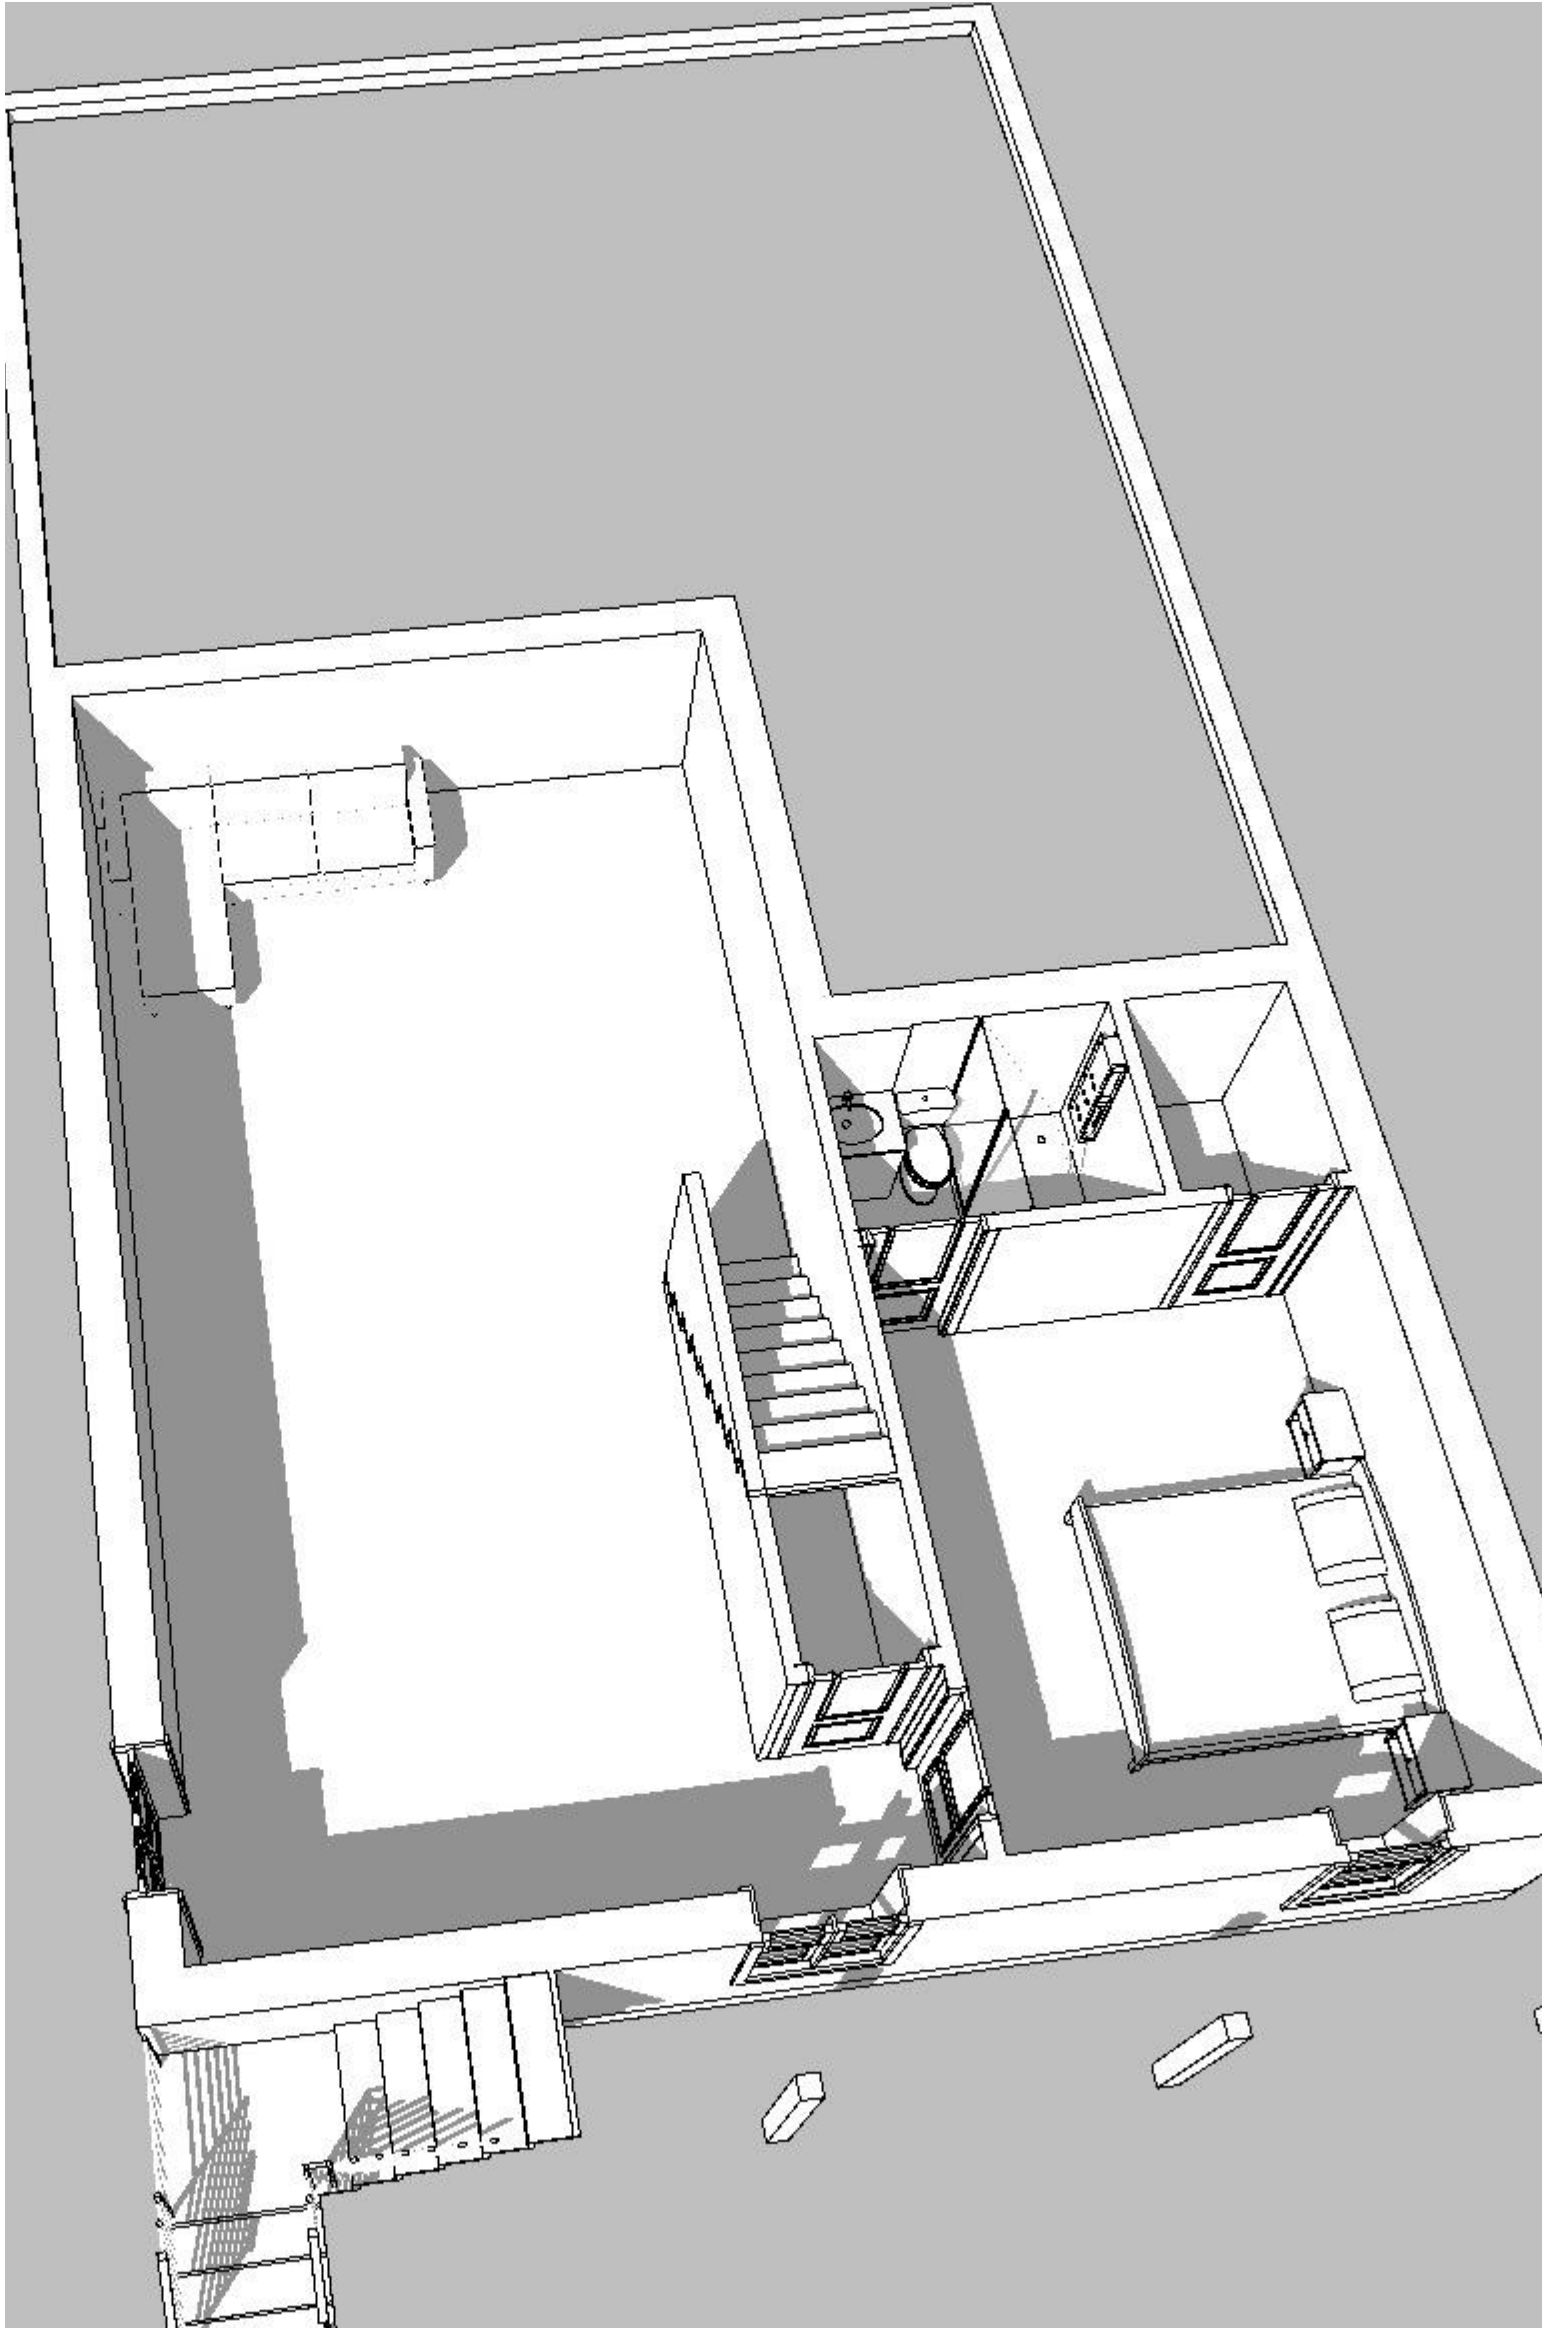

**Generic Perspective / LOWER**


**3/32" = 1'-0"**

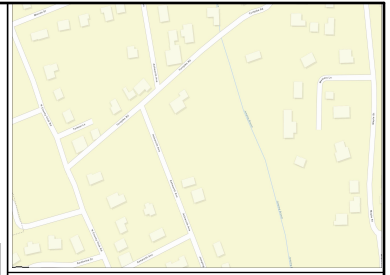

**PROJECT LOCATION MAP**


GENERAL NOTES:  
 1. DO NOT USE AS A BLUEPRINTS WITHOUT MR LLC PERMISSION.  
 2. PLEASE NOTE INTERIOR DIMENSIONS WERE NOT USED IN CALCULATING SQUARE FOOTAGE  
 3. SIZE OF HEATED AND NOT HEATED AREA AND OTHER INFORMATION WERE OBTAINED PER THE NC REAL ESTATE COMMISSION GUIDELINES ( 6" FOR EXTERNAL WALLS EXEPT CONDOMINIUMS)  
 4. FOR REMODELING QUESTIONS OR MORE DETAILED CAD DRAWINGS (INC.SITE PLAN, SECTIONS, ELEVATIONS) ALSO 3D MODEL PLEASE CONTACT ALFRED ZALYS MOB. 828 231 7305 E-MAIL: A.ZALYS@HOTMAIL.COM

Client:  
**#Client E-mail**  
**#Client Phone Number**

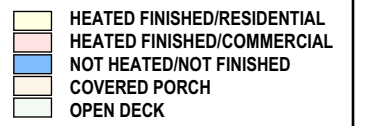LEGEND MAP:  
  
 HEATED FINISHED/RESIDENTIAL  
 HEATED FINISHED/COMMERCIAL  
 NOT HEATED/NOT FINISHED  
 COVERED PORCH  
 OPEN DECK

Revision History

RevID	ChID	Change Name	Date

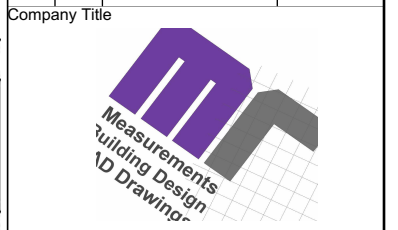

Company  
**Measure Rite LLC**  
 103 Poplar Spring Trl. Hendersonville  
 Henderson County 28739

Site Address  
**208 Ashworth Ave, Brevard, NC  
 28712**

Drawing Name  
**Generic Perspective / LOWER**

Drawing Status

Contact Name <b>Alfred ZALYS</b> mob. 828 231 7305	Job Nr. <b>MR 1103</b>
Drawing Scale 3/32" = 1'-0"	Date <b>5/13/2024</b>
Layout ID <b>AS Built</b>	Revision