

HENDERSON COUNTY HEALTH DEPARTMENT

Completion Permit

New Construction
Repair
Pre-Existing Tank

Permit Number


C R? 11792
I No. 16428

Owner WINDTECH, CORP. Date 2/8/90
Building Contractor
Septic Tank Installer GARY KING
Location 255 TO RT ON LITTLE RIVER RD TO
Lot No. 31 Development WOODHAUEN

House [X] Mobile Home [] Other []
No. Bedrooms 3
Basement Plumbing Yes [] No [X]
Water Supply - Community [X] Individual [] City []
Lot Size 1A+ Design Flow GPD 360

Tank Size 1000 Drain Field 720 Sq. Ft.
Stone Depth 12 Inches

Valid only for use as described above

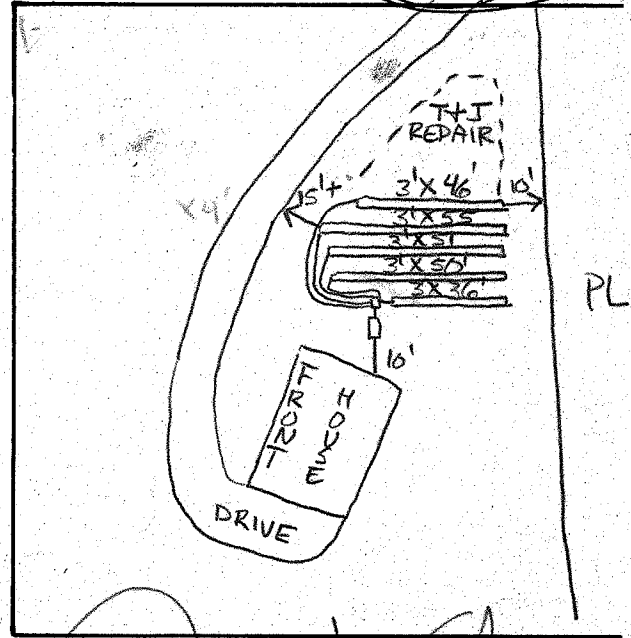

Received by Gary King

Approved for Material & Workmanship Only

Issued by David S. Edwards, R.S. Sanitarian

* TRENCHES ON CONTOUR *

HENDERSON COUNTY HEALTH DEPARTMENT

SEPTIC TANK SYSTEM IMPROVEMENTS PERMIT

Call 692-4228 between 8 - 4:30 p.m.

Owner WINDTECH, CORP. Date 11/27/89
Building Contractor
Location 255 TO LITTLE RIVER RD TO
Lot # 31 Development RT INTO WOODHAUEN

House [X] Mobile Home [] Other []
No. Bedrooms 3 Design Flow GPD 360
Basement ON LT AT END OF
Water Supply - Community [X] Individual [] City []
Lot Size 1A+
Site Evaluation - Suitable [] Provisional [X] Unsuitable []
Tank Size 900+ Drain Field 720 Sq. Ft.
Stone Depth 12 Inches Applic. Rate 0.5

Valid only for use as prescribed above.


Notify department in advance for any changes needed.

Zoning regulations may be in effect in your area, before proceeding with construction, check with the Henderson County Zoning Officer or Inspection Department.

Permit valid for 3 years from date of issuance

Received By [Signature]

Approved [X] For Conventional System
Disapproved []
New Construction [X]
Repairs []
Pre-Existing Tank []
Addition []
Permit Number I. 16428

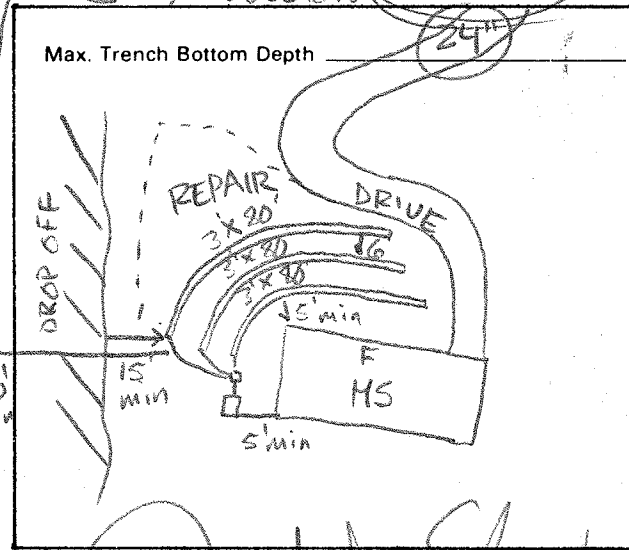

Issued by David S. Edwards Sanitarian

APPLICATION FOR LOT EVALUATION FOR SUB-SURFACE SEWAGE DISPOSAL
Construction is not to begin until a building permit has been issued!

Before an inspection can be made, a copy of the survey plat must be on file with the Health Department. Corners of the property and proposed constructions must be clearly staked and lot cleared.

REQUIREMENTS: All aspects of the State Building Code must be complied with. In addition your proposed building site may be in a zoned area. Please check with the Henderson County Building and Zoning Department and City Building Inspections about these regulations. You may obtain this information from Mr. Sam Laughter at 697-4833 - 246 Second Avenue East, Hendersonville, NC or Mr. Fred Gordon at 697-3010 - City Hall Building, Hendersonville, NC.

Do not grade your lot until the Sanitarian has visited your proposed building site and issued an Improvements Permit. Once the Improvements Permit has been issued, the area over the septic tank nitrification field, and repair area for the septic tank and nitrification field may not be graded. If this area is graded, you will void your Improvements Permit. If the area is graded before an Improvements Permit is issued, you may not be issued an Improvements Permit.

An Improvements Permit, once issued by the Henderson County Health Department, is valid for a period of 3 years from the date it is issued. A soil evaluation is not a legal document, and is not valid for any period of time. A soil evaluation is strictly an indication of general soil conditions over a vast area, and the evaluation does not address other areas of concern such as repair area, setback, distances to streams, property line, etc., nor does it address the location of the septic tank drainfield. For the above reasons, the Health Department strongly urges you to obtain an Improvements Permits and not a Soil Evaluation. Keep in mind that if you do request a Soil Evaluation, it does **NOT guarantee an Improvements Permit will be issued for your proposed building site.**

Permits issued by the Henderson County Health Department may be changed only by the Henderson County Health Department. Any alterations or deviations from the Improvements Permit may result in your Improvements Permit being voided by the Henderson County Health Department.


1. Permit Requested By WINDTECH CORP. Bus. Ph. 691-0411 Home Ph. DUSTY RHODES
2. Current Owner's Name & Address CARL & MARY FISHER HENDERSONVILLE
3. Subdivision or Mobile Home Park Name WOODHAVEN Lot # 31
4. Date Lot Originally Platted 1/21/86 2:15
5. System will be used to serve what type of facility:
House Mobile Home _____ Business _____ Industry _____ Other _____
6. If house or mobile home, state size: Dimensions: 42 X 37 (2-STORY)
Number of: Bedrooms 3 Den with Closet NO Basement: Yes _____ No
Water using fixtures in basement? Yes _____ No
7. Property dimensions: Total square footage or acreage 1 A C M O L Width 12269 Depth 283.
8. Do you anticipate any additions or expansions of the facility this sewage system is intended to serve?
Yes _____ No What type? _____
9. Type of water supply? City _____ Individual (well or spring serving one family) COMMUNITY WELL
Community (well or spring serving more than one family) _____
10. If business, industry or other state: Number of employees: 255
11. DIRECTIONS TO PROPERTY (give road numbers and names) LITTLE EVER RD TO RR. ON MIDDLETON PL. TO END OF NEW PAVEMENT. PROP. ON LEFT AT END.

I certify the above to be correct to the best of my knowledge and permission is hereby granted to perform a soils evaluation on the property described above. Applicant has read the above information and answered all questions to the best of his or her ability and understands all instructions which are stated on the application.

11/16/89
Date

Signature

W. F. [Signature]

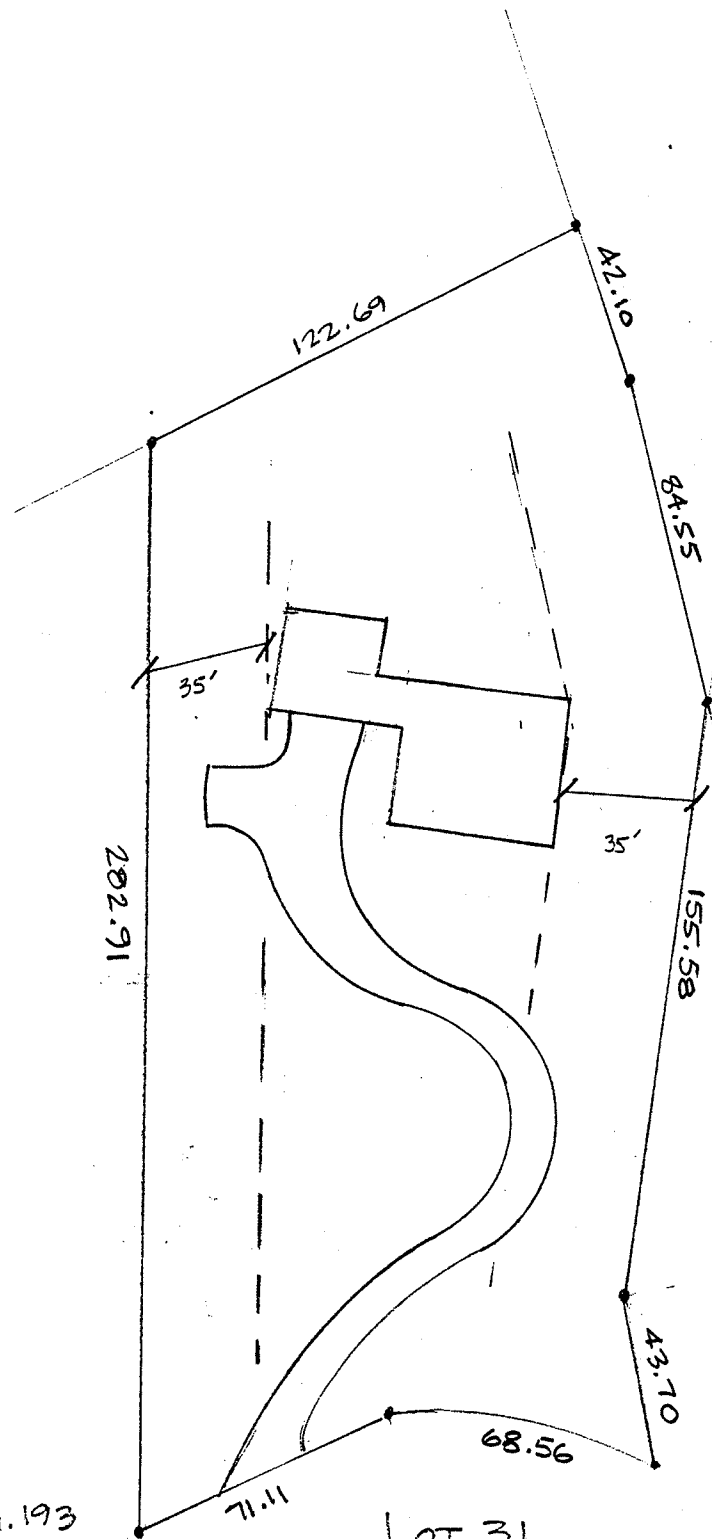

DEED BOOK 564 Pg. 193
 PLAT BOOK, CAB. A
 SLIDE 230A

LOT 31
 ° WOODHAVEN °

SURVEYED 1977, RECORDED 1/21/86