


**(Sewage disposal system) Improvements Permit and Certificate of Approval**

System 2: (Ground Absorption Sewage Disposal System - G.S. Chapter 130, Article 13C)


Henry C. McDonald, Jr.  
 & Cochran Construction Co.

OWNER-OCCUPANT John Connor BUILDING CONTRACTOR Cochran Construction Co.  
 LOCATION 11111 Highway 101, Transylvania County, NC  
 SUBDIVISION \_\_\_\_\_ LOT NO. 10 SECT. OR BLOCK NO. 11  
 SEPTIC TANK CONTRACTOR W. J. ... ADDRESS 11111 Highway 101

HOUSE  MOBILE HOME  BUSINESS   
 NO. BEDROOMS 2 NO. BATHROOMS 2  
 GARBAGE DISPOSAL UNIT YES  NO   
 AUTO. DISHWASHER YES  NO   
 AUTO. WASH. MACHINE YES  NO   
 SIZE OF SEPTIC TANK 2-1100 GALS. (Liquid)  
 MATERIAL: PRE-CAST  BLOCK  FIBERGLASS   
 DISTRIBUTION BOX YES  NO   
 NO. OF LINES (See Appendix) WIDTH 18" LENGTH 100' FT.  
 PERCOLATION TEST YES  NO

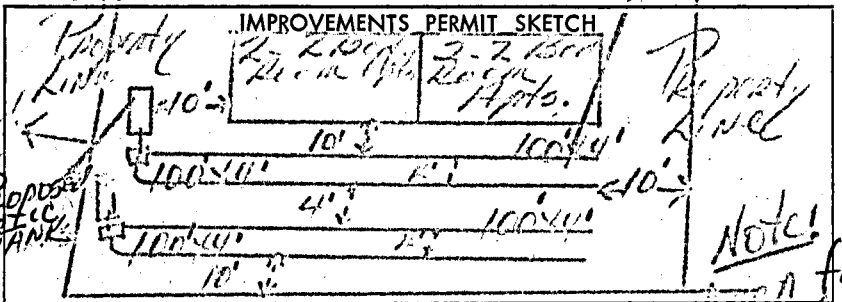


WATER SUPPLY: INDIVIDUAL  PUBLIC   
 IMPROVEMENTS PERMIT: DATE: 4-30-76  
 BY: W. J. ...

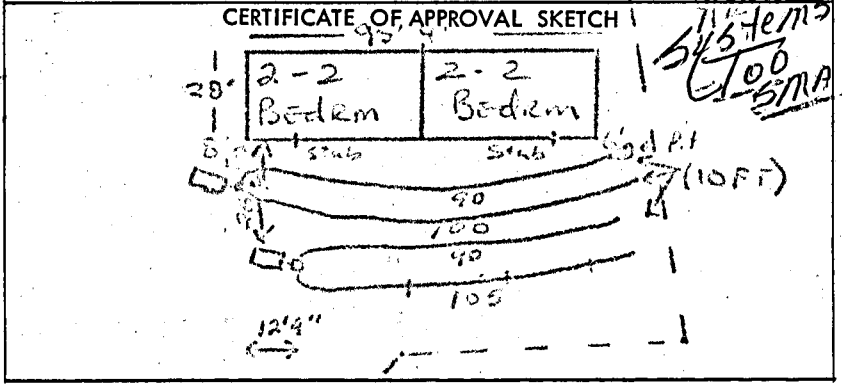

CERTIFICATE OF APPROVAL: DATE: 2-27-10  
 BY: David M. ...

NOTICE: System installed according to Rules and Regulations but not a guarantee that it will function satisfactorily for any given period of time.

COLOR CODE: White-Owner; Pink-Improvements Permit; Blue-Inspections Dept.; Green-Health Dept.

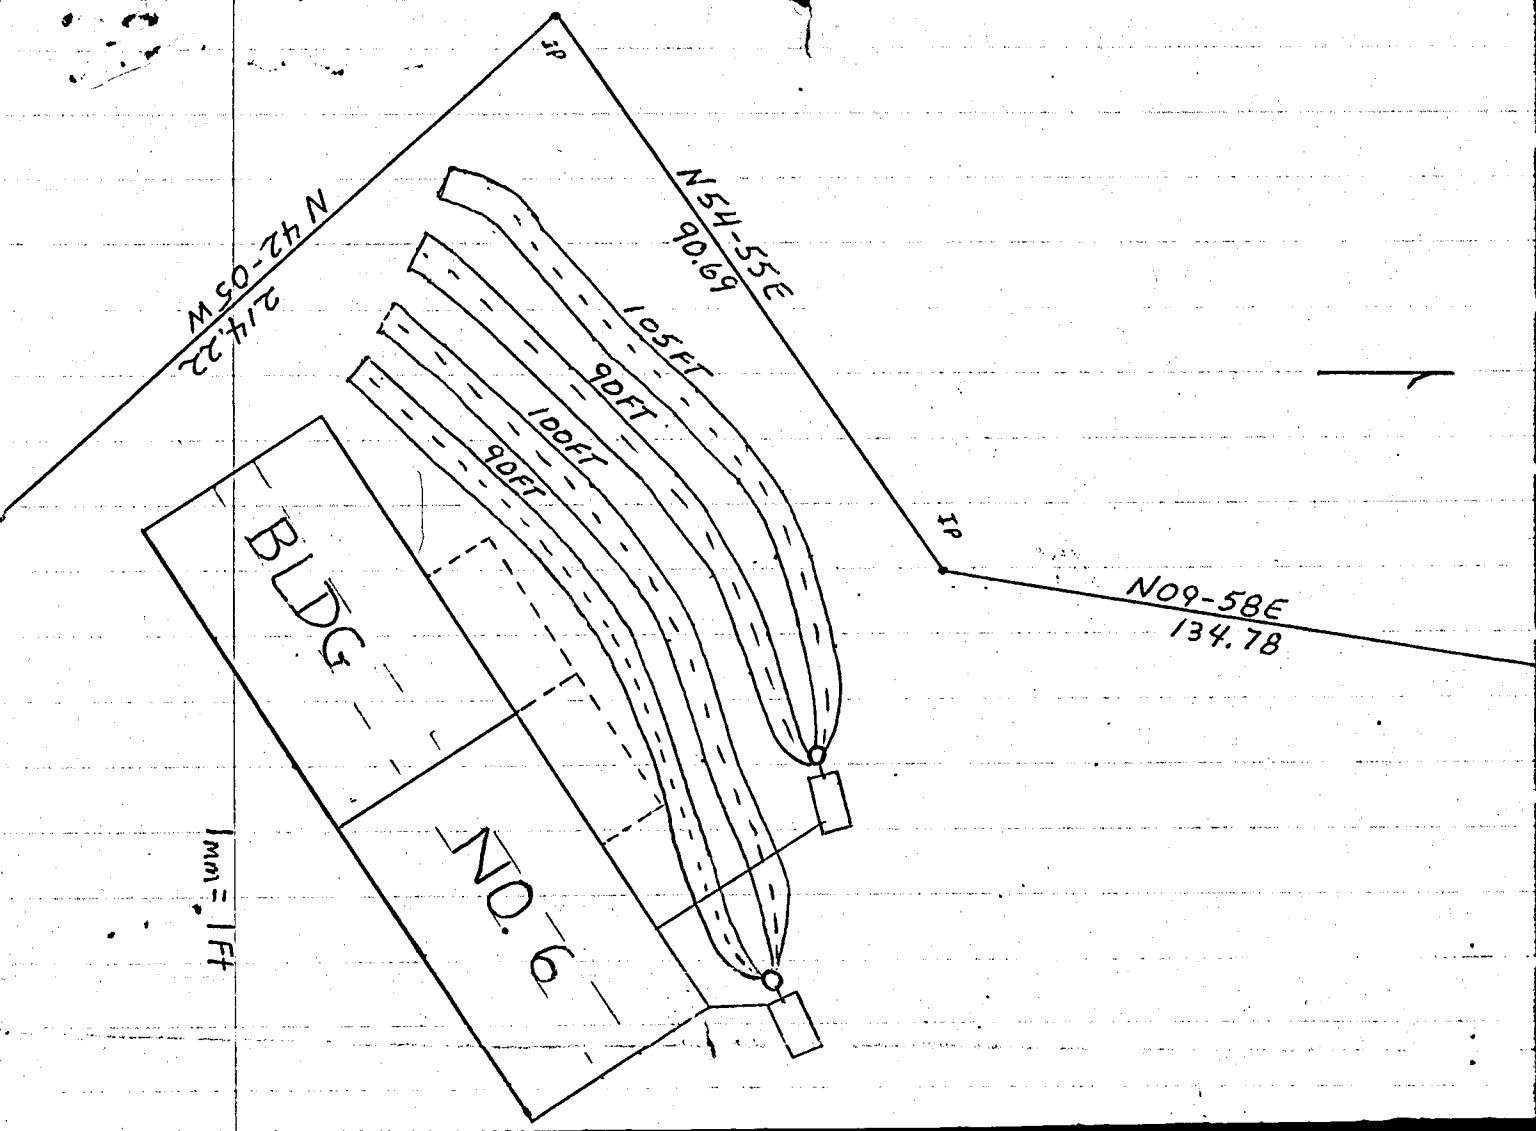

N 42-24 N  
214.22

N 54-55 E  
90.69

N 09-58 E  
134.78

BLDG

NO. 6

1mm = 1ft

3P

3P

105 FT

90 FT

100 FT

90 FT